


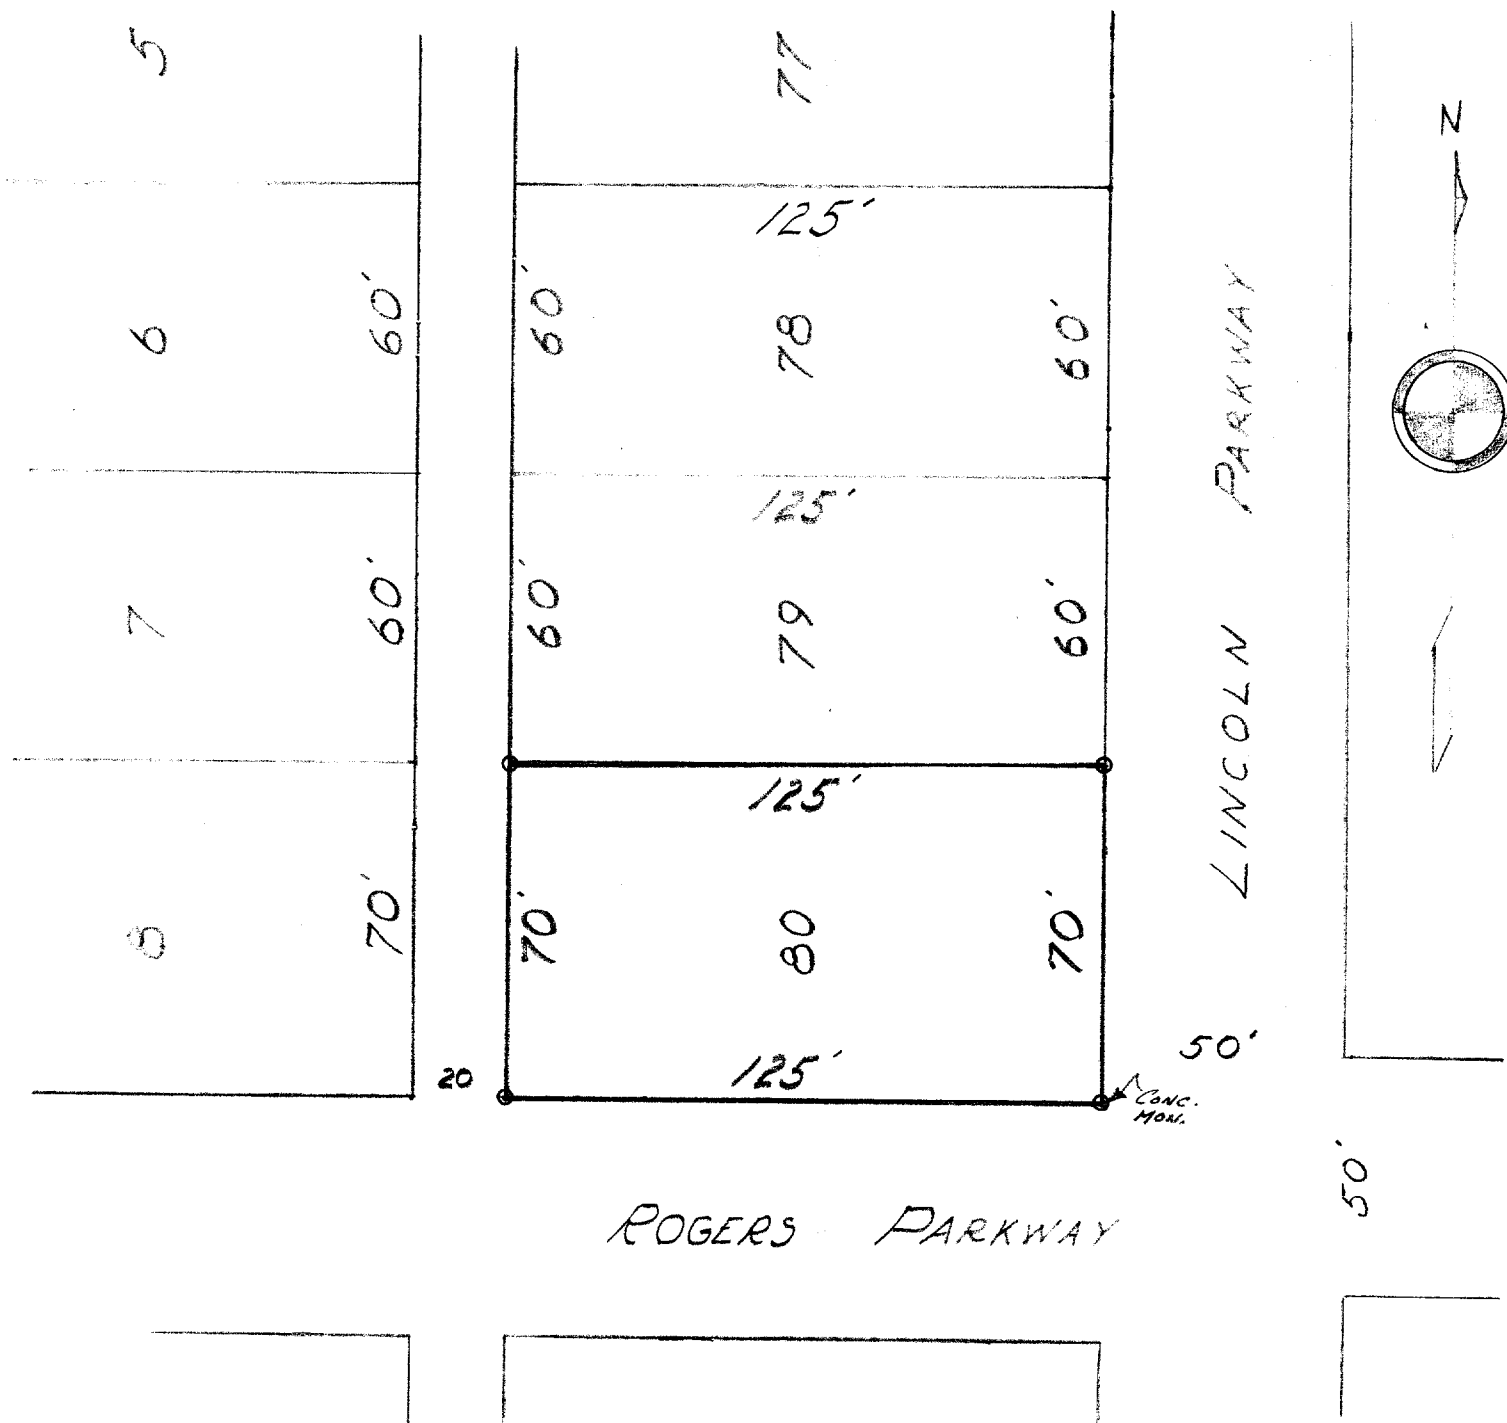

DESCRIPTION:

Lot 80, Cedar Point Park Subdivision of a portion of the Village of Williams Bay, Walworth County, Wisconsin.

CERTIFICATE:

I, hereby certify that I, have on this the 28th day of May, 1954, surveyed the above described property, according to the official records on file in office of the Recorder of Deeds in and for Walworth County, Wisconsin and find that the measurements and bearings of the boundary lines of said property as taken at the site on this day substantially agree with those in said official record and that no encroachments exist.

SIGNED AND SEALED THIS 4TH DAY OF JUNE 1954.

Joseph M. Biagi
Joseph M. Biagi. Professional Engineer.
Elkhorn Wisconsin.