


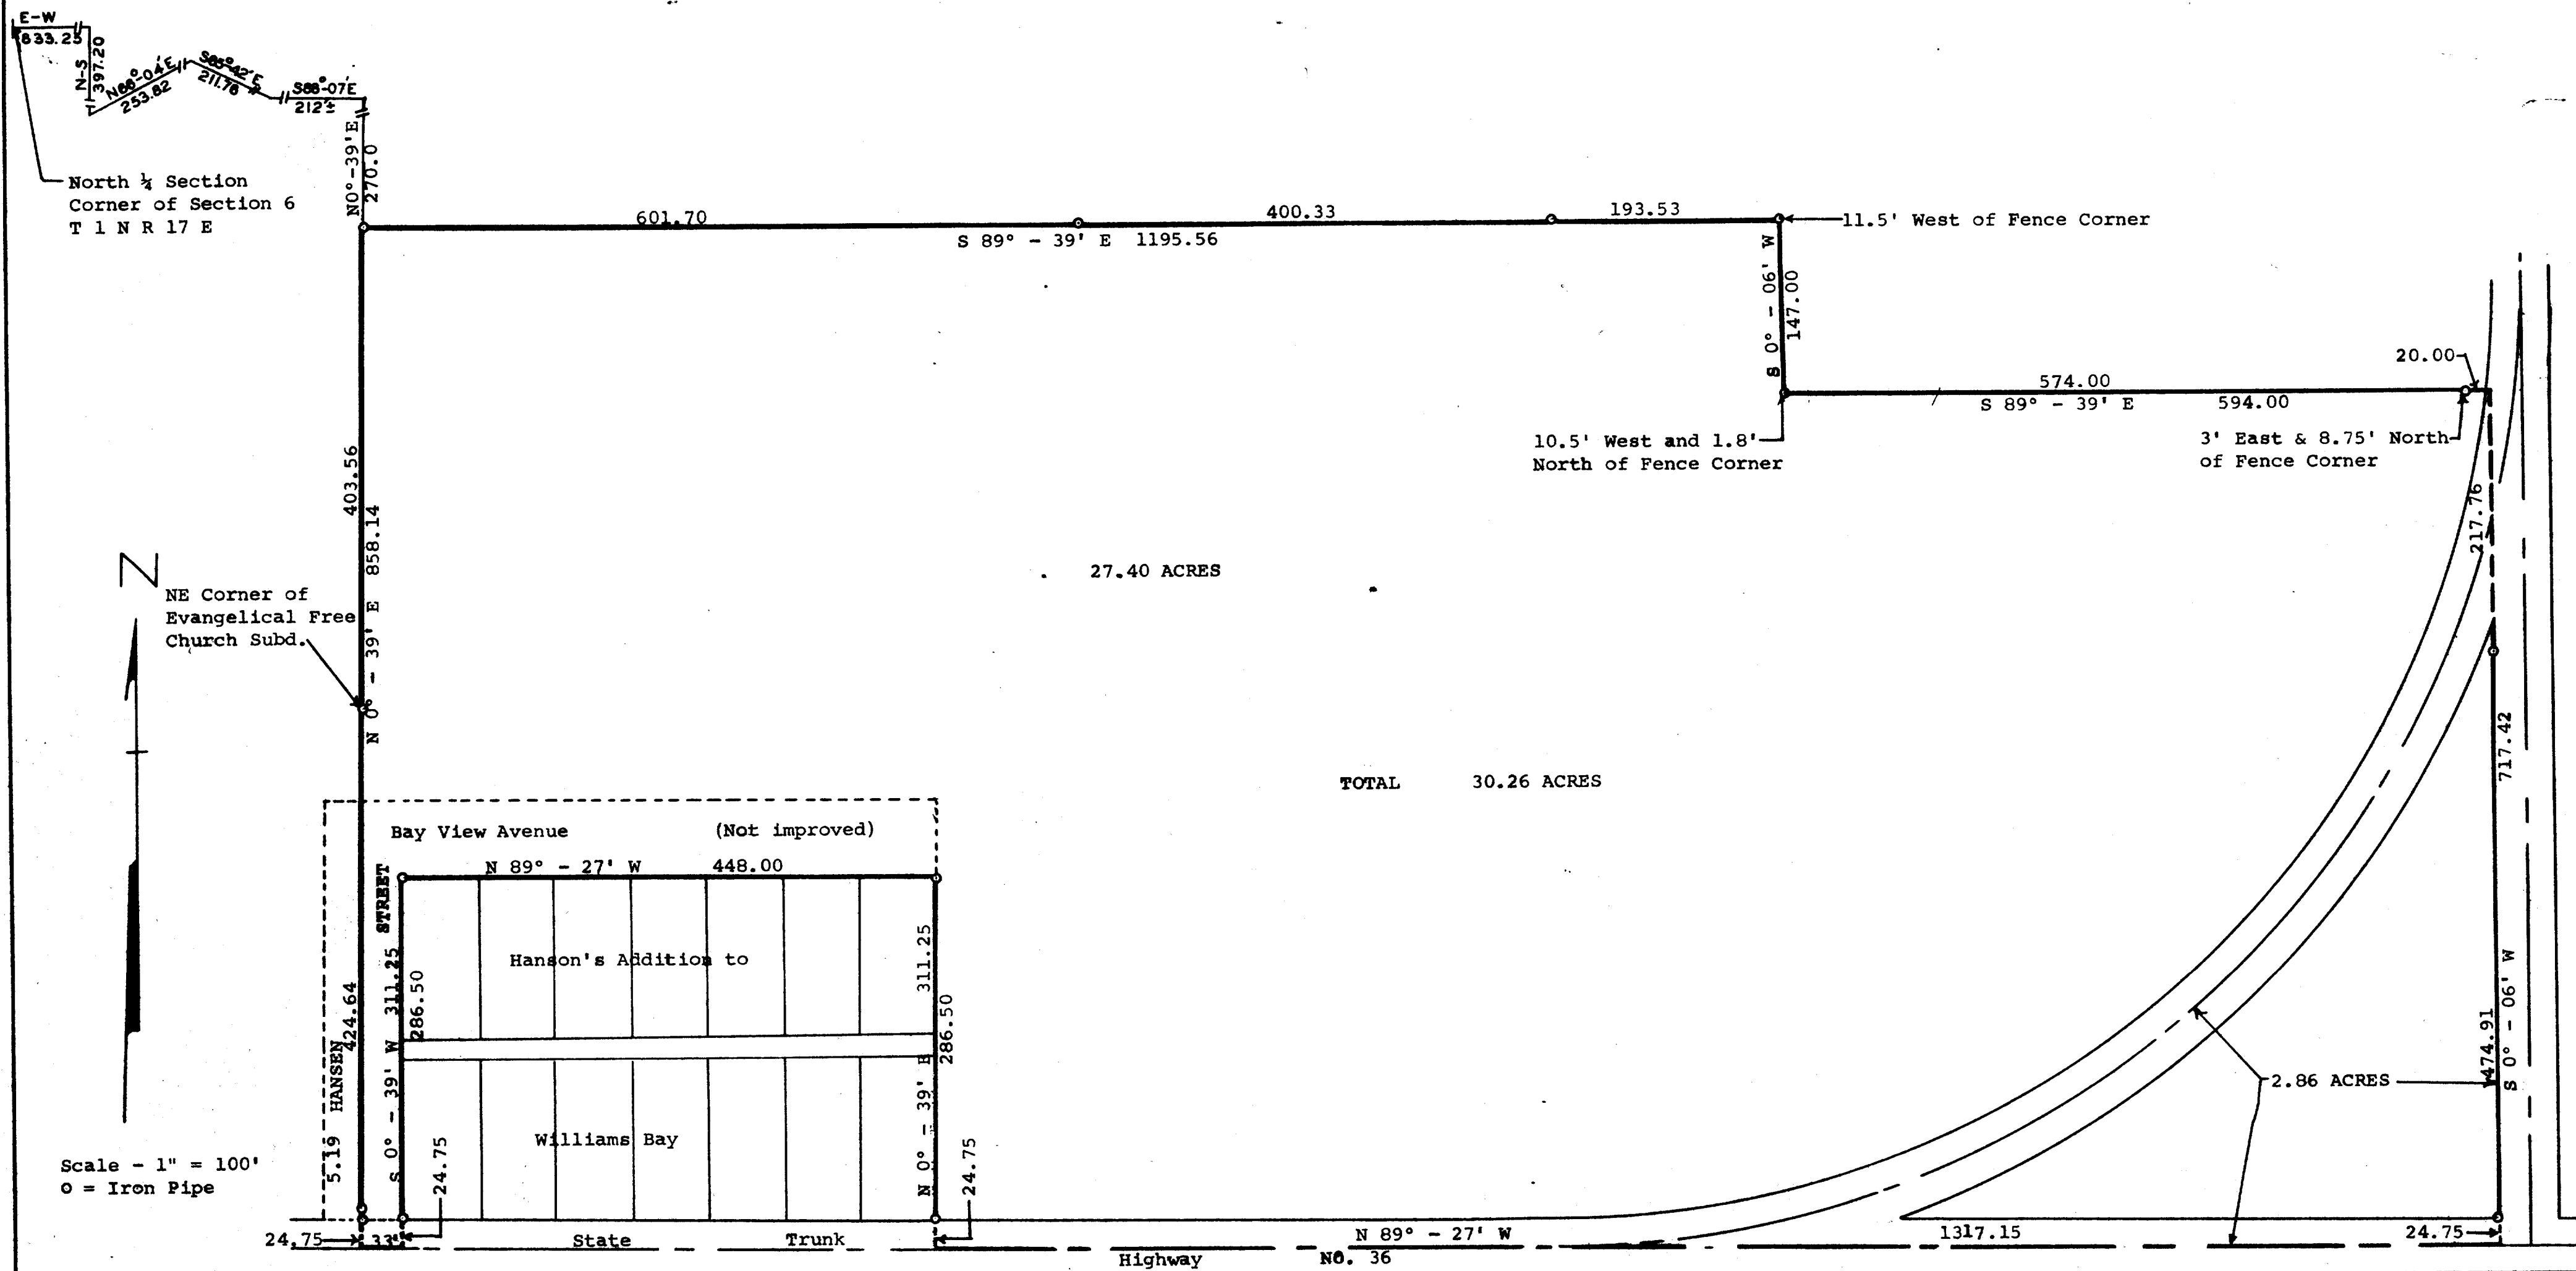

Plat of survey of a parcel of land located in Sections 5 and 6, T1N R17 E,
Village of Williams Bay and Town of Linn, Walworth County, Wisconsin.
October 1962

George T. Dunham
George T. Dunham, Surveyor

WWUPA 87A
WOW * MISS
WHA * MISC

Misc cards - Hanson's Add + Williams Bay (orig parcel)