


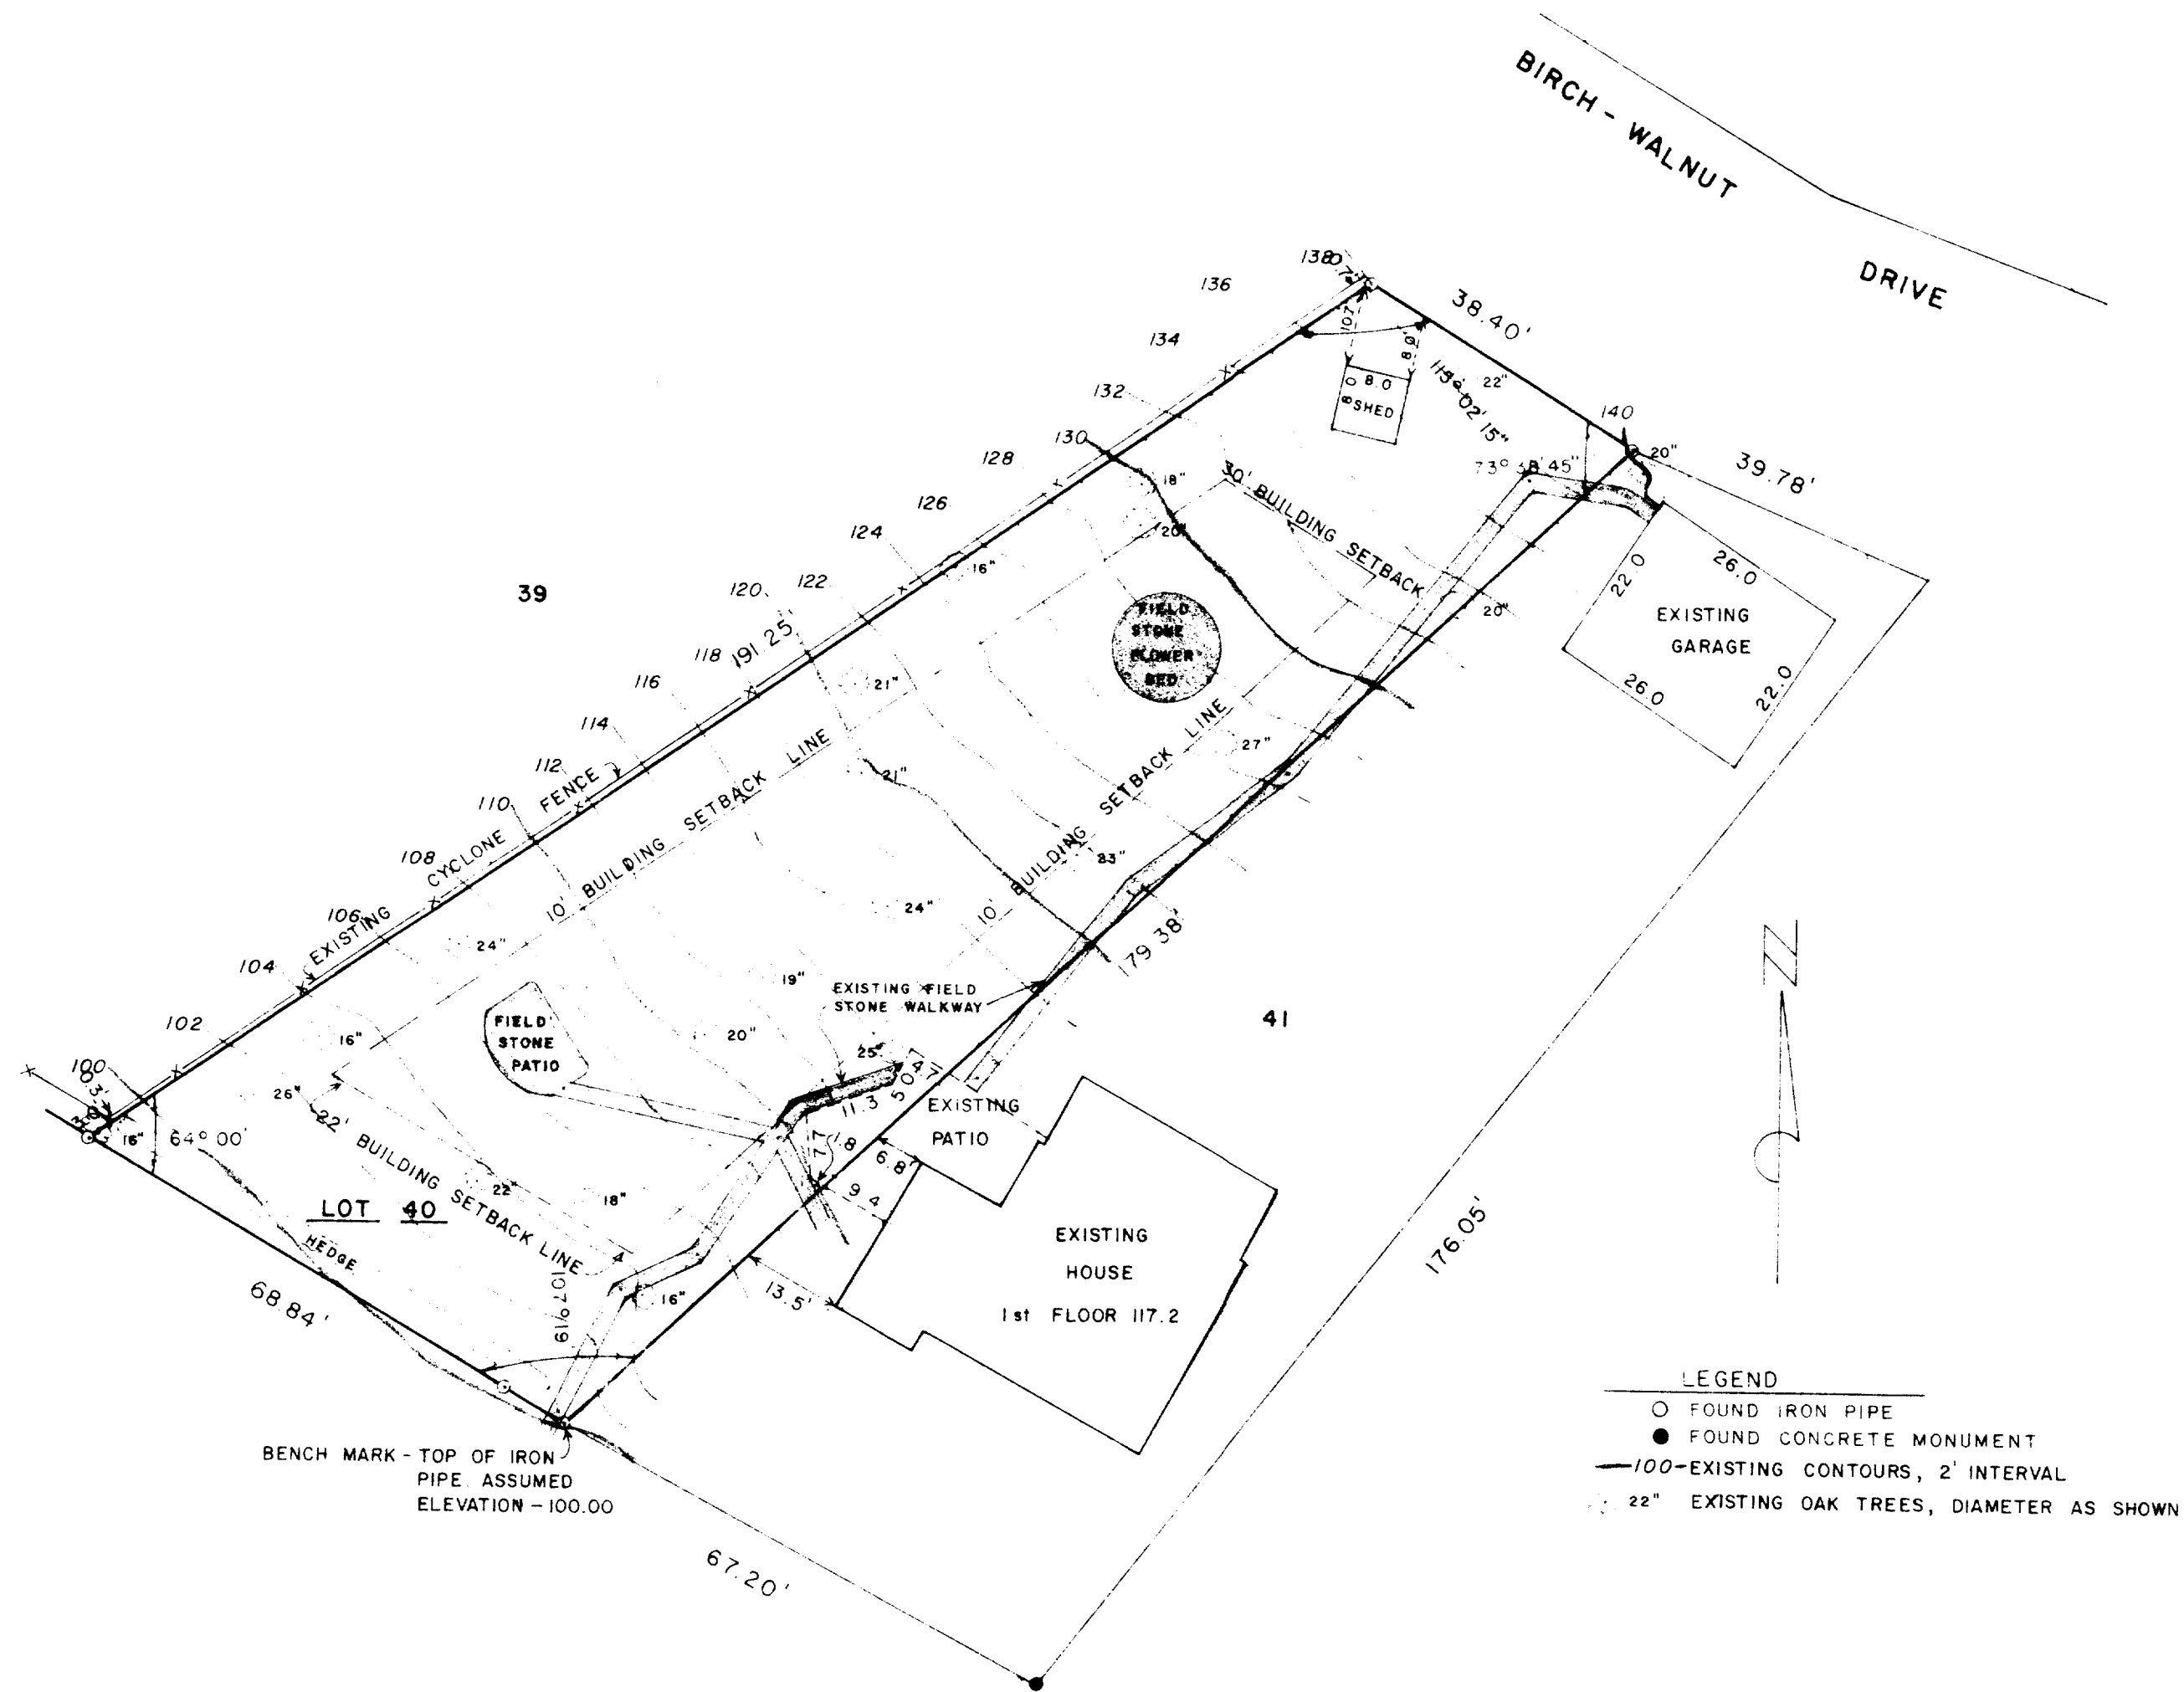

PLAT OF SURVEY AND TOPOGRAPHIC MAP FOR RALPH EDGAR OF LOT 40 OF THE FIRST ADDITION TO CEDAR POINT PARK, VILLAGE OF WILLIAMS BAY, WALWORTH COUNTY, WISCONSIN.		
DATE 4-11-79	ROBERS & BOYD, INC. CONSULTING ENGINEERS 109 S. SPRING ST. BURLINGTON, WIS. (414) 763-2652	JOB NO. 79045
SCALE 1" = 20'		CHECKED
DRAWN GJA		SHEET
REVISED		OF