


DUNHAM SURVEYING, S.C.
SURVEYING & SUBDIVISION
DELAVER, WISCONSIN 53115

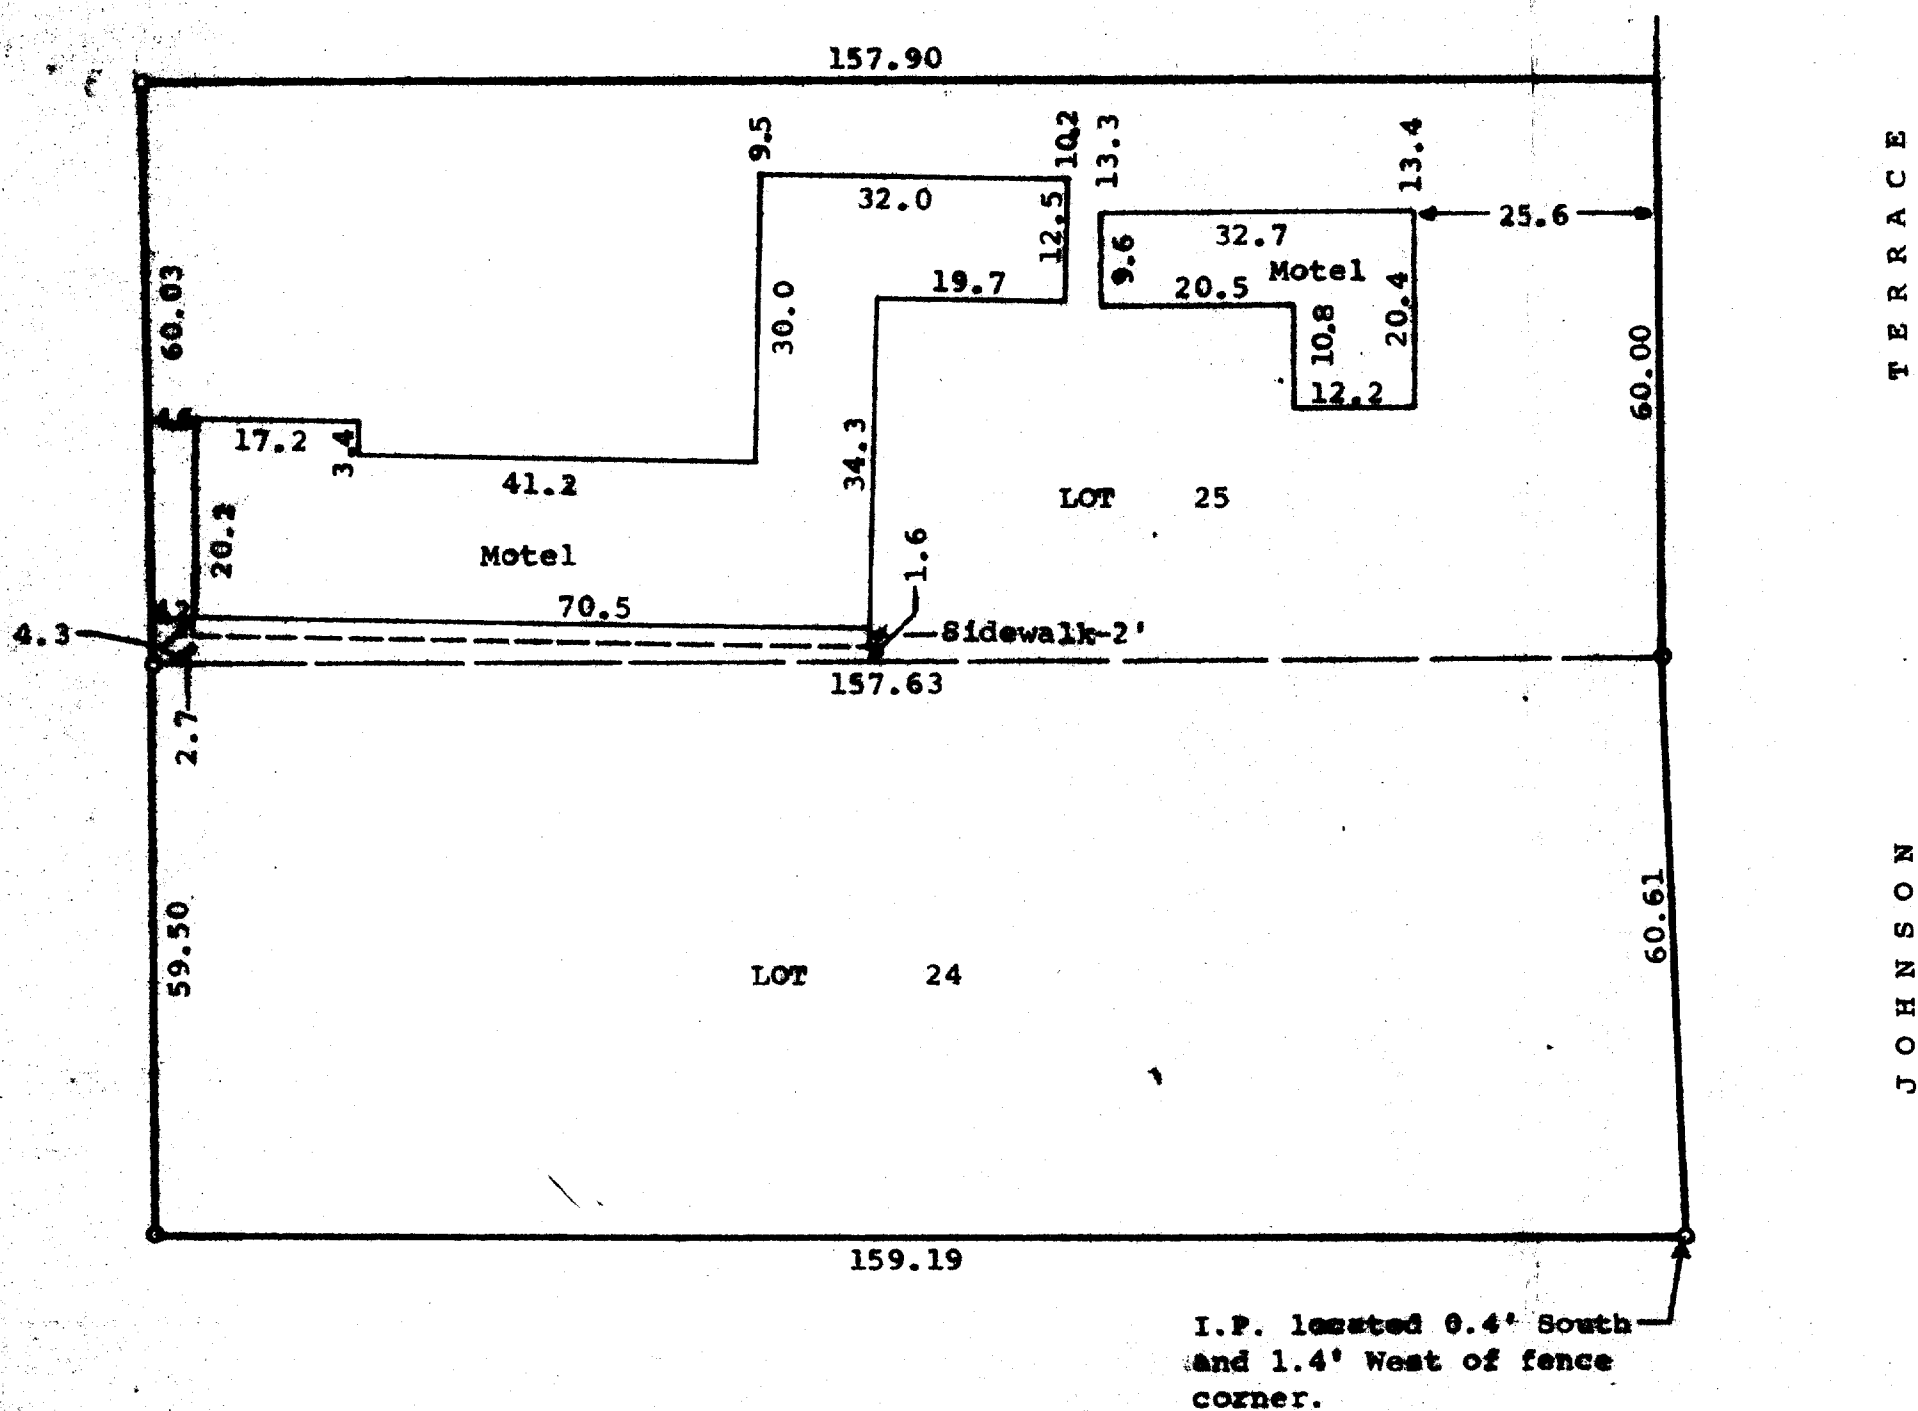

Scale - 1" = 20'
O = Iron Pipe Found

Plat showing the location of the buildings on Lots 24 and 25, Block 1 of Harbor View Subdivision, located in the Village of Williams Bay, Walworth County, Wisconsin.
February 9, 1981

George T. Dunham
George T. Dunham, Surveyor

