


**HAROLD H. KOLB**

REGISTERED PROFESSIONAL LAND SURVEYOR  
LAKE GENEVA, WISCONSIN

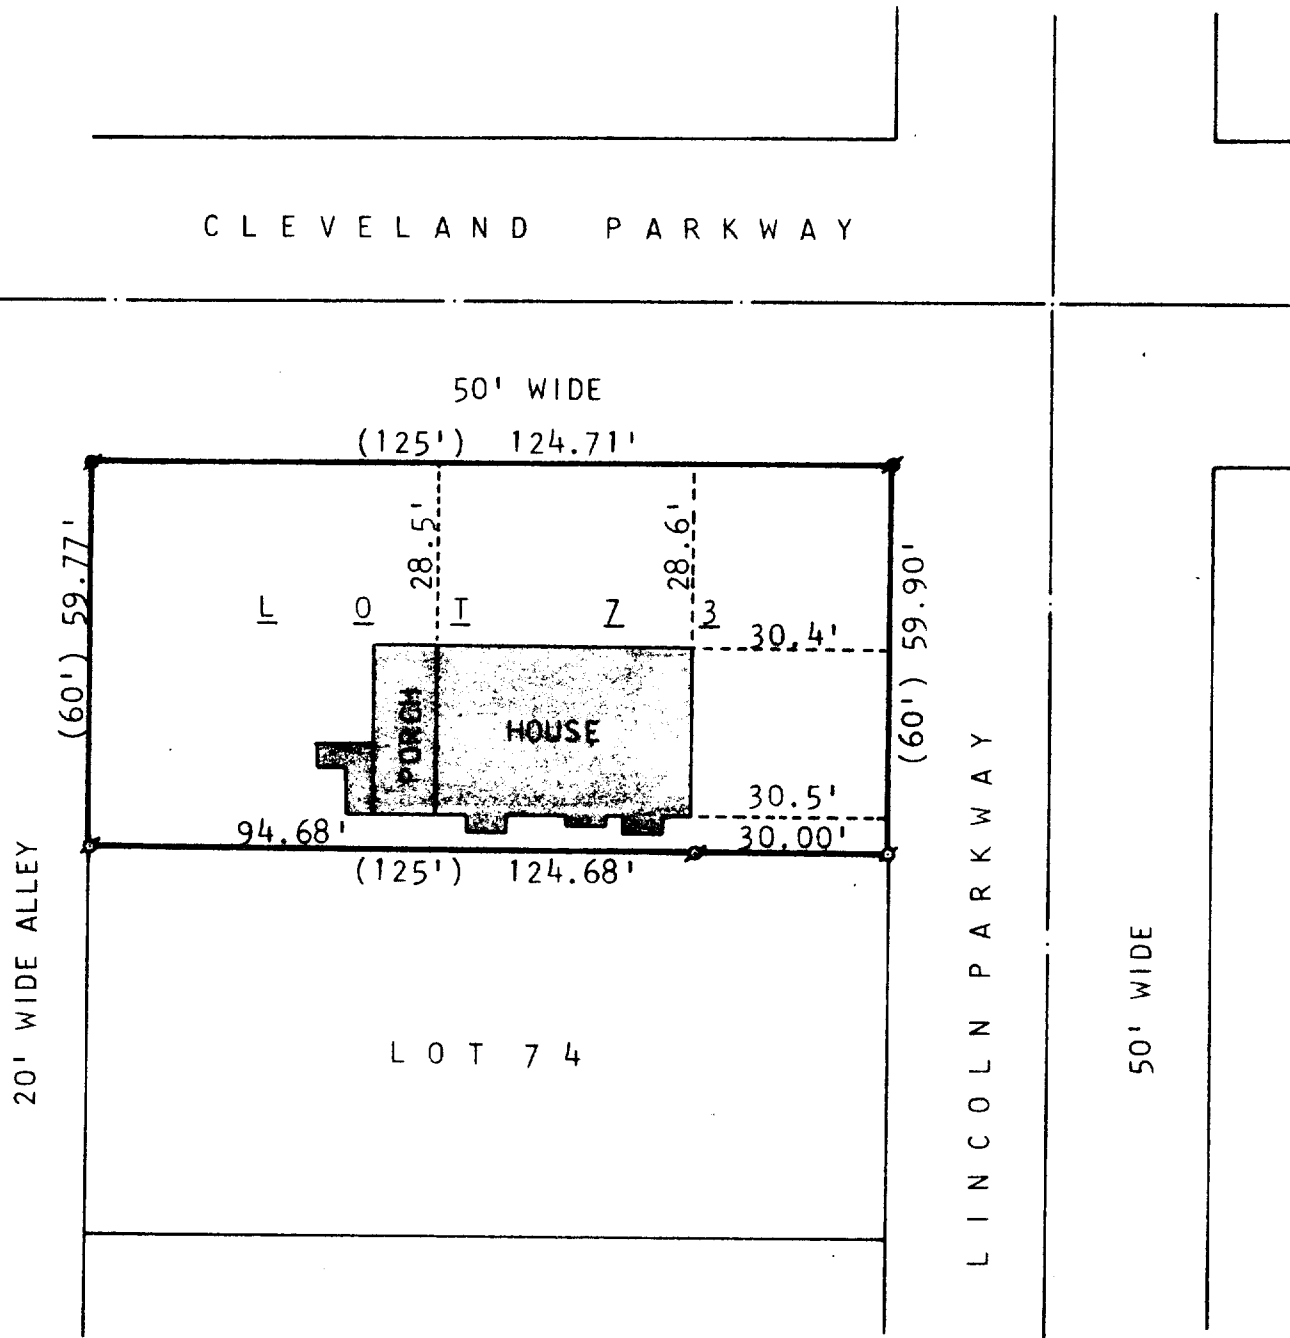

PLAT OF SURVEY OF

LOT 73 OF THE ORIGINAL PLAT OF CEDAR POINT PARK,  
A SUBDIVISION LOCATED IN THE VILLAGE OF WILLIAMS  
BAY, WALWORTH COUNTY, WISCONSIN.

ORDERED BY: HUTTON REALTY  
60 W. GENEVA STREET  
WILLIAMS BAY, WIS.



SCALE: 1"=30'

**LEGEND**

- O — IRON PIPE PLACED, 1" x 24" 1.13 LB./LIN. FT.
- — CONCRETE MONUMENT, 5" DIA. x 30" FOUND
- σ — IRON PIPE FOUND ( ) — AS PLATTED

*Harold H. Kolb*  
HAROLD H. KOLB  
WISCONSIN REGISTERED LAND SURVEYOR, S-187  
DATE Oct. 3, 1978