


SURVEYING & SUBDIVIDING
DELAN, WISCONSIN 53115

ROAD

D
 P
 T
 V
 E

POINT

END

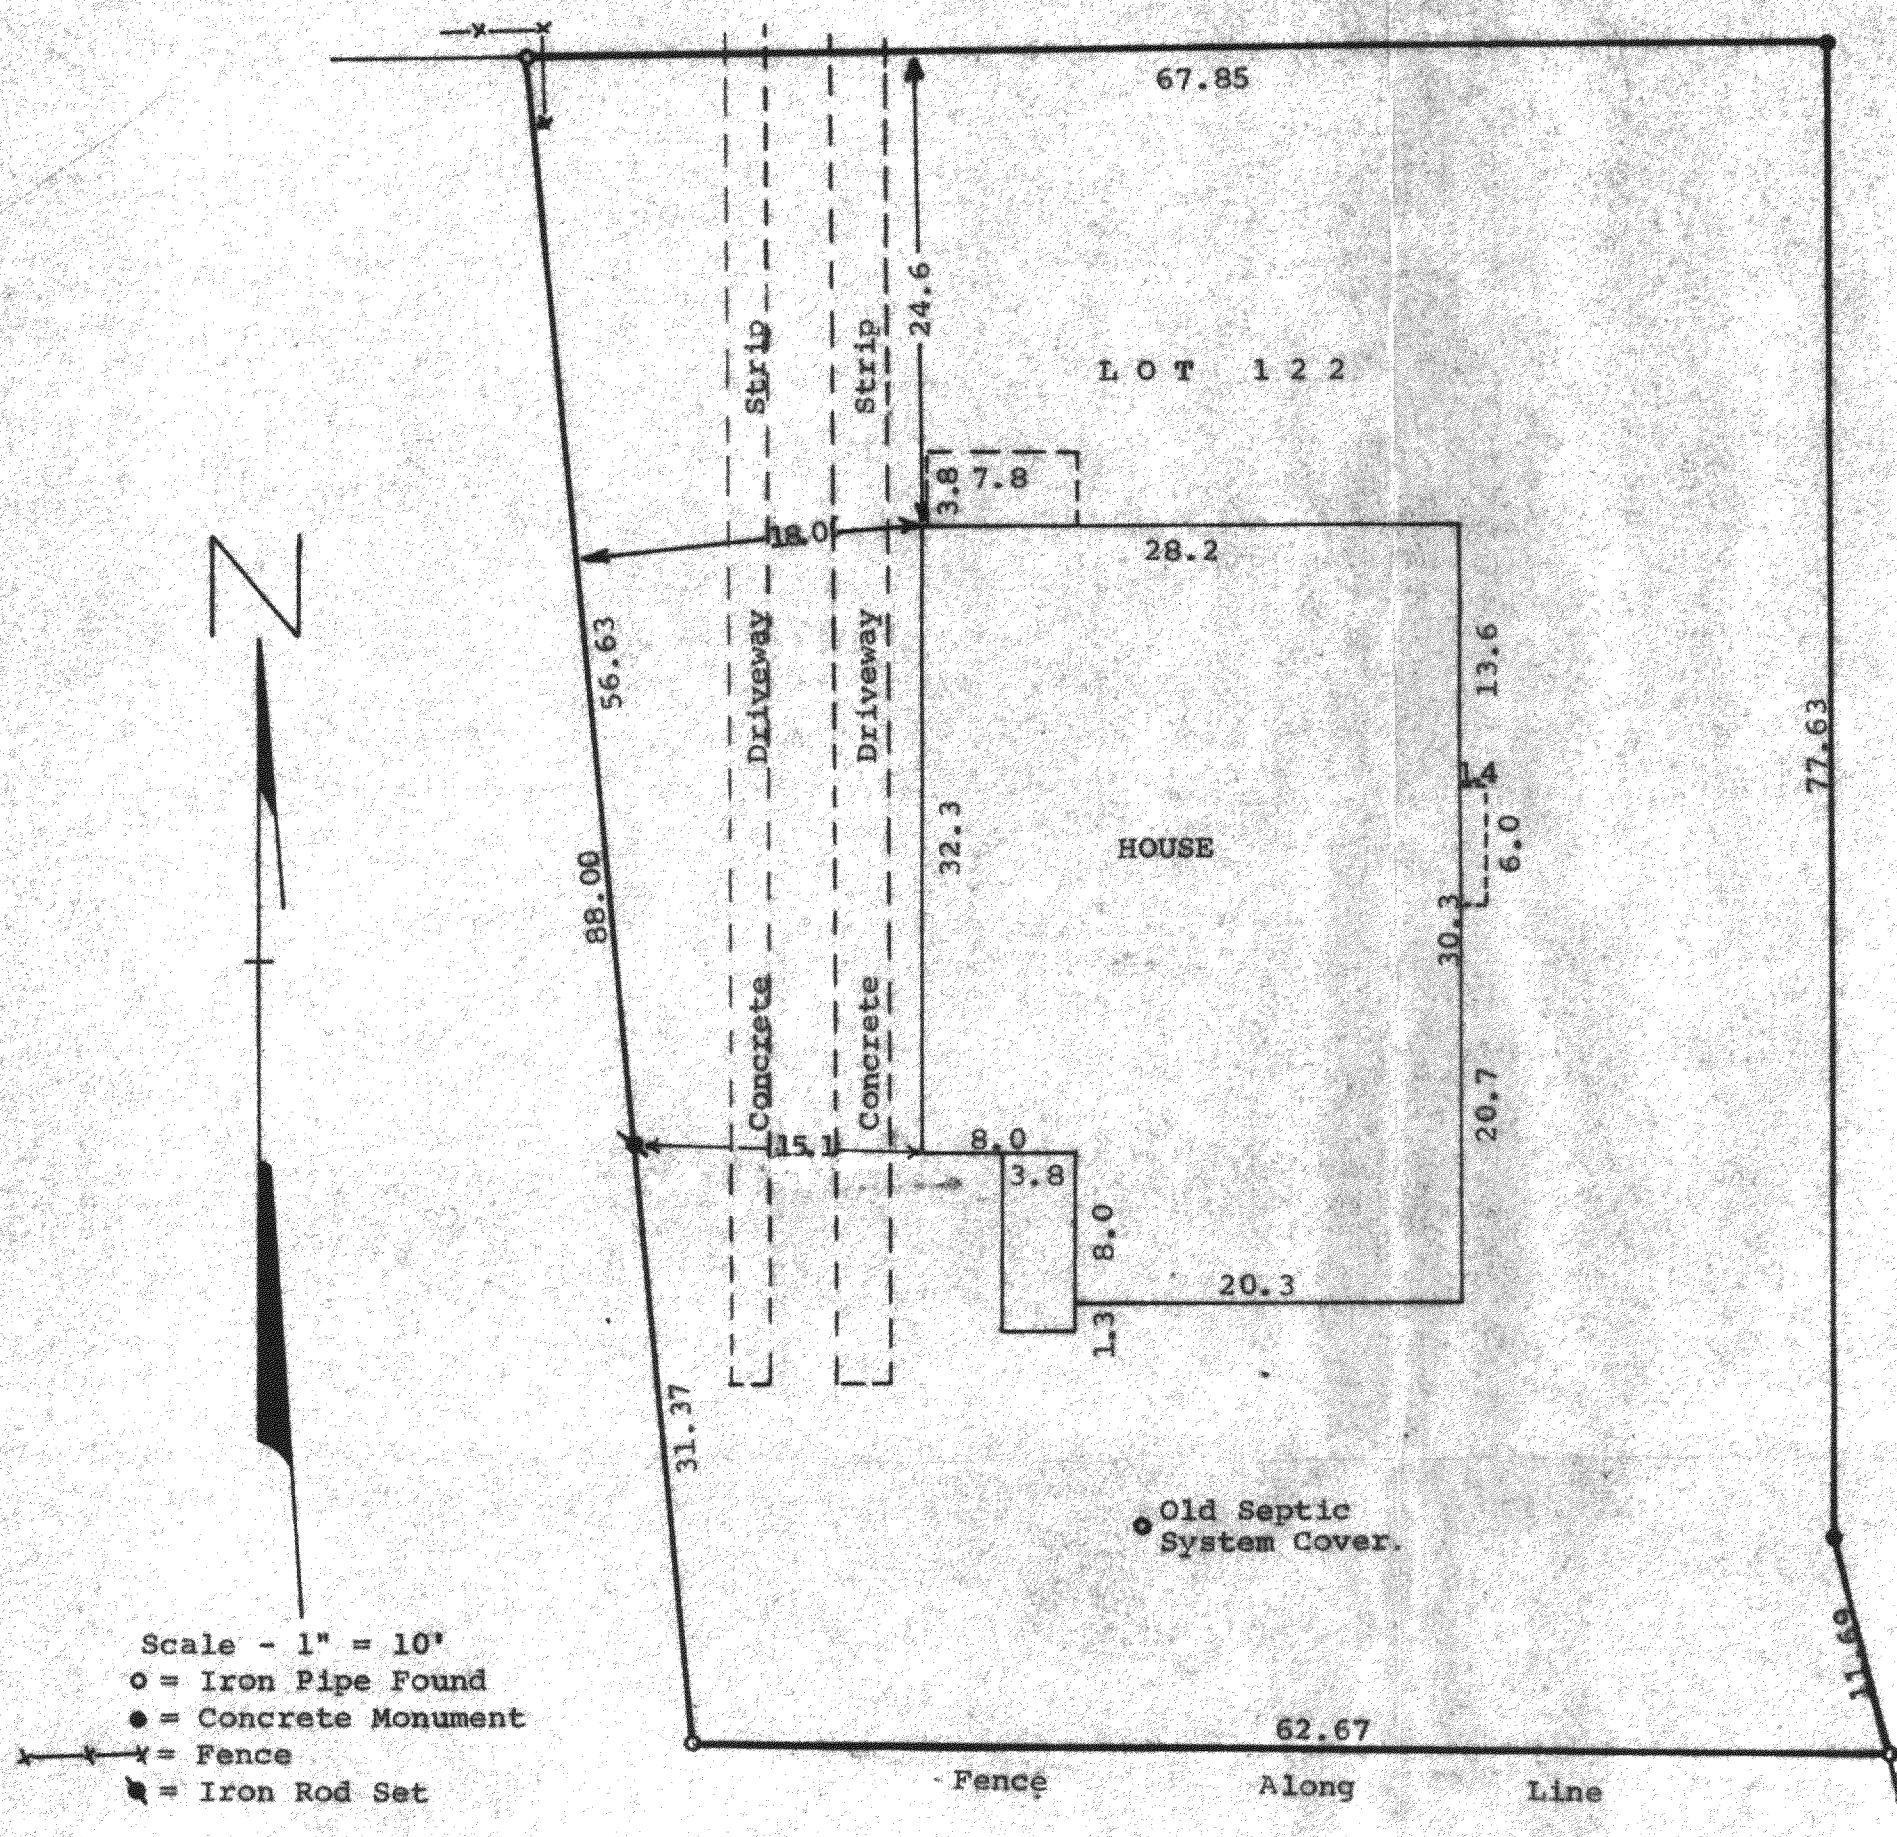

STATE OF WISCONSIN) SS
COUNTY OF WALWORTH)

I, James M. Dunham, Surveyor, certify that I have surveyed the property described as follows:

Lot 122, Second Addition to Cedar Point Park, located in the Village of Williams Bay, Walworth County, Wisconsin, and that the above map is a true representation thereof and shows the size and location of the property, its exterior boundaries, the location of all visible structures and dimensions of all principal buildings thereon, boundary fences, apparent easements, roadways and visible encroachments, if any.

This survey is made for the use of the present owners of the property, and also those who purchase, mortgage, or guarantee the title thereto within one (1) year from date hereof.

September 11, 1979

James M. Dunham
James M. Dunham, Surveyor

