


**SURVIVOR & MISSING
DELAN, WISCONSIN 53115**

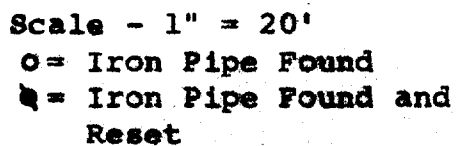

I, George T. Dunham, Surveyor, certify that I have surveyed the property described as follows,
Lot 2 in the First Addition to Cedar Point Park, located in the Village of Williams Bay, County of Walworth, Wisconsin, and that the above map is a true representation thereof and shows the size and location of the property, its exterior boundaries, the location of all visible structures and dimensions of all principal buildings thereon, boundary fences, apparent easements, roadways and visible encroachments, if any.
This survey is made for the use of the present owners of the property, and also those who purchase, mortgage, or guarantee the title thereto within one (1) year from date hereof.
September 21, 1979

A circular seal for a Wisconsin Land Surveyor. The outer ring contains the text "WISCONSIN" at the top and "LAND SURVEYOR" at the bottom, separated by two five-pointed stars. In the center, the name "GEORGE T. DUNHAM" is printed in a larger font, with "DELAVAN, WIS." printed below it in a smaller font.