


WILMETTE

ROAD

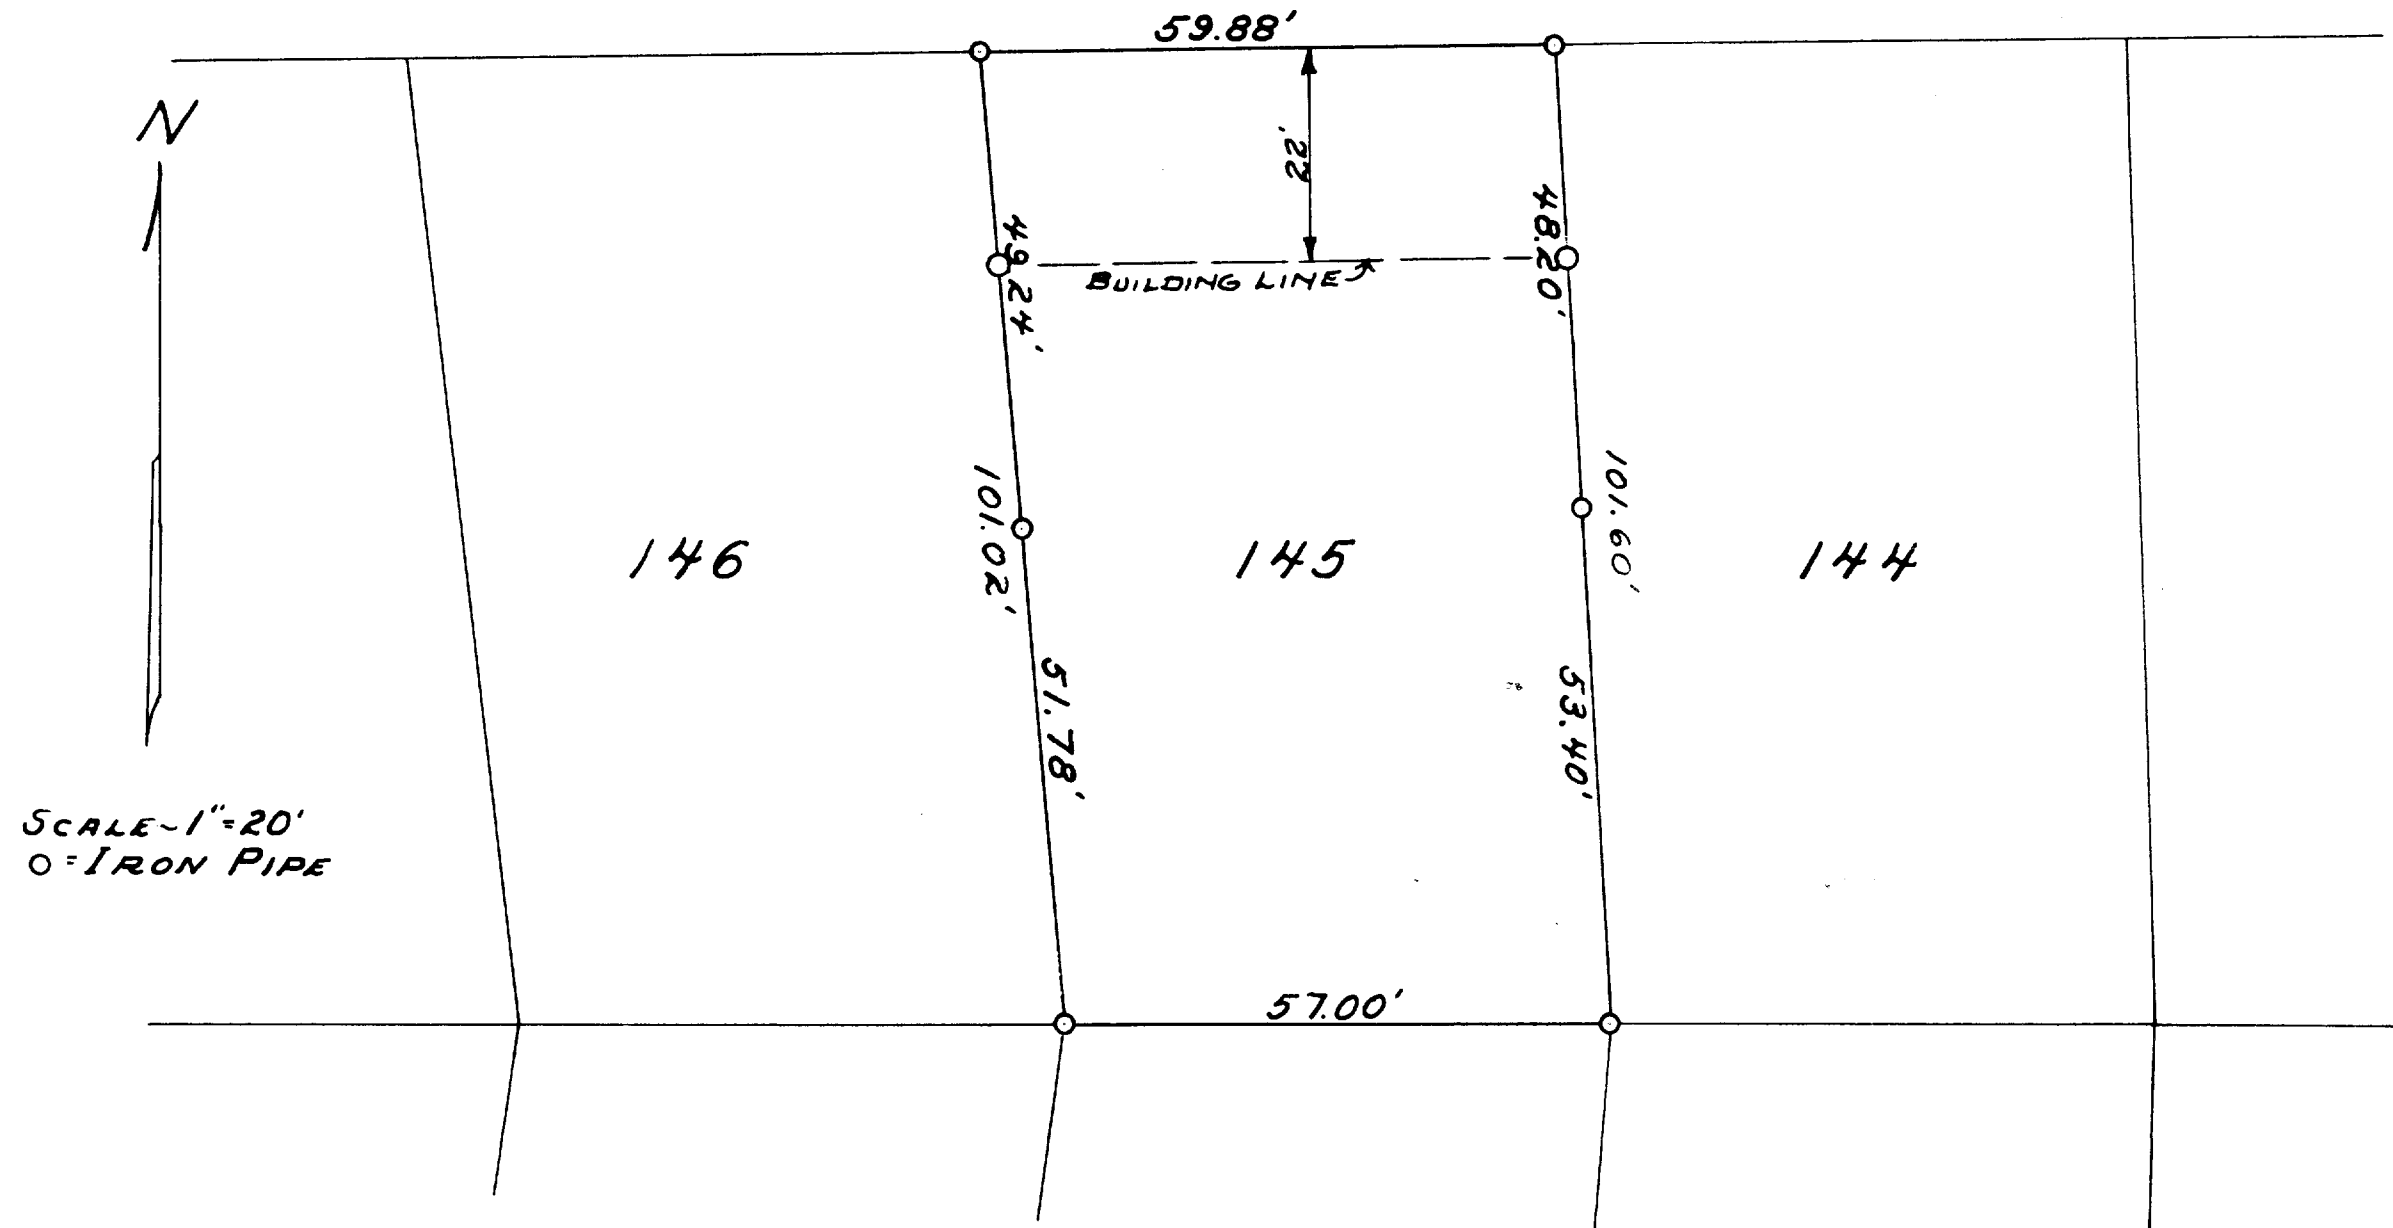

PLAT OF SURVEY OF LOT 145 OF THE 2ND
ADDITION TO CEDAR POINT PARK LOCATED IN
THE VILLAGE OF WILLIAMS BAY, WALWORTH
COUNTY, WISCONSIN.
SEPT. 1948

Lloyd L. Jensen
SURVEYOR

11-40