


DUNHAM SURVEYING, S. C.
SURVEYING & SUBDIVIDING
DELAVER, WISCONSIN 53115

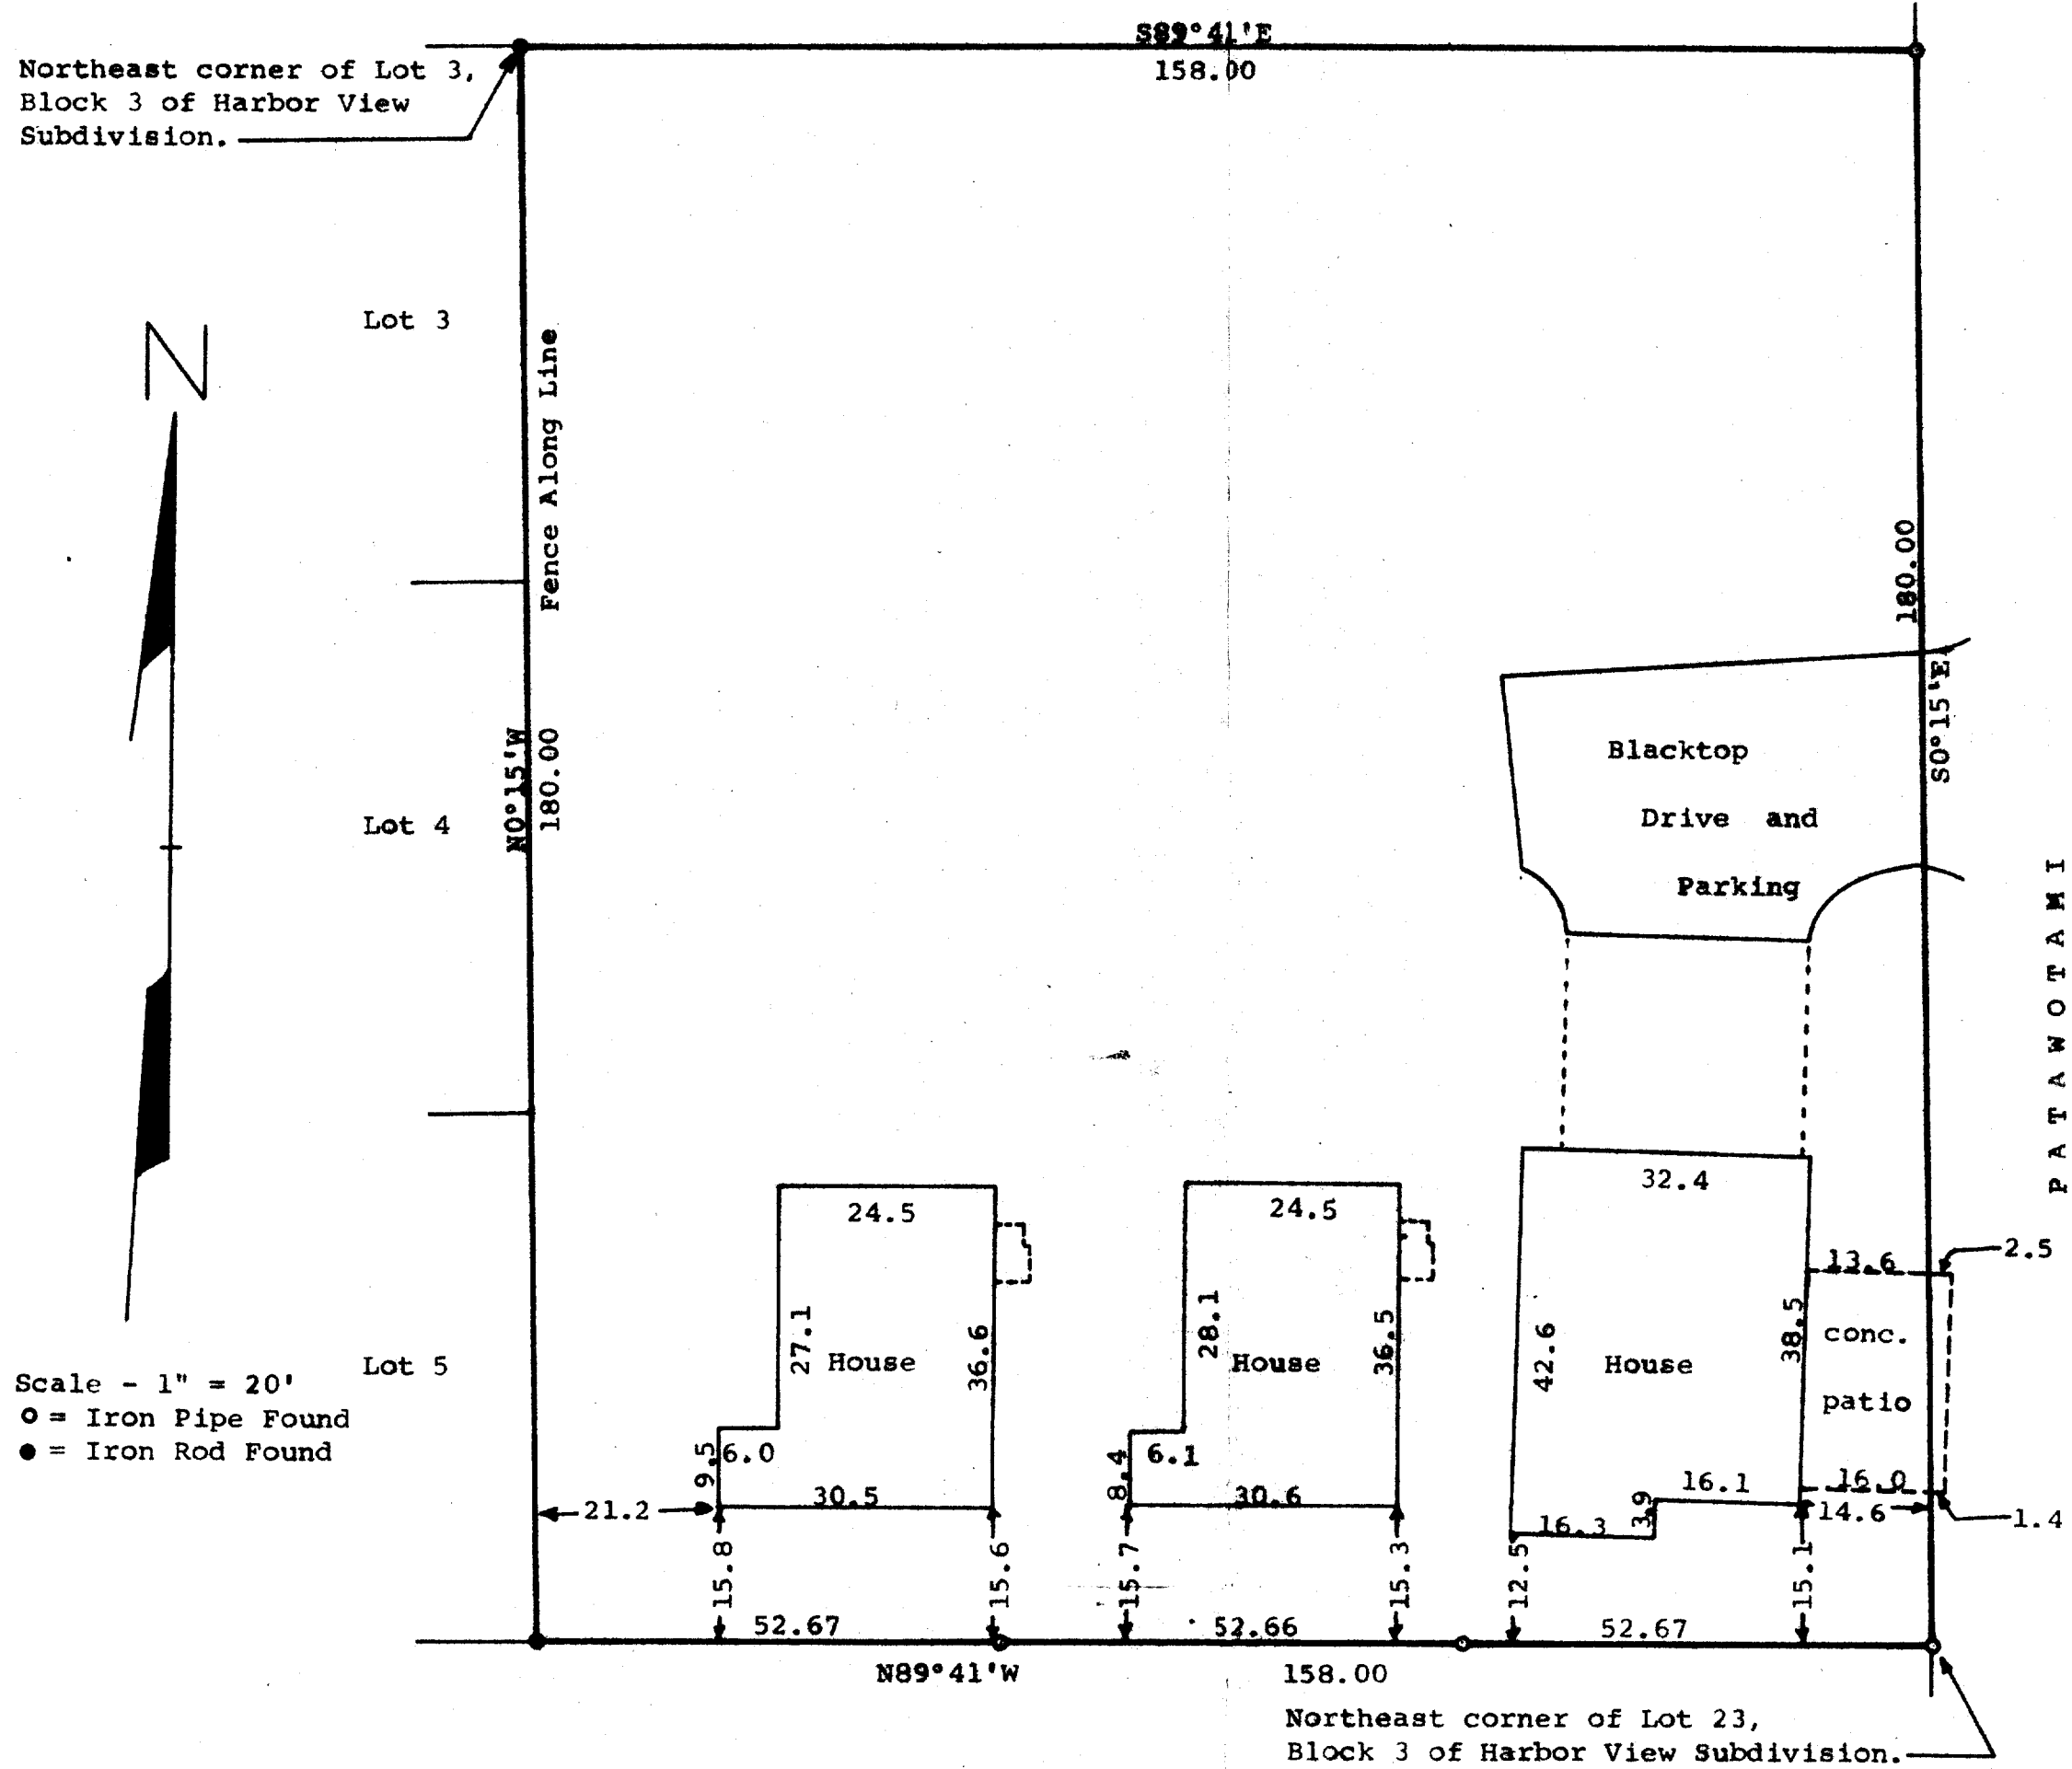

STATE OF WISCONSIN)
COUNTY OF WALWORTH) SS

I, George T. Dunham, Surveyor, certify that I have surveyed the property described as follows,

A parcel of land located in the Northeast 1/4 of Section 6, T1N, R17E, Village of Williams Bay, Walworth County, Wisconsin, described as follows: Beginning at the Northeast corner of Lot 3, Block 3 of Harbor View Subdivision in said Village; thence S89°41'E along the Easterly extension of the North line of said Lot 3, 158.00 feet to the West line of Potawatomi Road; thence S0°15'E, along said West line 180.00 feet to the Northeast corner of Lot 23, Block 3 of Harbor View Subdivision; thence N89°41'W along the North line of said Lot 23, 158.00 feet to the Northeast corner thereof; thence N0°15'W along the East line of Lots 3, 4, 5 in said Block, 180.00 feet to the place of beginning. (Said parcel of land formerly known as Lots 24, 25, and 26 in Block 3 of Harbor View Subdivision)

and that the above map is a true representation thereof and shows the size and location of the property, its exterior boundaries, the location of all visible structures and dimensions of all principal buildings thereon, boundary fences, apparent easements, roadways and visible encroachments, if any.

This survey is made for the use of the present owners of the property, and also those who purchase, mortgage, or guarantee the title thereto within one (1) year from date hereof.

October 24, 1979

George T. Dunham
George T. Dunham, Surveyor

