


GEORGE T. DUNHAM
SURVEYING & SUBDIVIDING
DELAYAN, WISCONSIN

N

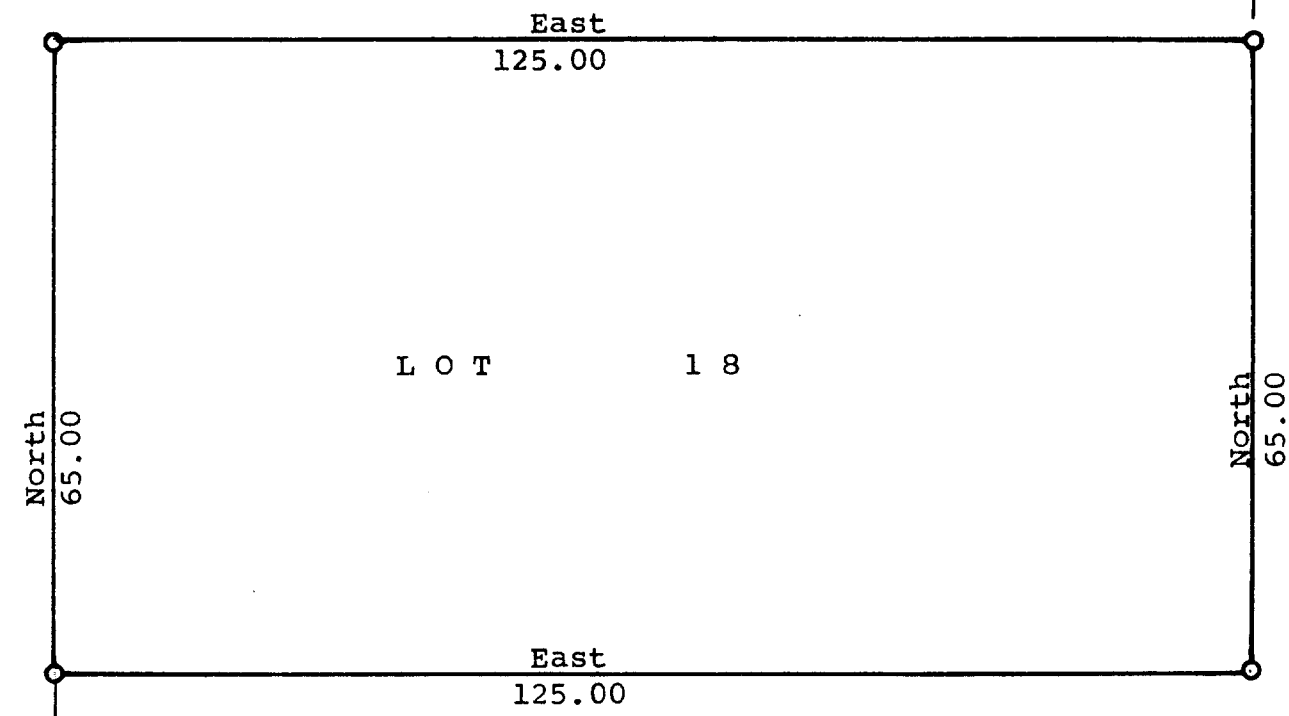

Scale - 1" = 20'
● = Iron Pipe

Plat of survey of Lot 18 located in Evangelical Free
Church Subdivision in the Village of Williams Bay,
Walworth County, Wisconsin
September 7, 1963

George T. Dunham
George T. Dunham, Surveyor

11-42