

FARRIS, HANSEN & COOPER, INC.


ENGINEERING, SURVEYING AND LAND PLANNING
715 W. WALWORTH ST. - P.O. BOX 487 - ELKHORN, WI 53121

PLAT OF SURVEY OF LOT 8 OF LACKEY BROTHERS S. IN THE VILLAGE OF WILLIAMS BAY, WALWORTH CO., WIS.

LEGEND

○ = Iron pipe survey stake found

△ = Metal detector indicates presence of iron object beneath driveway pavement

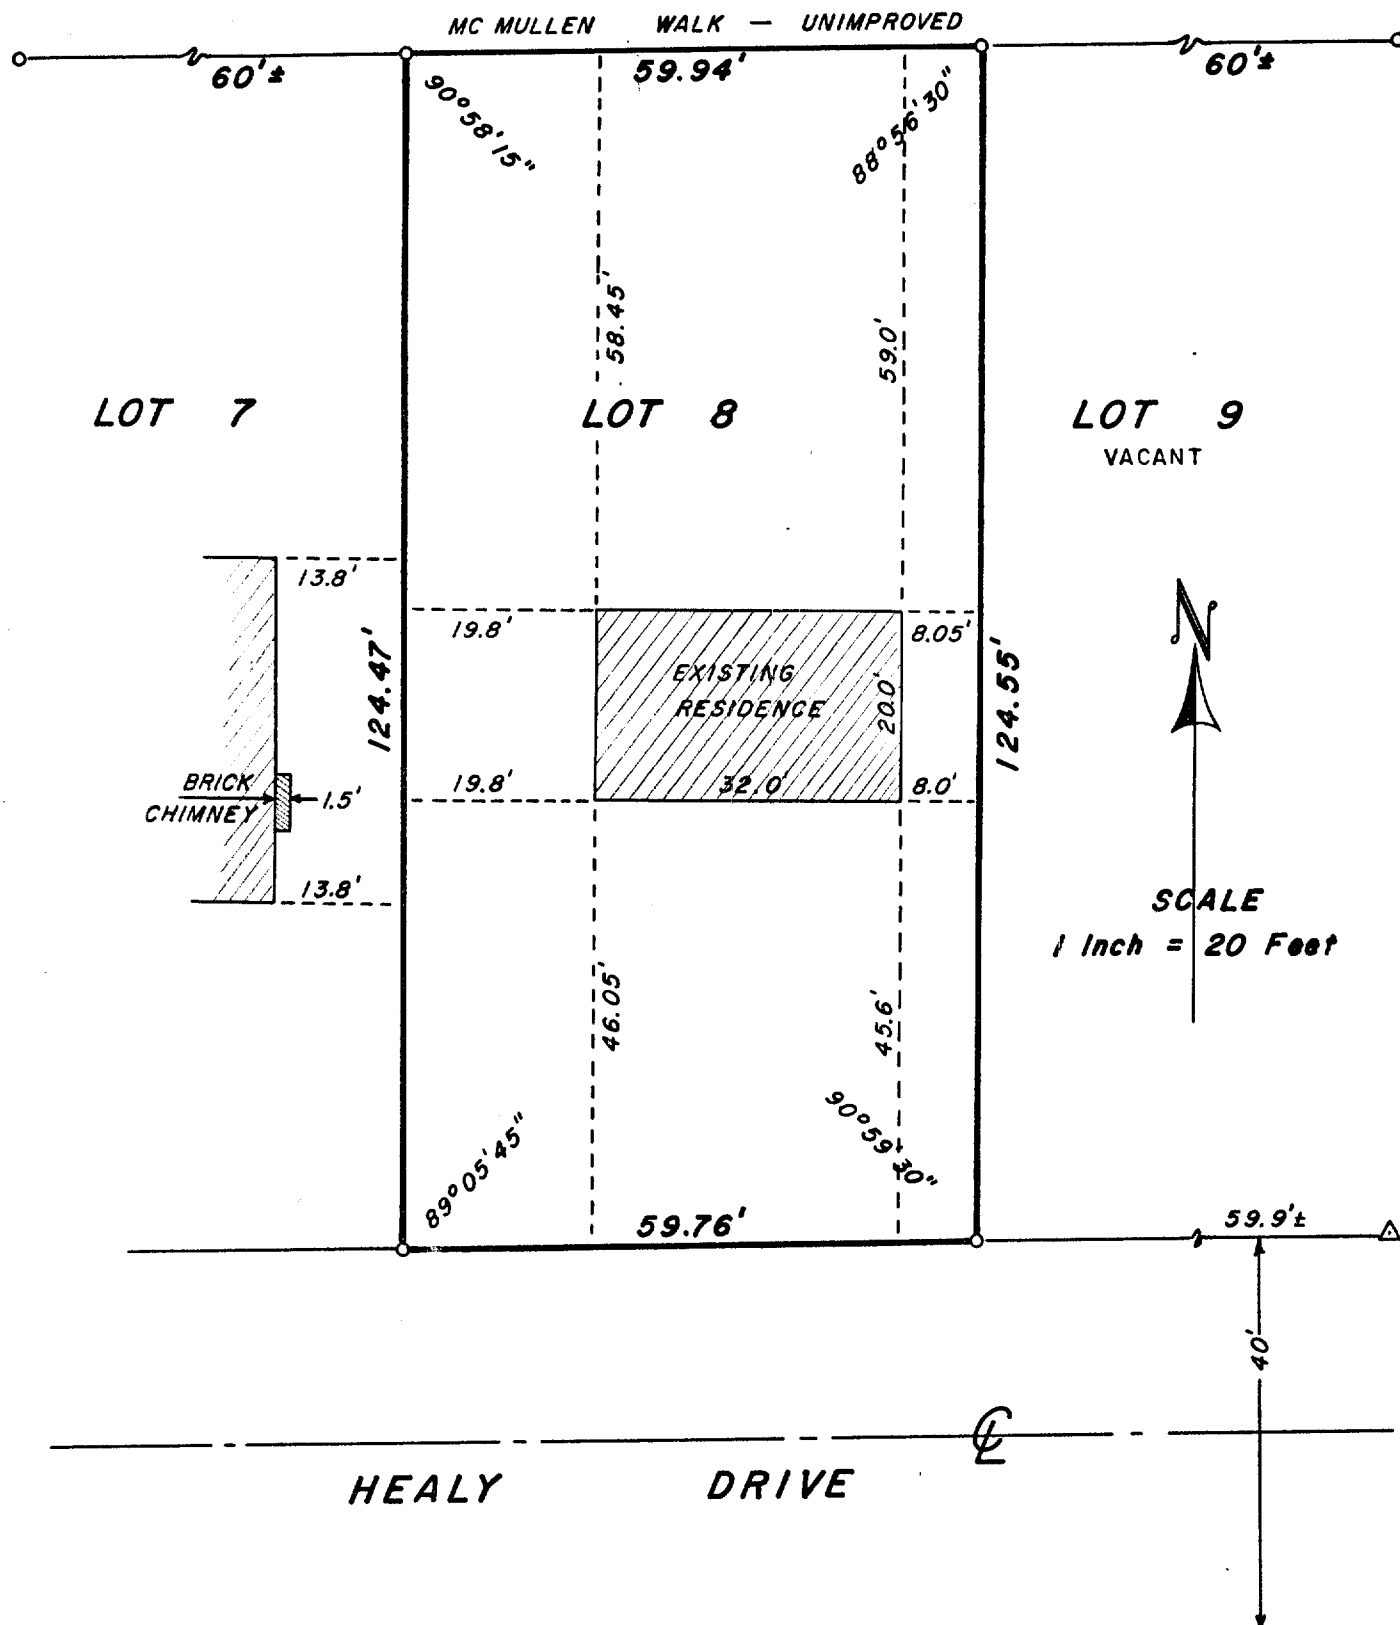


This work ordered by: William R. Frink, Owner

I HEREBY CERTIFY that this plat of survey is an accurate representation of the lot lines and of the buildings shown hereon to the best of my professional knowledge and belief.

Dated this 16th Day of February, 1980

Robert A. Farris
Robert A. Farris, RLS

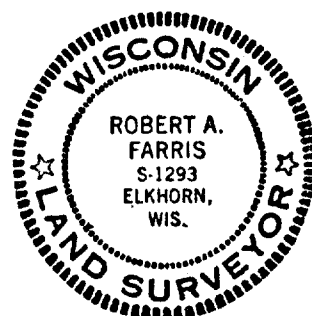

PROJECT NO. 1669