
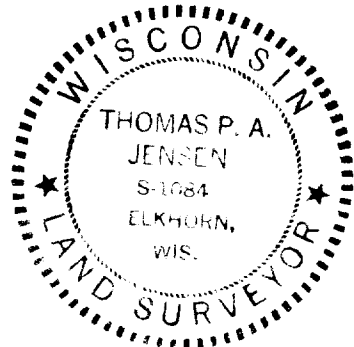


PLAT OF SURVEY OF PART OF THE CONFERENCE POINT PROPERTY LOCATED

IN THE SW 1/4 OF THE SE 1/4 OF SECTION 1
AND
IN THE NW 1/4 OF THE NE 1/4 OF SECTION 12
TOWN 1 NORTH, RANGE 16 EAST
VILLAGE OF WILLIAMS BAY,
WALWORTH COUNTY, WISCONSIN

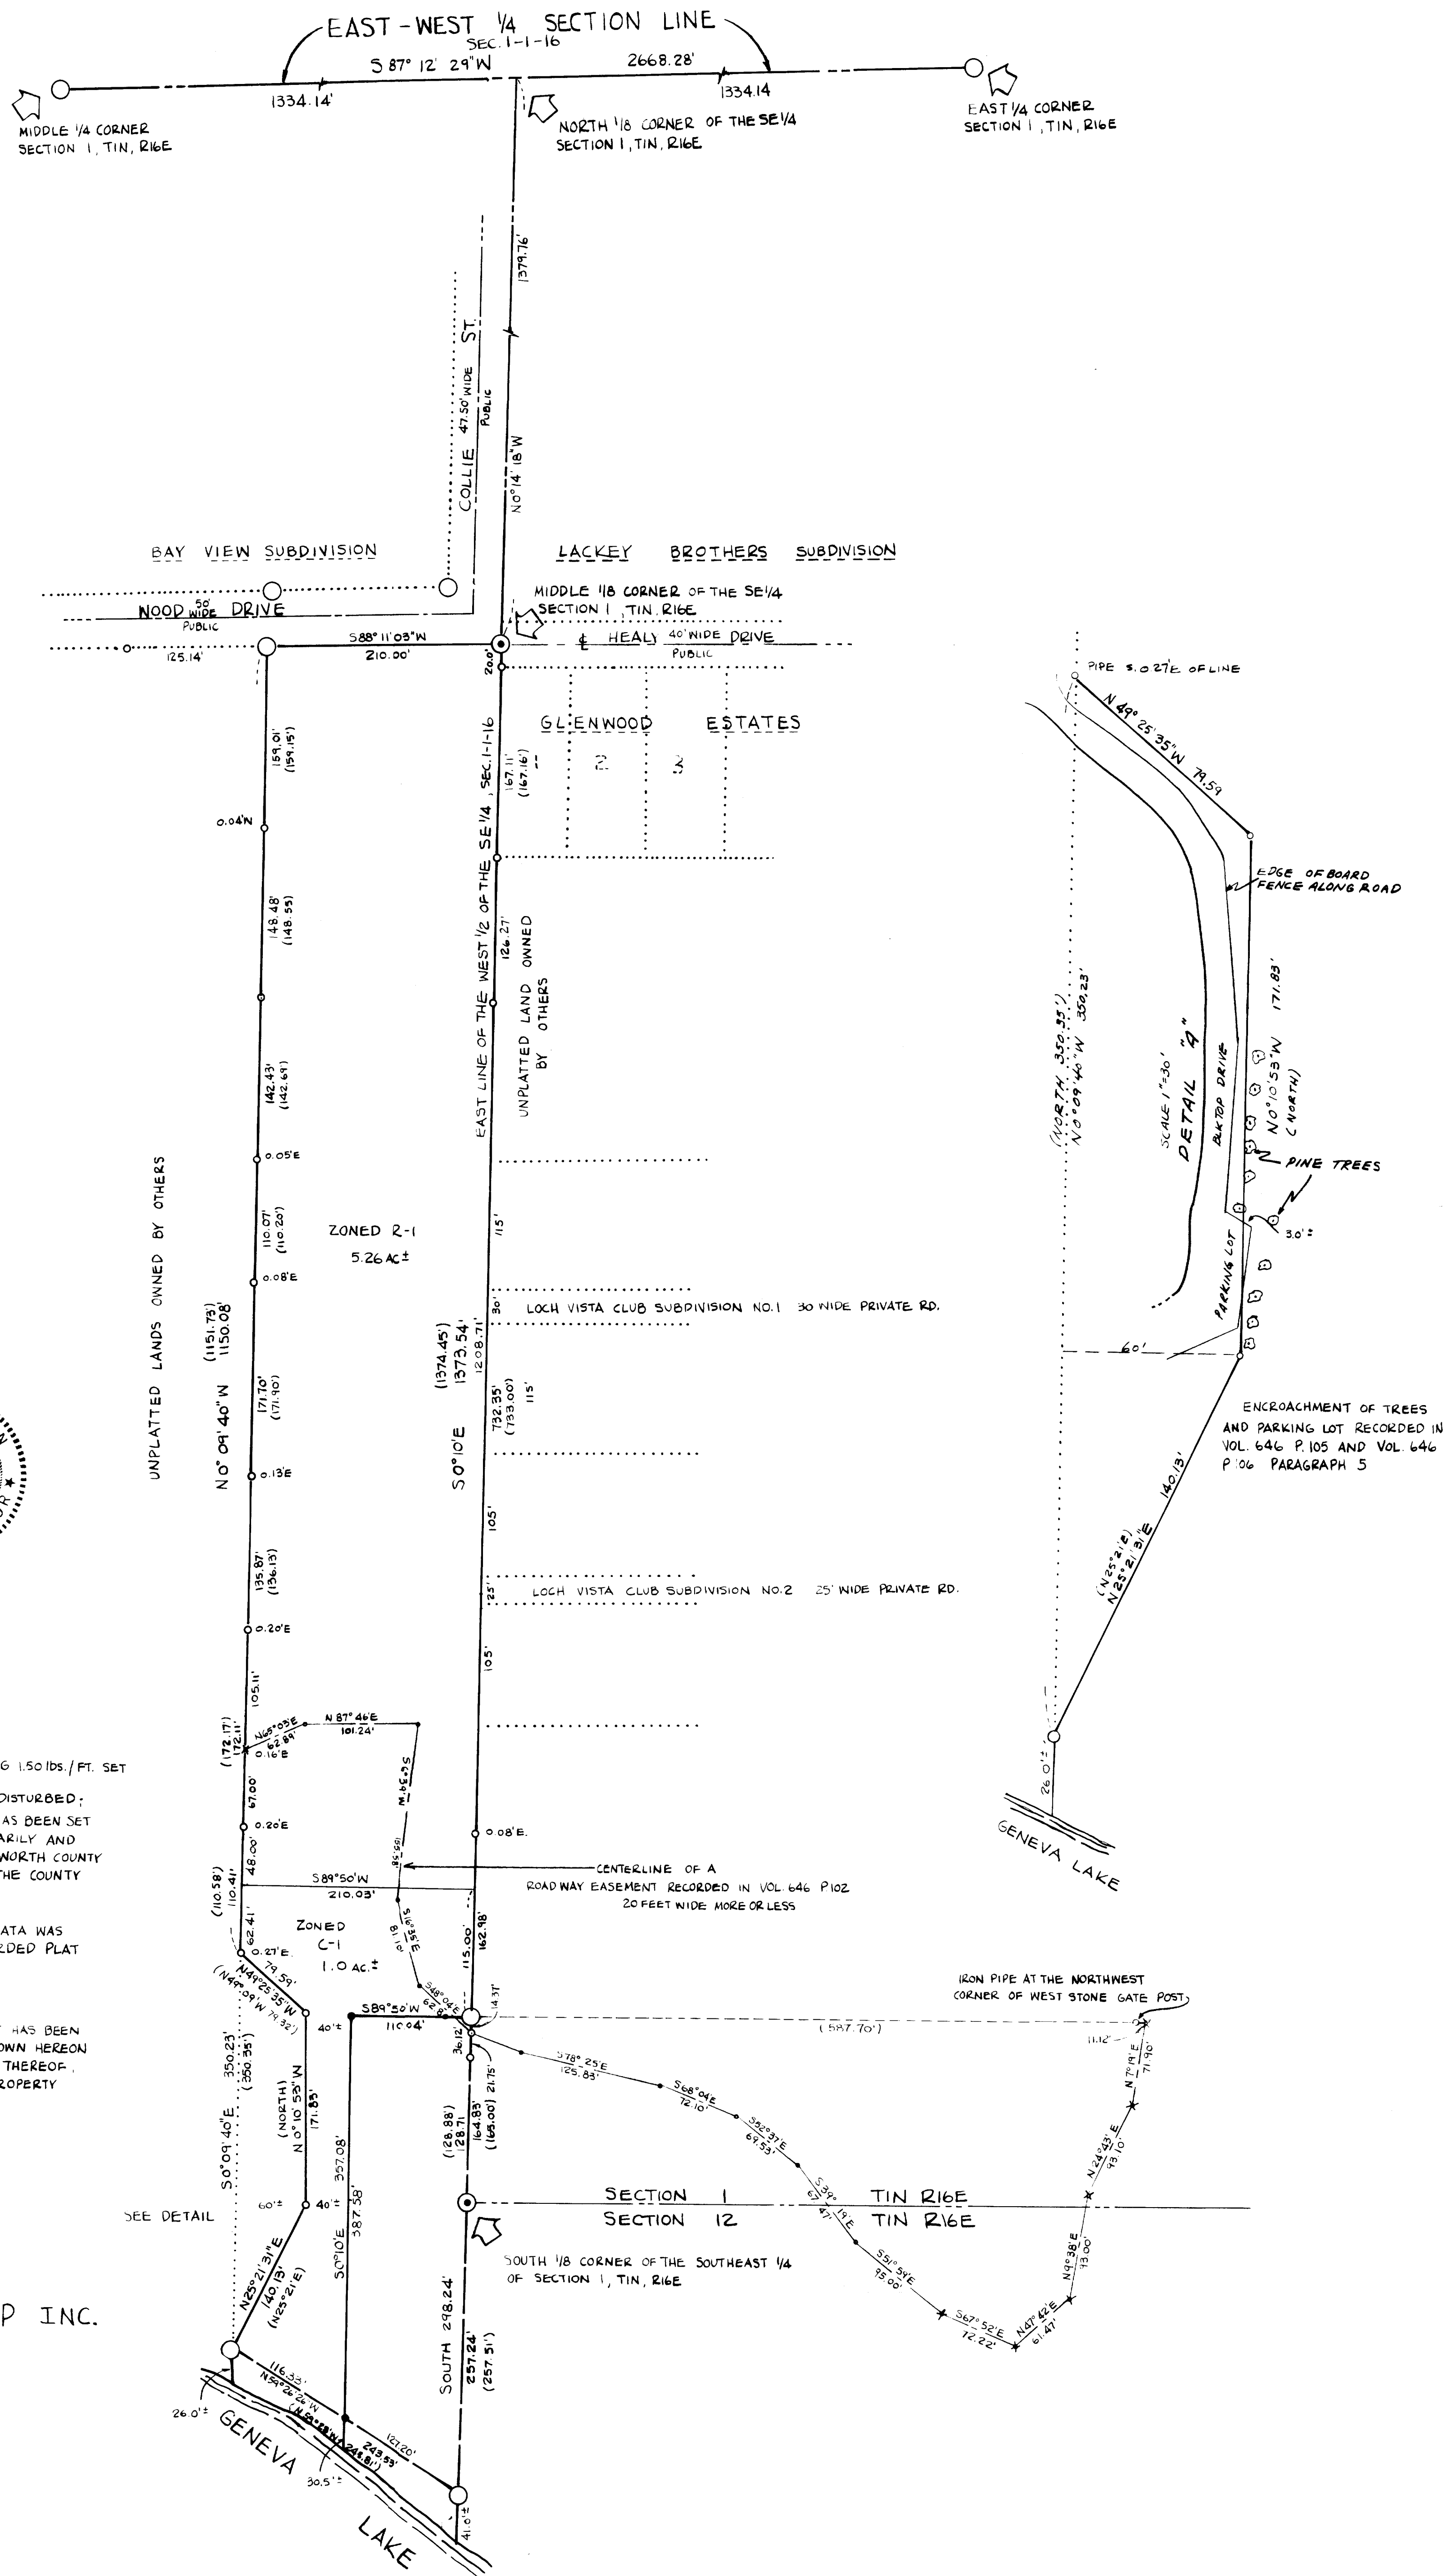

- SCALE 1" = 80 FEET
- LEGEND
- ~ IRON PIPE FOUND
 - ~ 5" DIA. CONCRETE MONUMENT FOUND
 - ~ 3/4" DIA. IRON ROD, 30" LONG WEIGHING 1.50 LBS./FT. SET
 - ⊙ ~ 5" DIA. CONCRETE MONUMENT FOUND DISTURBED; A 3/4" DIA. IRON ROD OR P.K. NAIL HAS BEEN SET IN THE PROPER LOCATION TEMPORARILY AND WILL BE REPLACED WITH A WALWORTH COUNTY SECTION CORNER MONUMENT BY THE COUNTY SURVEYOR AT A LATER DATE
 - () ~ RECORDED AS
- NOTE: ROADWAY EASEMENT CENTERLINE DATA WAS TAKEN FROM A PREVIOUSLY RECORDED PLAT OF SURVEY

I HEREBY CERTIFY THAT THE ABOVE DESCRIBED PROPERTY HAS BEEN SURVEYED UNDER MY DIRECTION AND THAT THE PLAT SHOWN HEREON IS AN ACCURATE SURVEY AND A TRUE REPRESENTATION THEREOF, AND CORRECTLY SHOWS THE BOUNDARY LINES OF SAID PROPERTY

DATED Jan. 4, 1980

THOMAS P.A. JENSEN S-1084

SURVEYED FOR: CONFERENCE POINT CAMP INC.
CONFERENCE POINT ROAD
WILLIAMS BAY, WISCONSIN 53191
c/o MR. JACK HAYES