

ENGINEERING, SURVEYING AND LAND PLANNING
715 W. WALWORTH ST. - P.O. BOX 487 - ELKHORN, WI 53121
OFFICE: 414/723-2088

Seller: Joeseph Brozek


Buyer: John J. & Rosara E. Markett




NORTH

Scale: 1"=30'

⚬ = Iron pipe survey stake found
 ○ = Iron pipe survey stake placed
 △ = Concrete (P.K.) nail found
 (xx) = Record dimension from original plat

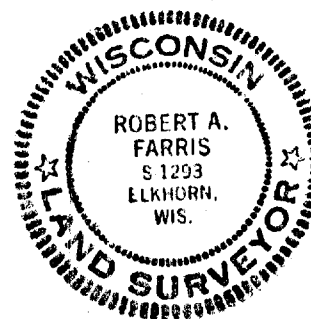

Privacy Fence Along Part of this
line is located entirely on lots 26 & 27

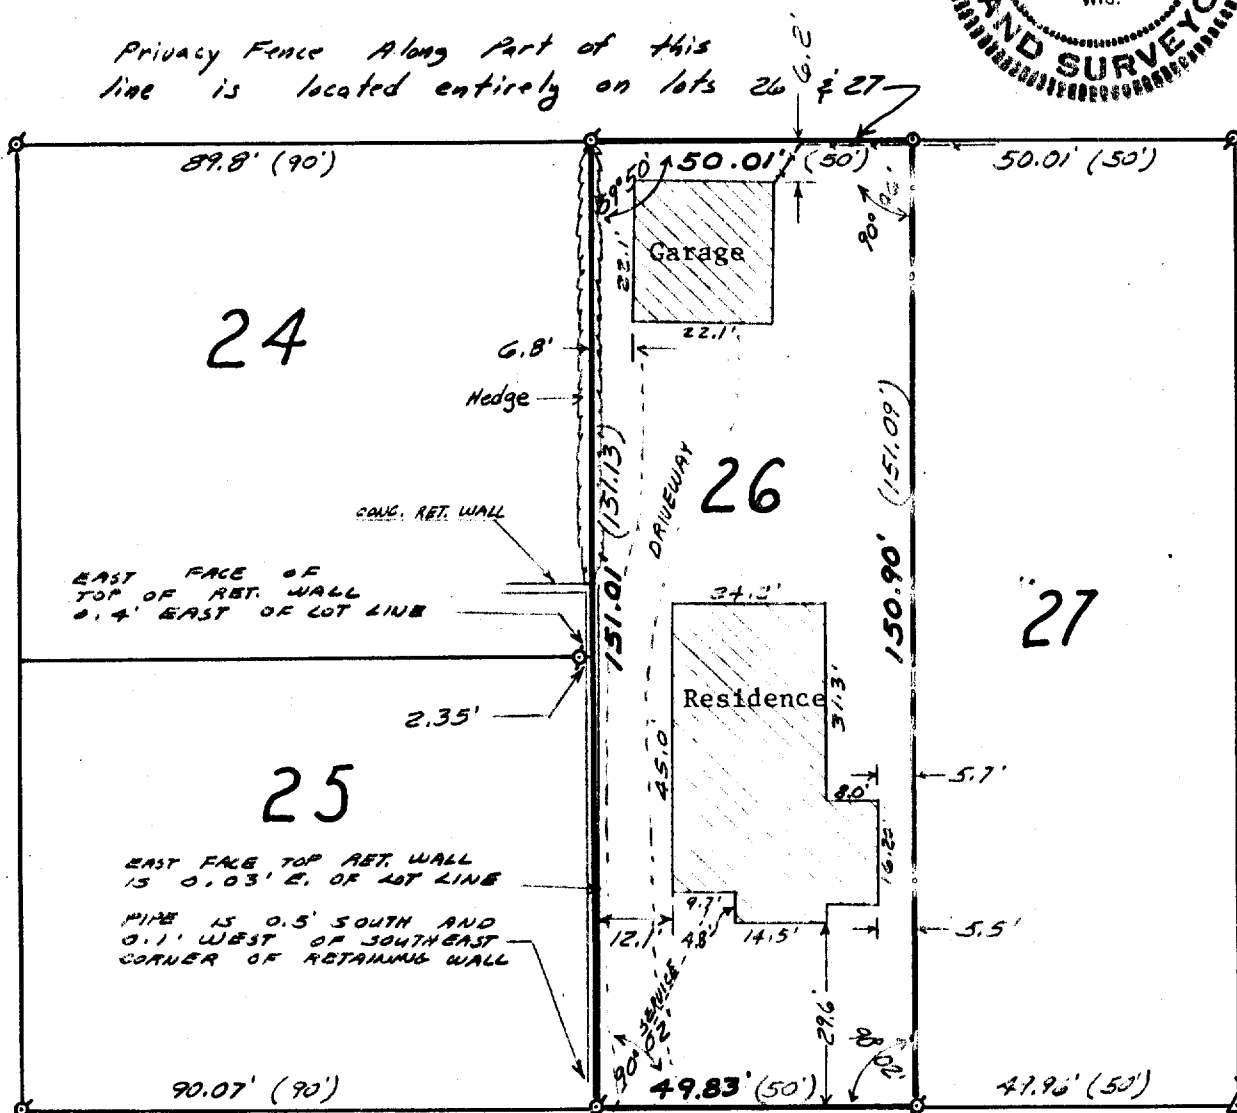

I hereby certify that I have surveyed the above described property and that the above map is a true representation thereof and shows the size and location of the property, its exterior boundaries, the location of all visible structures and dimensions of all principal buildings thereon, boundary fences, apparent easements, roadways and visible encroachments, if any.

This survey is made for the use of the present owners of the property, and also those who purchase, mortgage, or guarantee the title thereto within one (1) year from date hereof.

LEICHTY DRIVE 30' WIDE

Robert A. Harris 6 Nov. 1981

DRAWING NUMBER #1904