

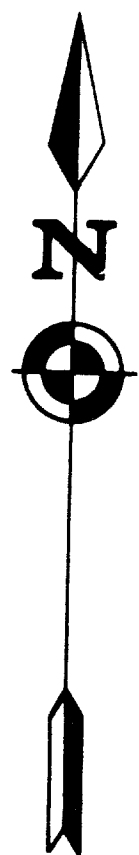


PLAT OF SURVEY

OF HOUSE LOCATION AT STAMSWOODS PARCEL
LOCATED IN SEC. 1 & SEC. 12, T1N, R16E, VILLAGE
OF WILLIAMS BAY, WALWORTH CO., WIS.

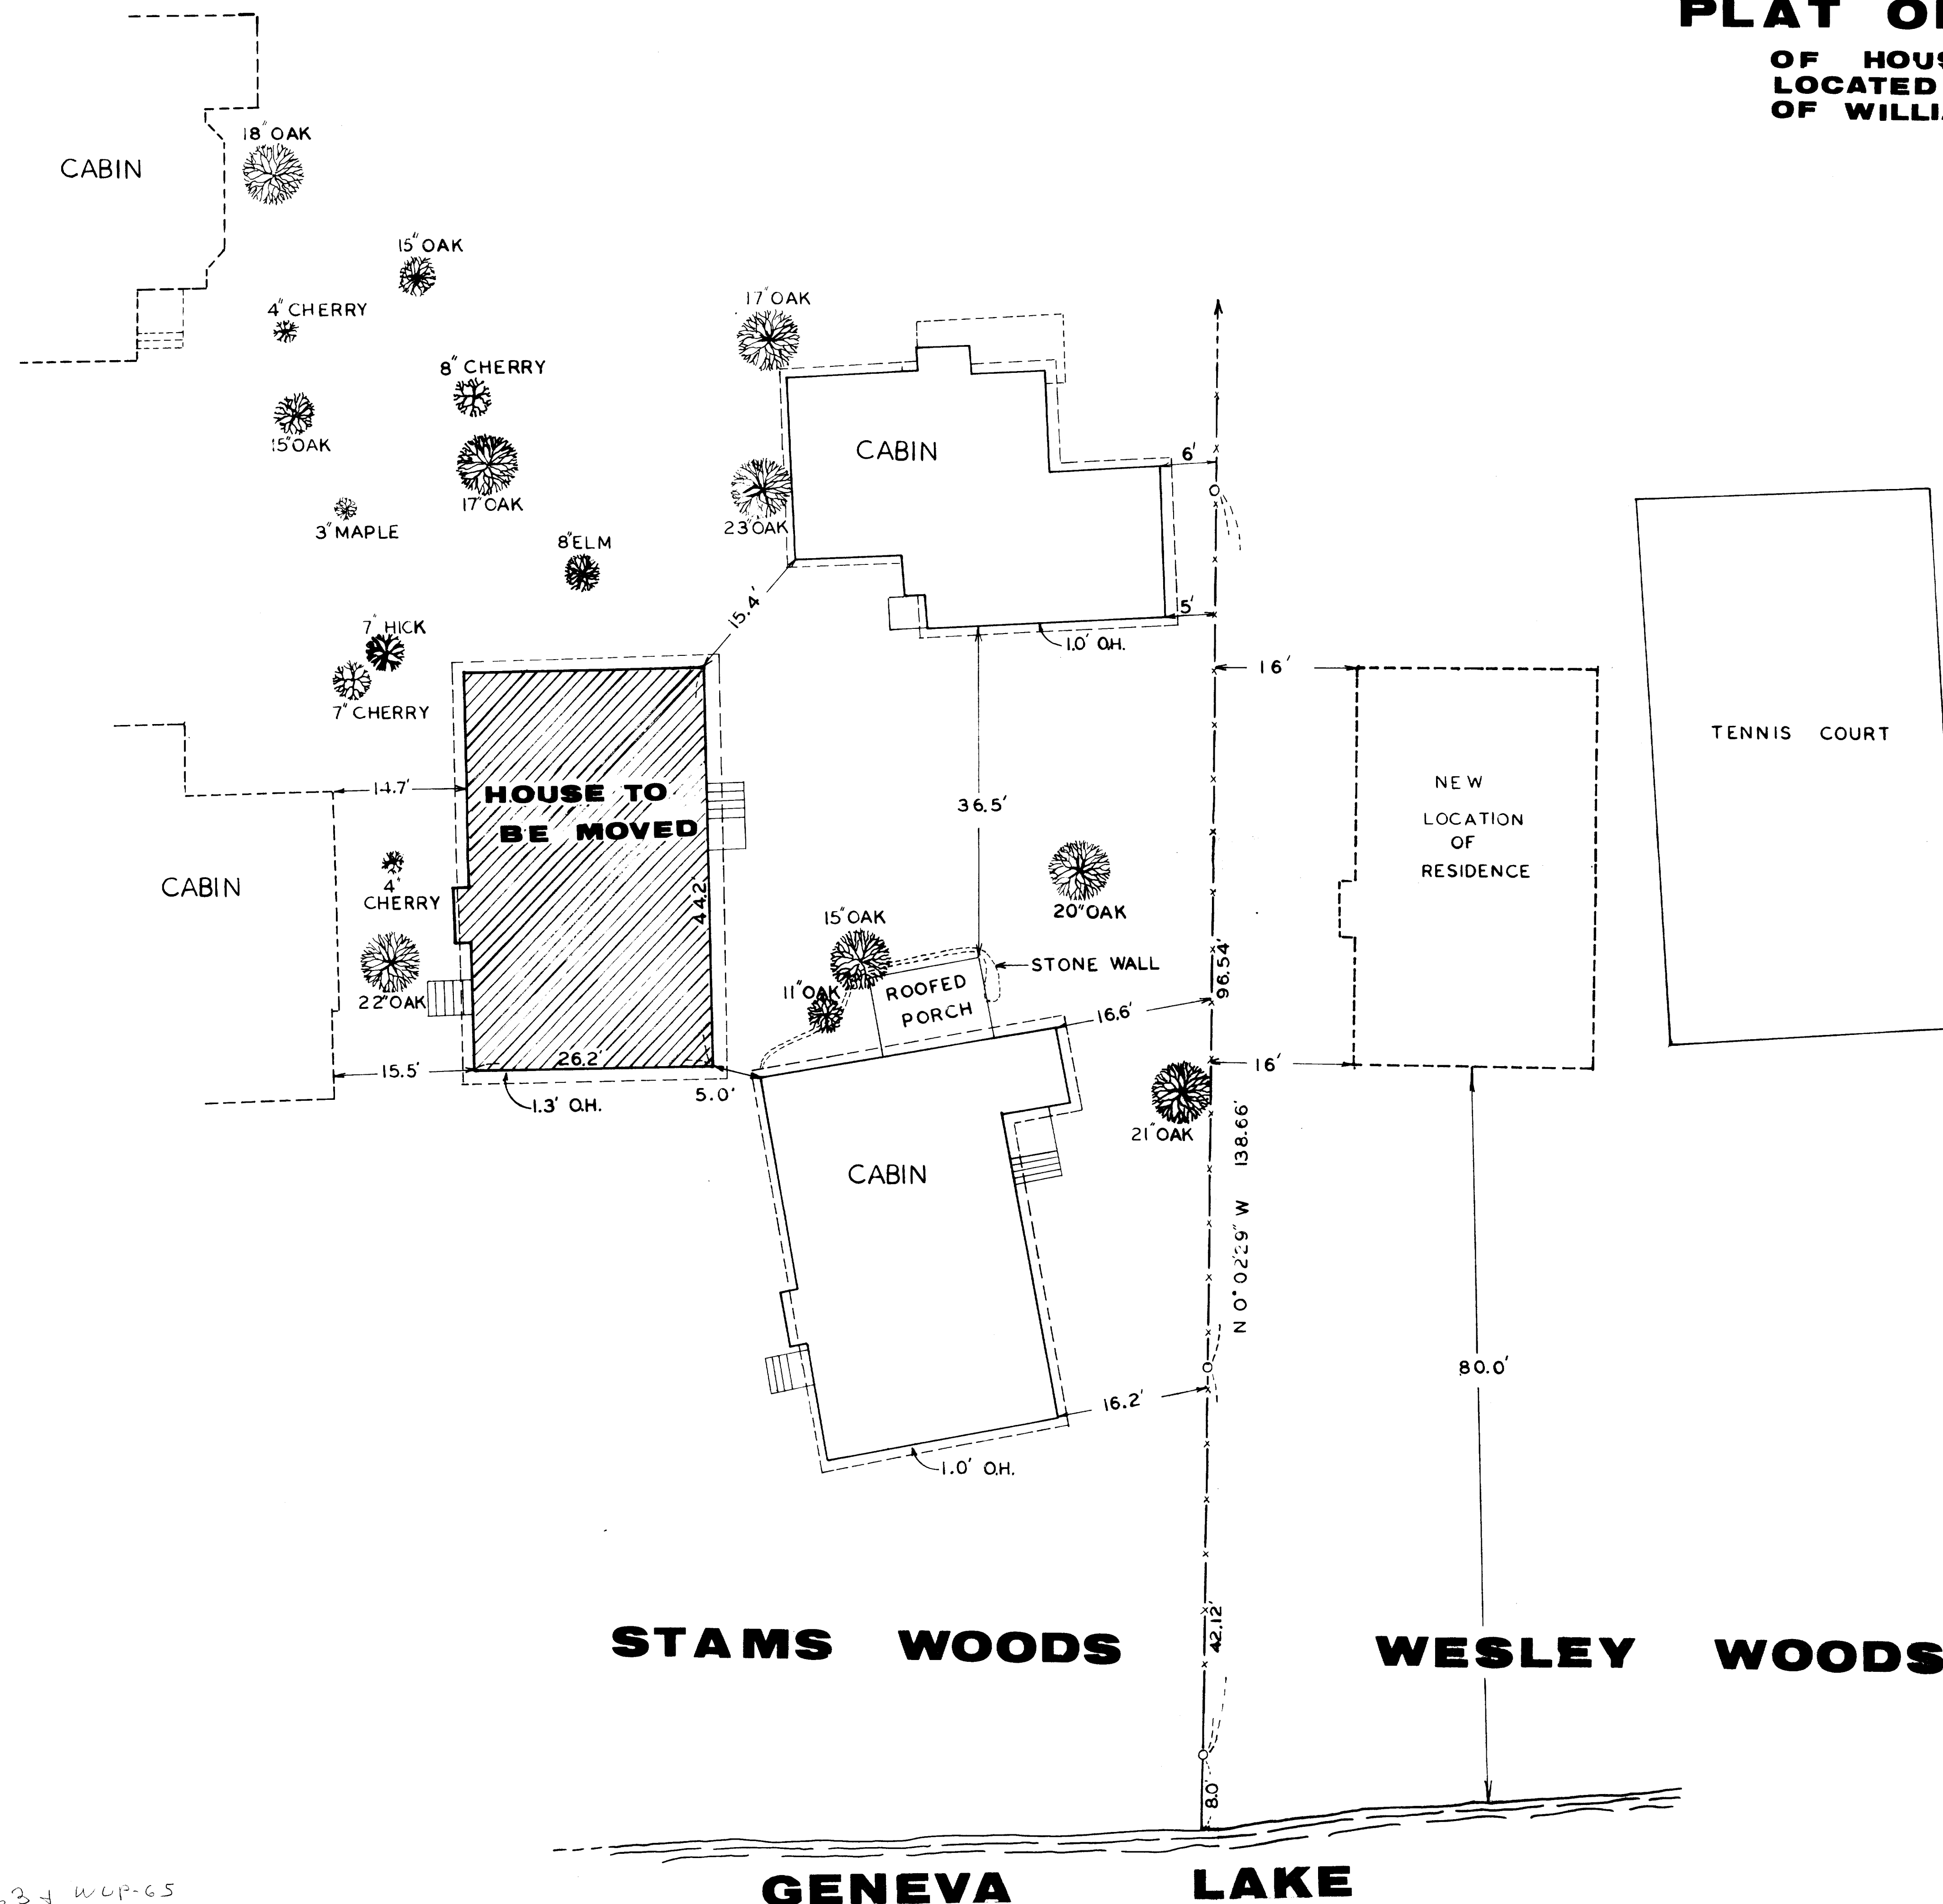

SCALE 1"=10'

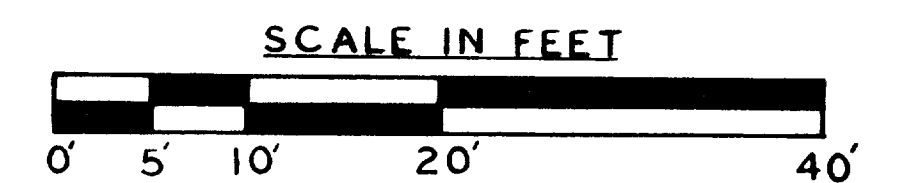

LEGEND

- IRON PIPE FOUND
- x—x— FENCE
- QH. — OVERHANG

I HEREBY CERTIFY THAT I HAVE SURVEYED THE ABOVE
DESCRIBED PROPERTY AND THAT THE PLAT HEREON
DRAWN IS AN ACCURATE SURVEY AND A TRUE REPRESENTATION
THEREOF AND CORRECTLY SHOWS THE STRUCTURES
OF SAID PROPERTY

DATED THIS 7th DAY OF MAY 1982



Kenneth B. Abernathy, Jr.
KENNETH B. ABERNATHY, JR.
WIS. REG. NO. S-1594

JENSEN SURVEYING & MAPPING, S.C.
PO BOX 322
ELKHORN WIS.

Line between WUP-634 WUP-65
Village of Home Bay

11-432-J #1982.017