

NOTE: WATER DEPTH AT END
OF PIER 7.4 FEET

NOTE: WATER DEPTH AT END
OF PIER 6.8 FEET

GENEVA LAKE

PIER 6' WIDE
6.94' WIDE
OUTSIDE POSTS

PIER 5' WIDE
6' WIDE OUTSIDE POSTS

CONCRETE
SEA WALL


NOTE: SURVEY DATED
NOV. 1947 USED TO
PLOT SHORE LINE
OF LOT III

PLAT OF SURVEY OF

SHORE LINE & PIER LOCATION
AT LOT 119 & PARK RIDGE ROAD
CEDAR POINT PARK SUBDIVISION
SECOND ADDITION, VILLAGE OF
WILLIAMS BAY, WALKWORTH COUNTY,
WISCONSIN.

SEPT. 9, 1980

THOMAS P. A. JENSEN
THOMAS P. A. JENSEN R.L.S. #1084
JENSEN SURVEYING & MAPPING
RD. BOX 322
39 S. WIS. ST.
ELKHORN, WIS. 53121
414-723-3434

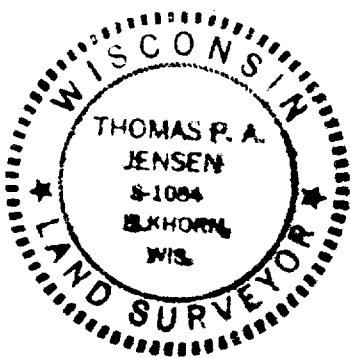

NORTH ASSUMED

SCALE 1" = 20'

○ ~ IRON PIPE FOUND

● ~ CONCRETE MONUMENT
FOUND

SURVEYED FOR:
H.C. SANDBLOM
8673 GROSS POINT
EVENSTON, ILL. 60201

() ~ RECORDED

LOT 111

PARK RIDGE ROAD
40' WIDE

LOT 119

LOT 120

ALLEY 20' WIDE

1980.046