


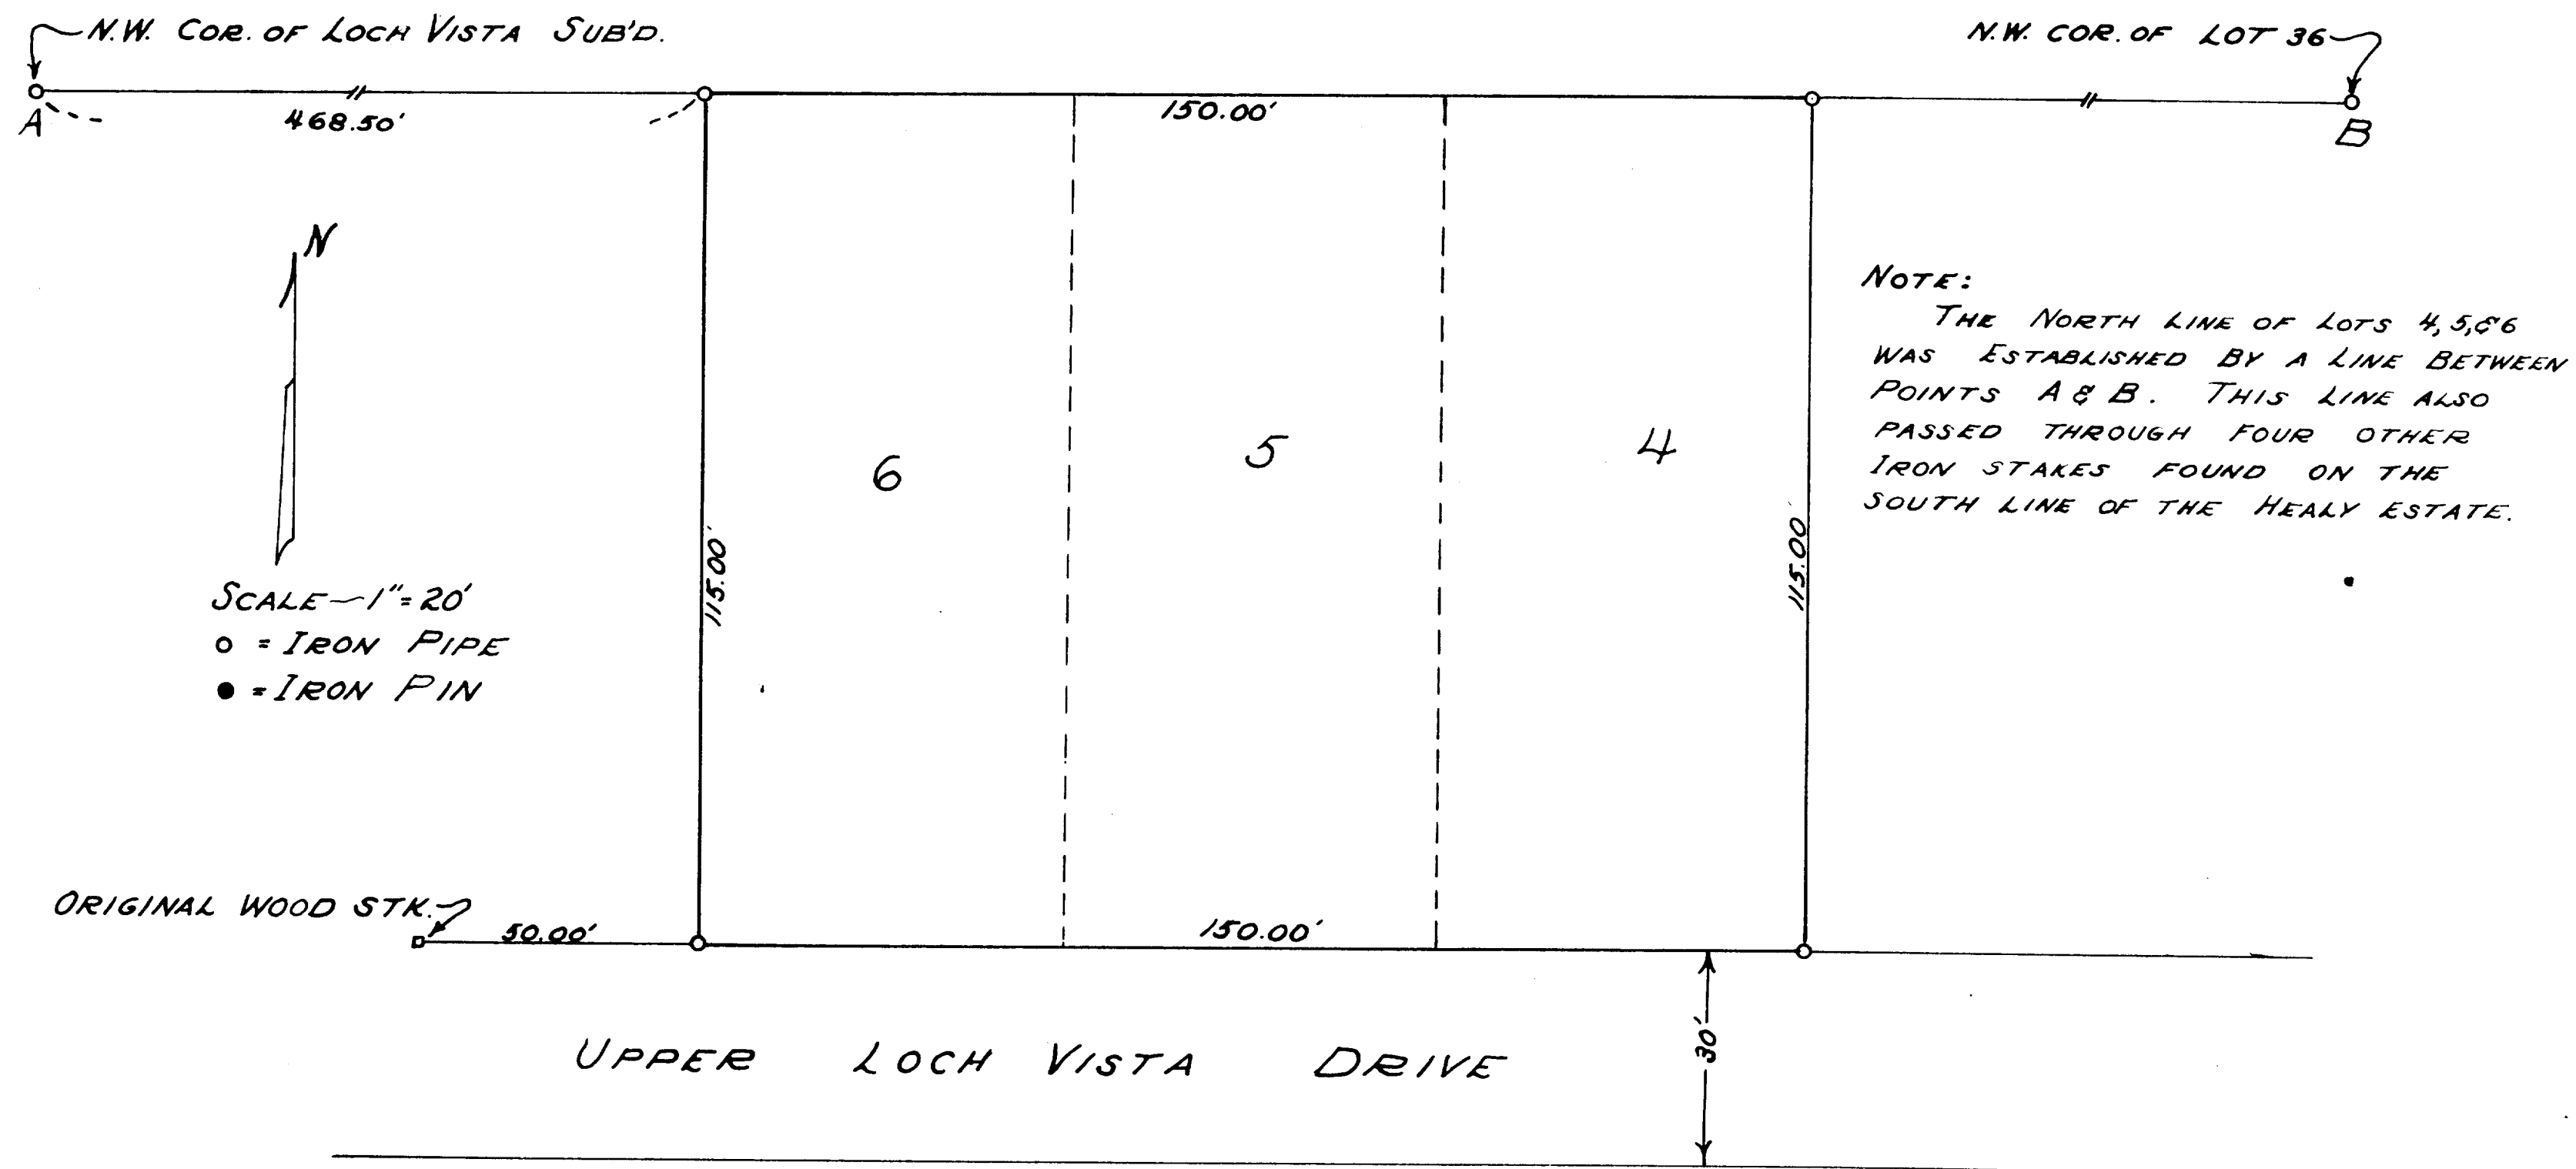

PLAT of SURVEY

LOTS 4, 5 & 6 OF LOCH VISTA SUBDIVISION No. 1, VILLAGE OF WILLIAMS BAY,
WALWORTH COUNTY, WISCONSIN.

JULY, 1948

Lloyd L. Jensen
CO. SURVEYOR 11-42J