



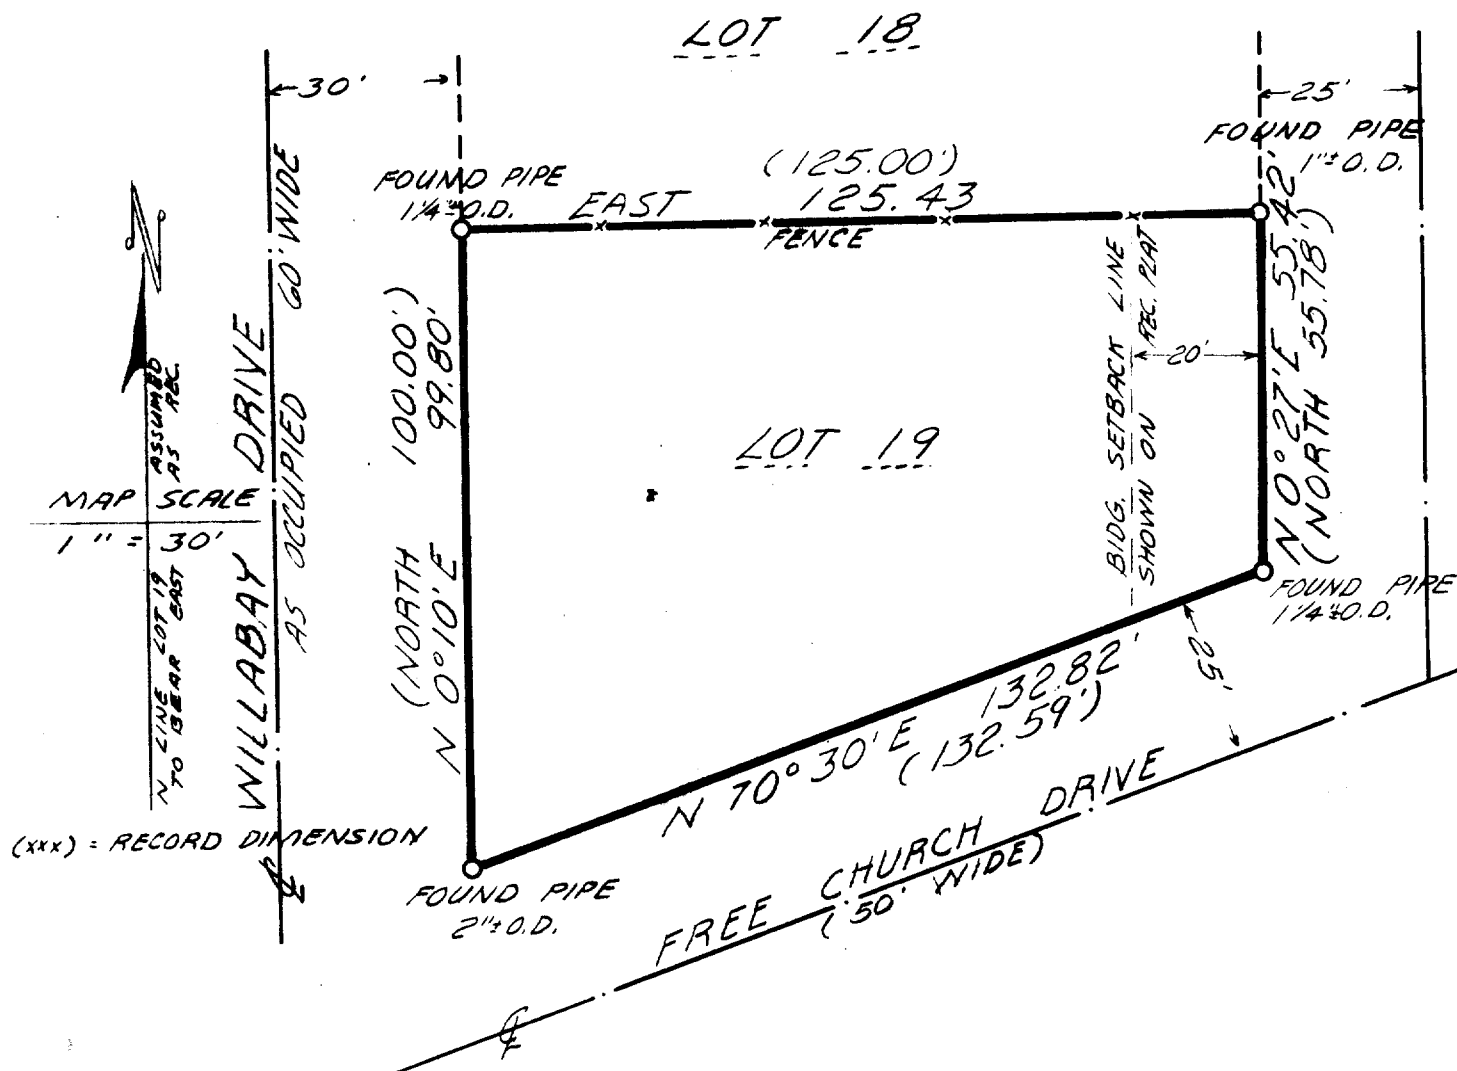

PLAT OF SURVEY OF LOT 19 OF EVANGELICAL FREE CHURCH SUBDIVISION
Located in the Northeast 1/4 of Section 6, Town 1 North, Range 17
East, Village of Williams Bay, Walworth County, Wisconsin.

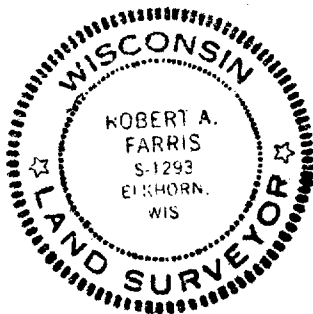

I hereby certify that at the direction of Glenn Roos
the land described hereon was surveyed under my direction
and that this Plat of Survey is a true and accurate rep-
resentation of the lot lines to the best of my professional
knowledge and belief.

Robert A. Farris
Robert A. Farris RLS

Plat drafted and signed this 28 day of May, 1983

Date of Field Work -- 12 December, 1980

Farris, Hansen & Associates Inc.
Elkhorn, Wisconsin

Project No. 1792

11-431-F

W2F-19