


DUNHAM SURVEYING, S. C.
SURVEYING & SUBDIVIDING
DELAVAN, WISCONSIN 53115

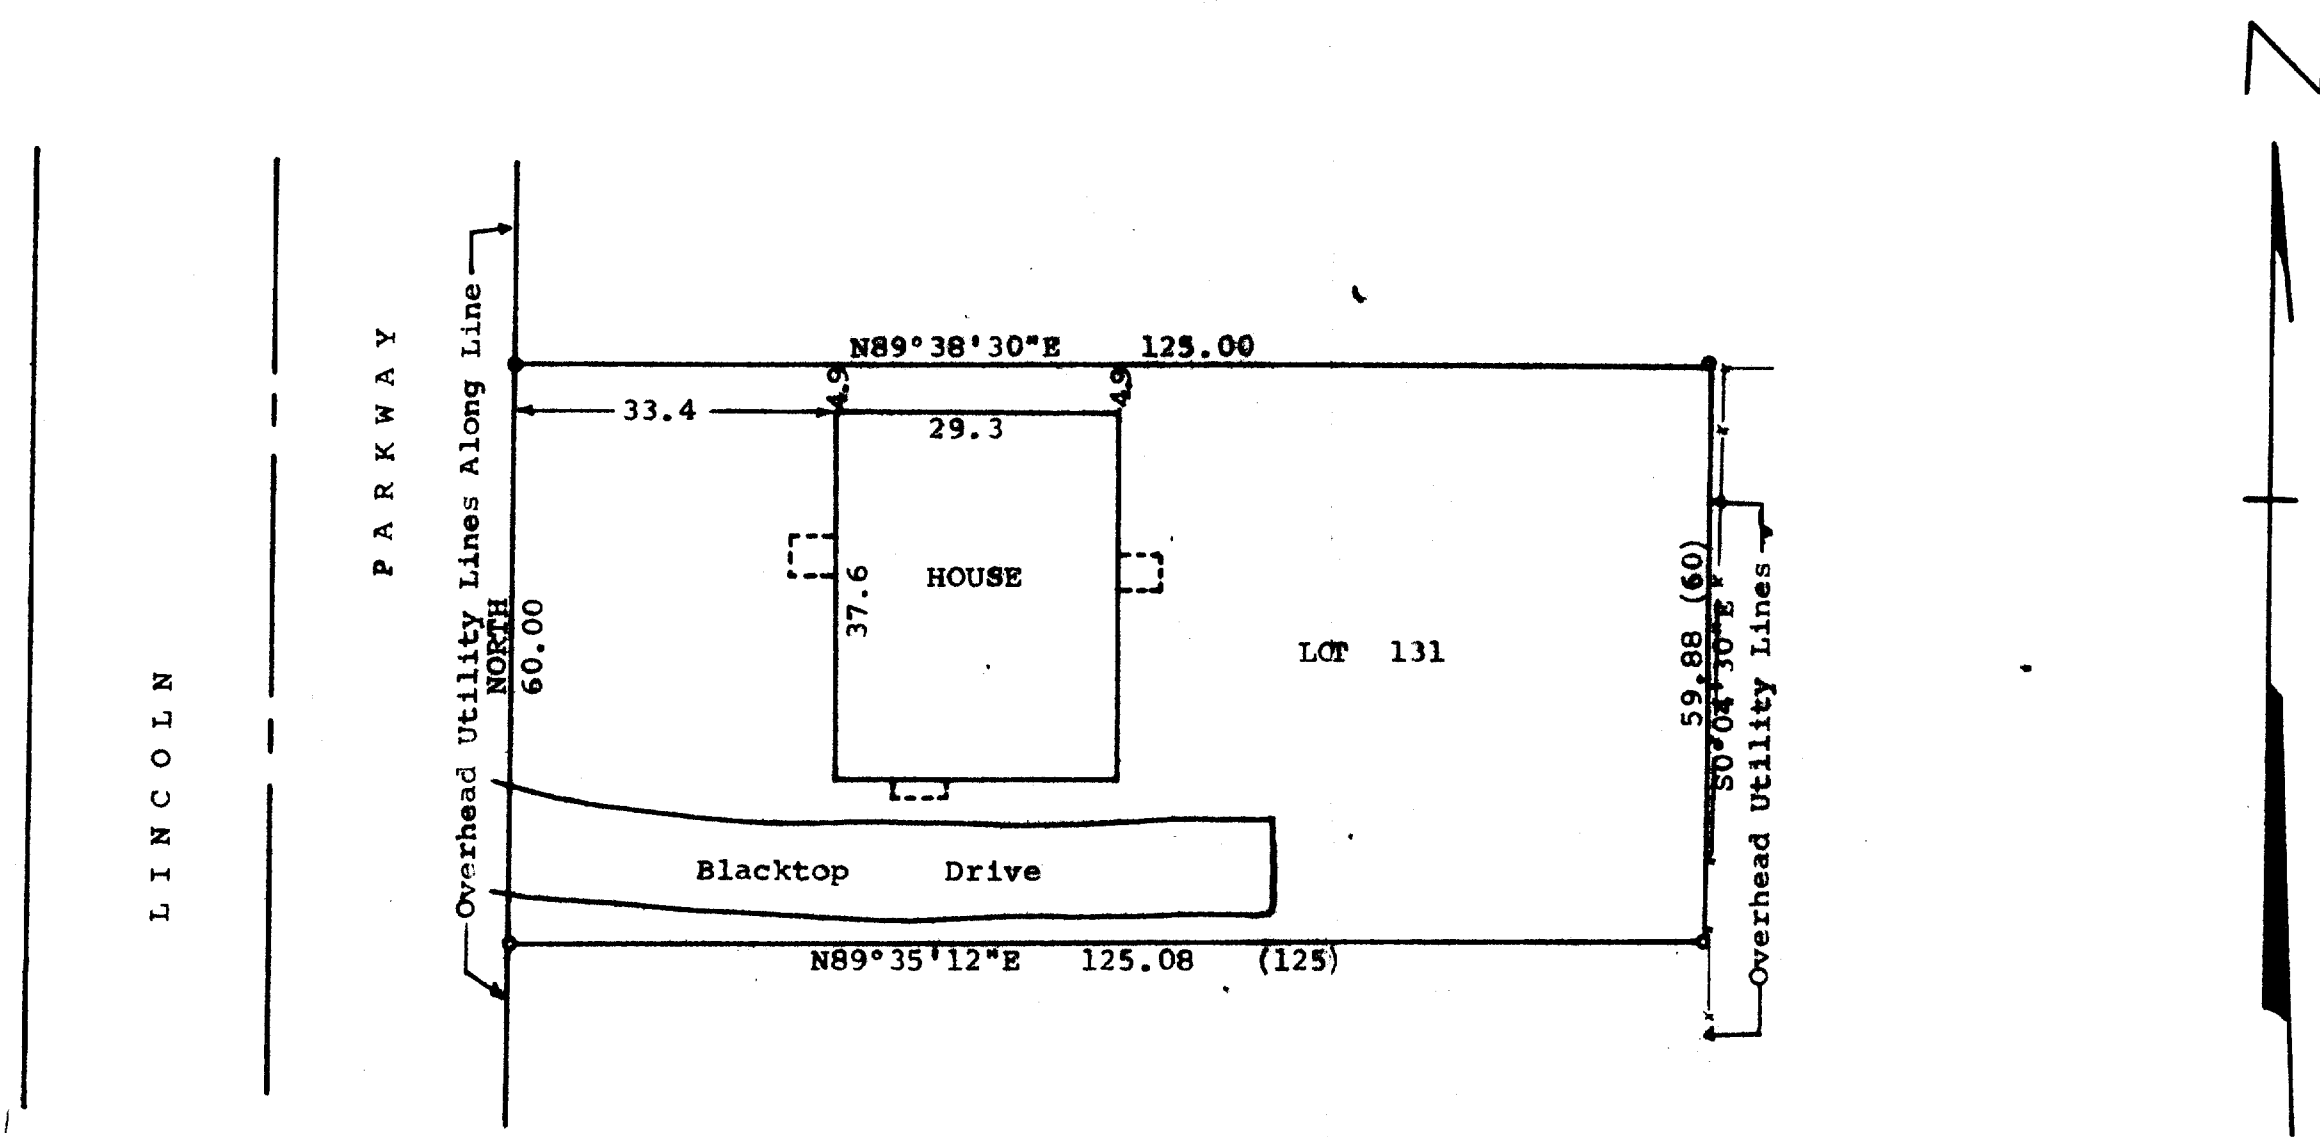

Scale - 1" = 20'
 • = Iron Pipe Found
 --- = Fence Line
 () = Recorded Distance

Bearings are referenced to the east line of Lincoln Parkway. Assumed bearing is North.

Survey ordered by: Richard Cain
 Attorney at Law
 3rd Avenue
 Fontana, Wisconsin

STATE OF WISCONSIN)
 COUNTY OF WALWORTH) SS

I, James M. Dunham, Surveyor, certify that I have surveyed the property described as follows,
 Lot 131 of Cedar Point Park, a subdivision located in the Village of Williams Bay, Walworth County, Wisconsin, and that the above map is a true representation thereof and shows the size and location of the property, its exterior boundaries, the location of all visible structures and dimensions of all principal buildings thereon, boundary fences, apparent easements, roadways and visible encroachments, if any.
 This survey is made for the use of the present owners of the property, and also those who purchase, mortgage, or guarantee the title thereto within one (1) year from date hereof.
 December 22, 1982

James M. Dunham
 James M. Dunham, Surveyor

