


DUNHAM SURVEYING, S.C.
SURVEYING & SUBDIVIDING
DELAVAN, WISCONSIN 53115

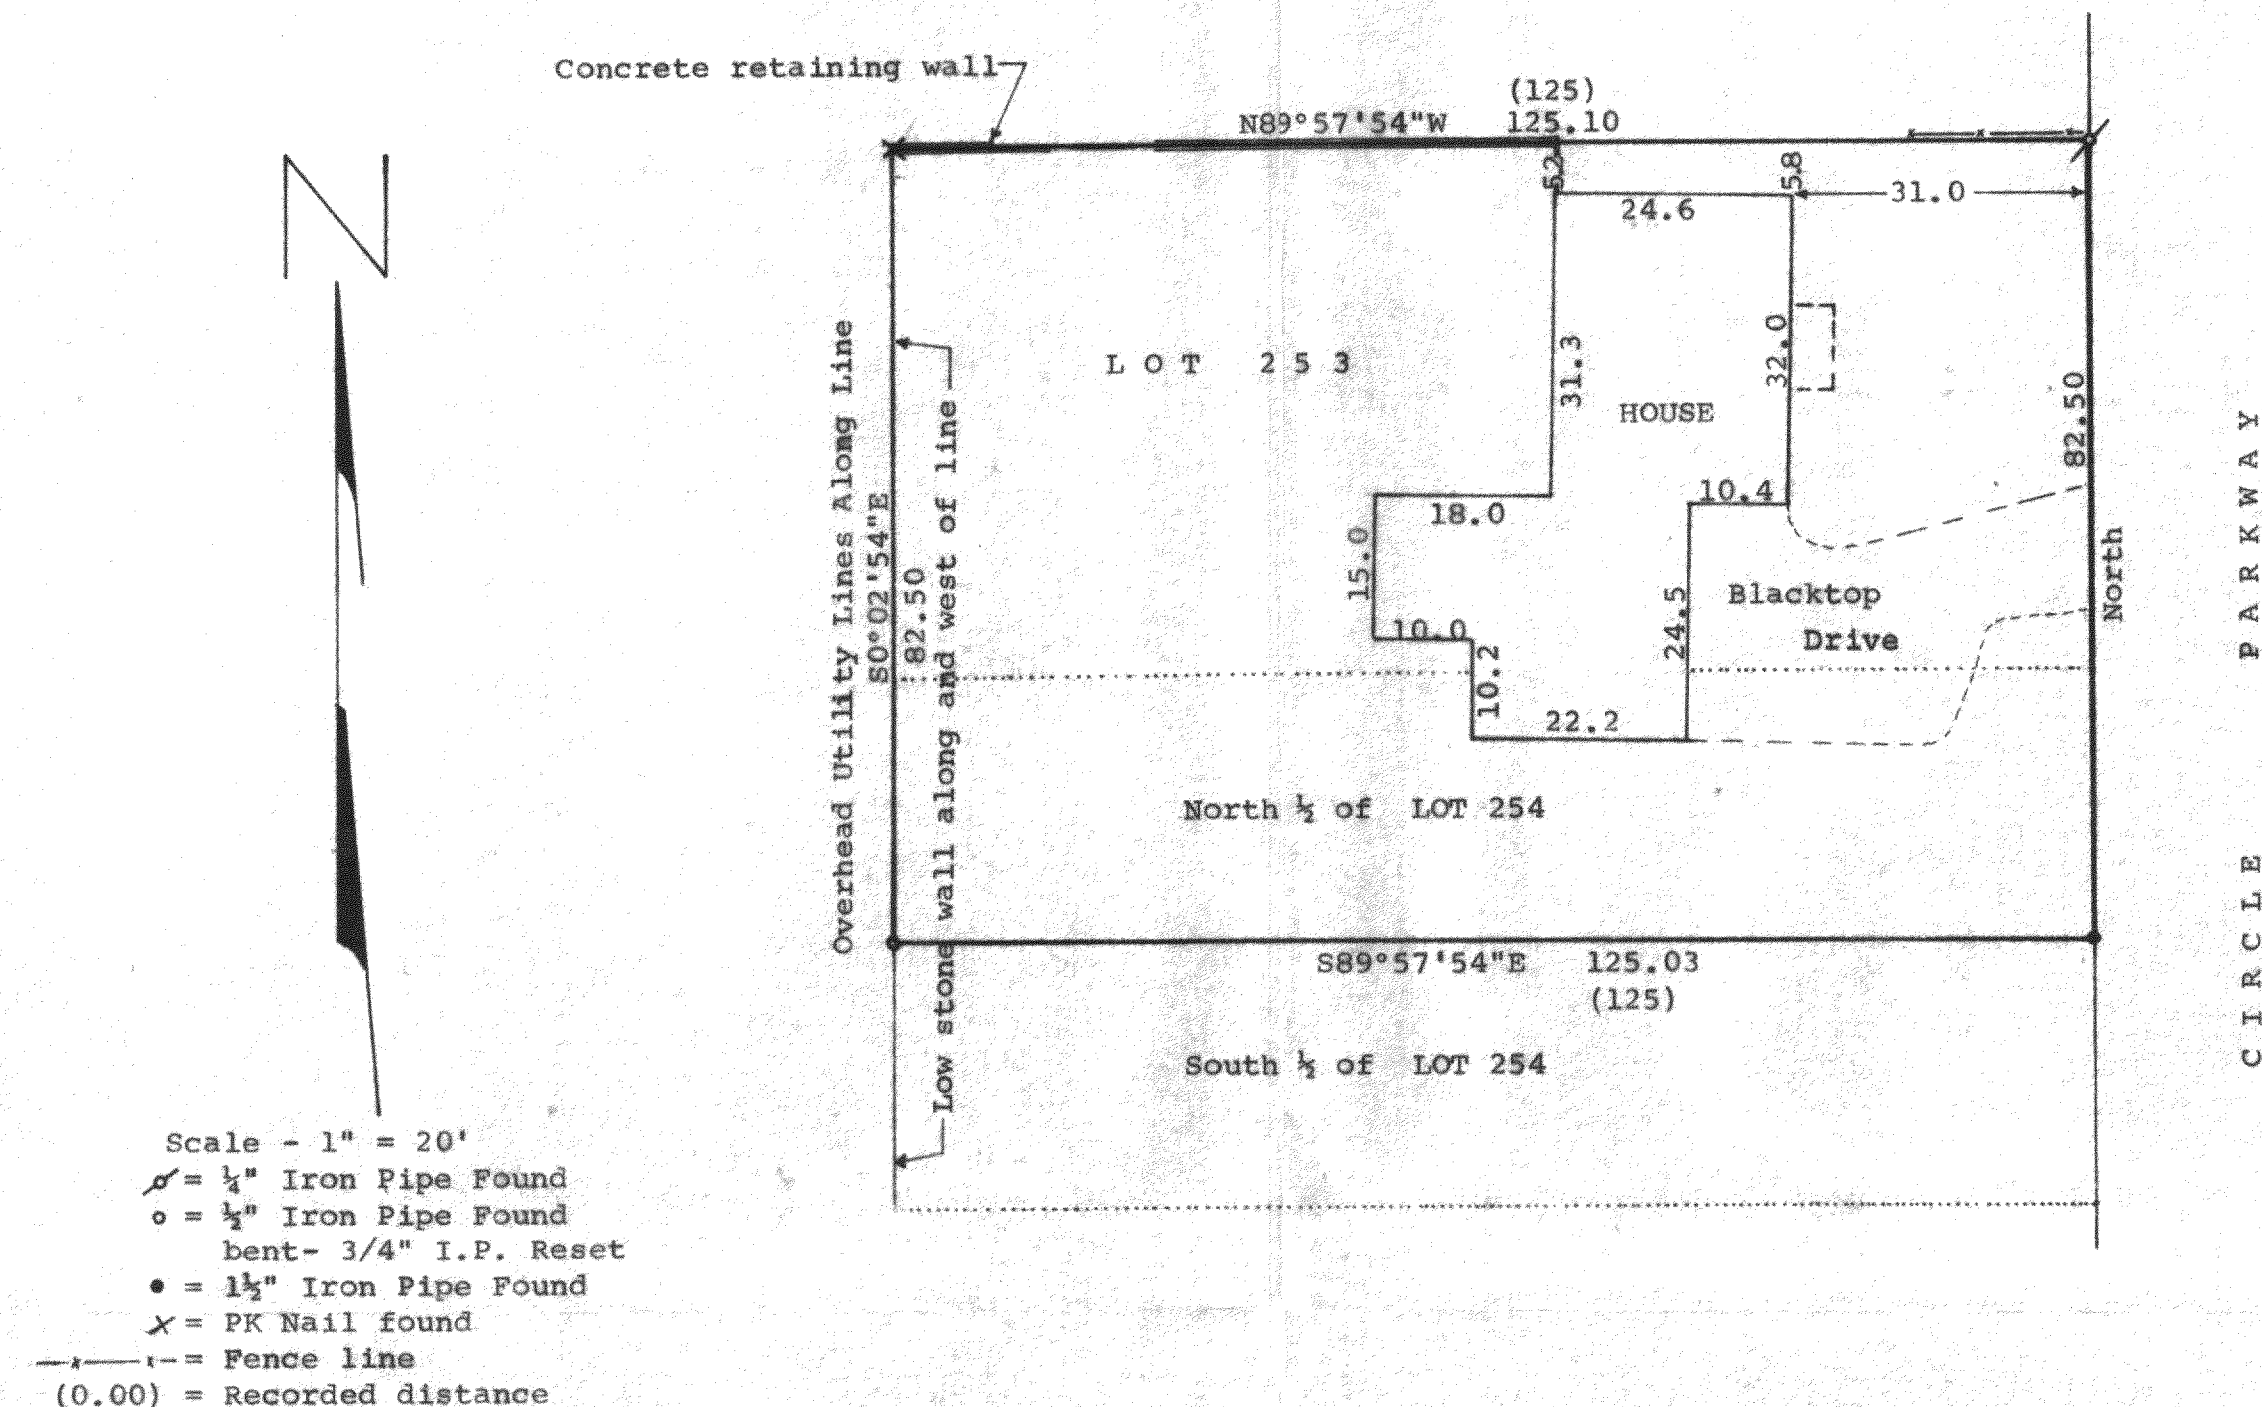

Ordered by: Better Homes & Gardens
Keefe Real Estate, Inc.
302 E. Walworth Ave.
Delavan, Wisconsin 53115

STATE OF WISCONSIN)
COUNTY OF WALWORTH) SS

I, George T. Dunham, Surveyor, certify that I have surveyed the property described as follows,
Lot 253 and the North 1/2 of Lot 254 of the Third Addition to Cedar Point Park, a subdivision located in Sections 6 and 7, T 1 N, R 17 E, Village of Williams Bay, Walworth County, Wisconsin, and that the plat shown above is a true representation thereof and shows the size and location of the property, its exterior boundaries, the location of boundary fences, apparent easements, roadways and visible encroachments, if any, and that I have surveyed the property hereon described according to the official records to the best of my knowledge and belief.
March 14, 1984

George T. Dunham
George T. Dunham, Surveyor

