

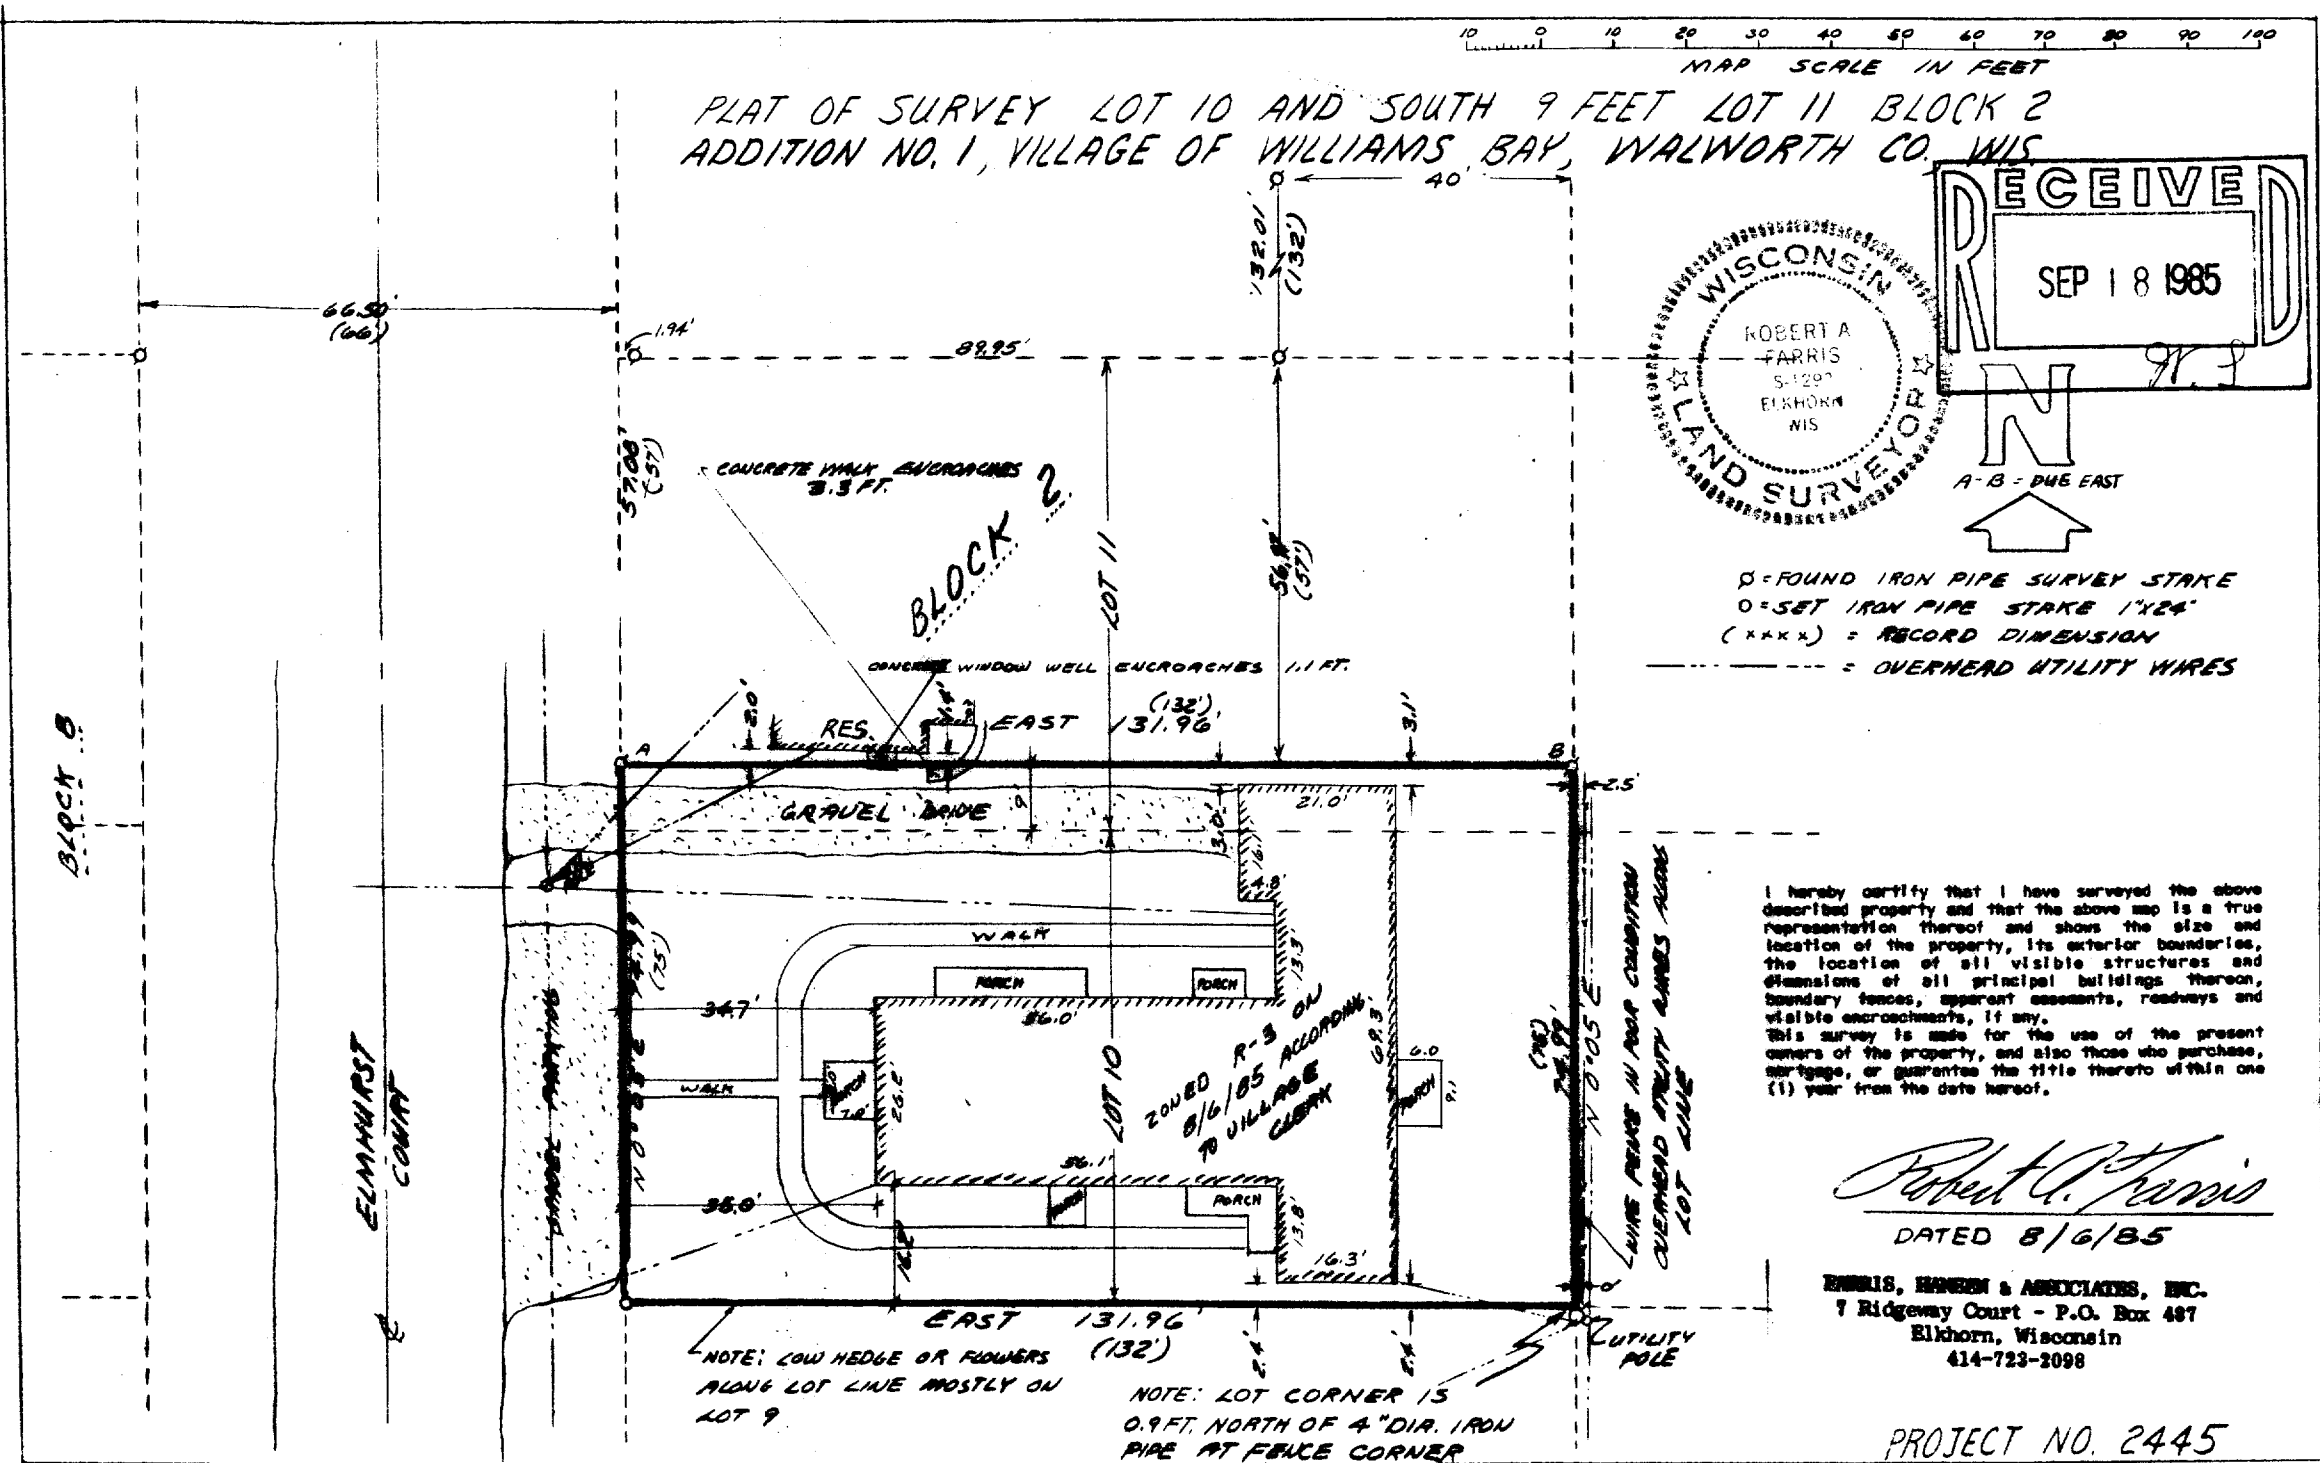


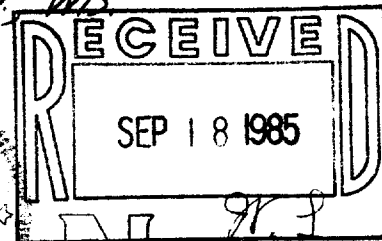

PLAT OF SURVEY LOT 10 AND SOUTH 9 FEET LOT 11 BLOCK 2
ADDITION NO. 1, VILLAGE OF WILLIAMS BAY, WALWORTH CO. WIS.

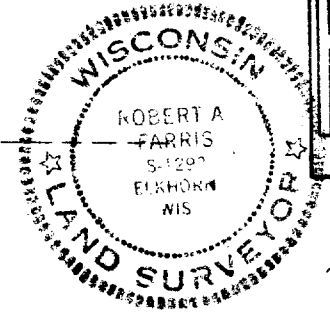

A-B = DUE EAST

Ø = FOUND IRON PIPE SURVEY STAKE
O = SET IRON PIPE STAKE 1" X 24"
(XXX) = RECORD DIMENSION
--- = OVERHEAD UTILITY WIRES

I hereby certify that I have surveyed the above described property and that the above map is a true representation thereof and shows the size and location of the property, its exterior boundaries, the location of all visible structures and dimensions of all principal buildings thereon, boundary fences, apparent easements, roadways and visible encroachments, if any.
This survey is made for the use of the present owners of the property, and also those who purchase, mortgage, or guarantee the title thereto within one (1) year from the date hereof.

Robert A. Farris
DATED 8/6/85

RENNIS, HANSEN & ASSOCIATES, INC.
7 Ridgeway Court - P.O. Box 487
Elkhorn, Wisconsin
414-723-2098

PROJECT NO. 2445

Parcel - Key No. WOP-21

11-4404F