

PLAT OF SURVEY OF "STUYVESANT PARK"  
BEING PART OF SUMMER HAVEN SUBDIVISION,  
VILLAGE OF WILLIAMS BAY, WALWORTH COUNTY,  
WISCONSIN

JENSEN SURVEYING & MAPPING S.C.



P.O. BOX 322

45 S. WISCONSIN ST.

ELKHORN, WISCONSIN

(414) 723-3434

53121

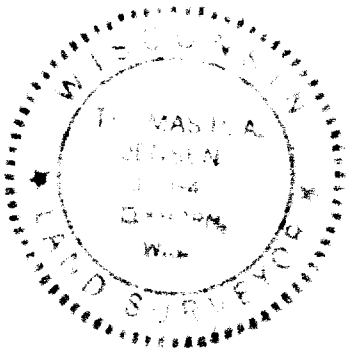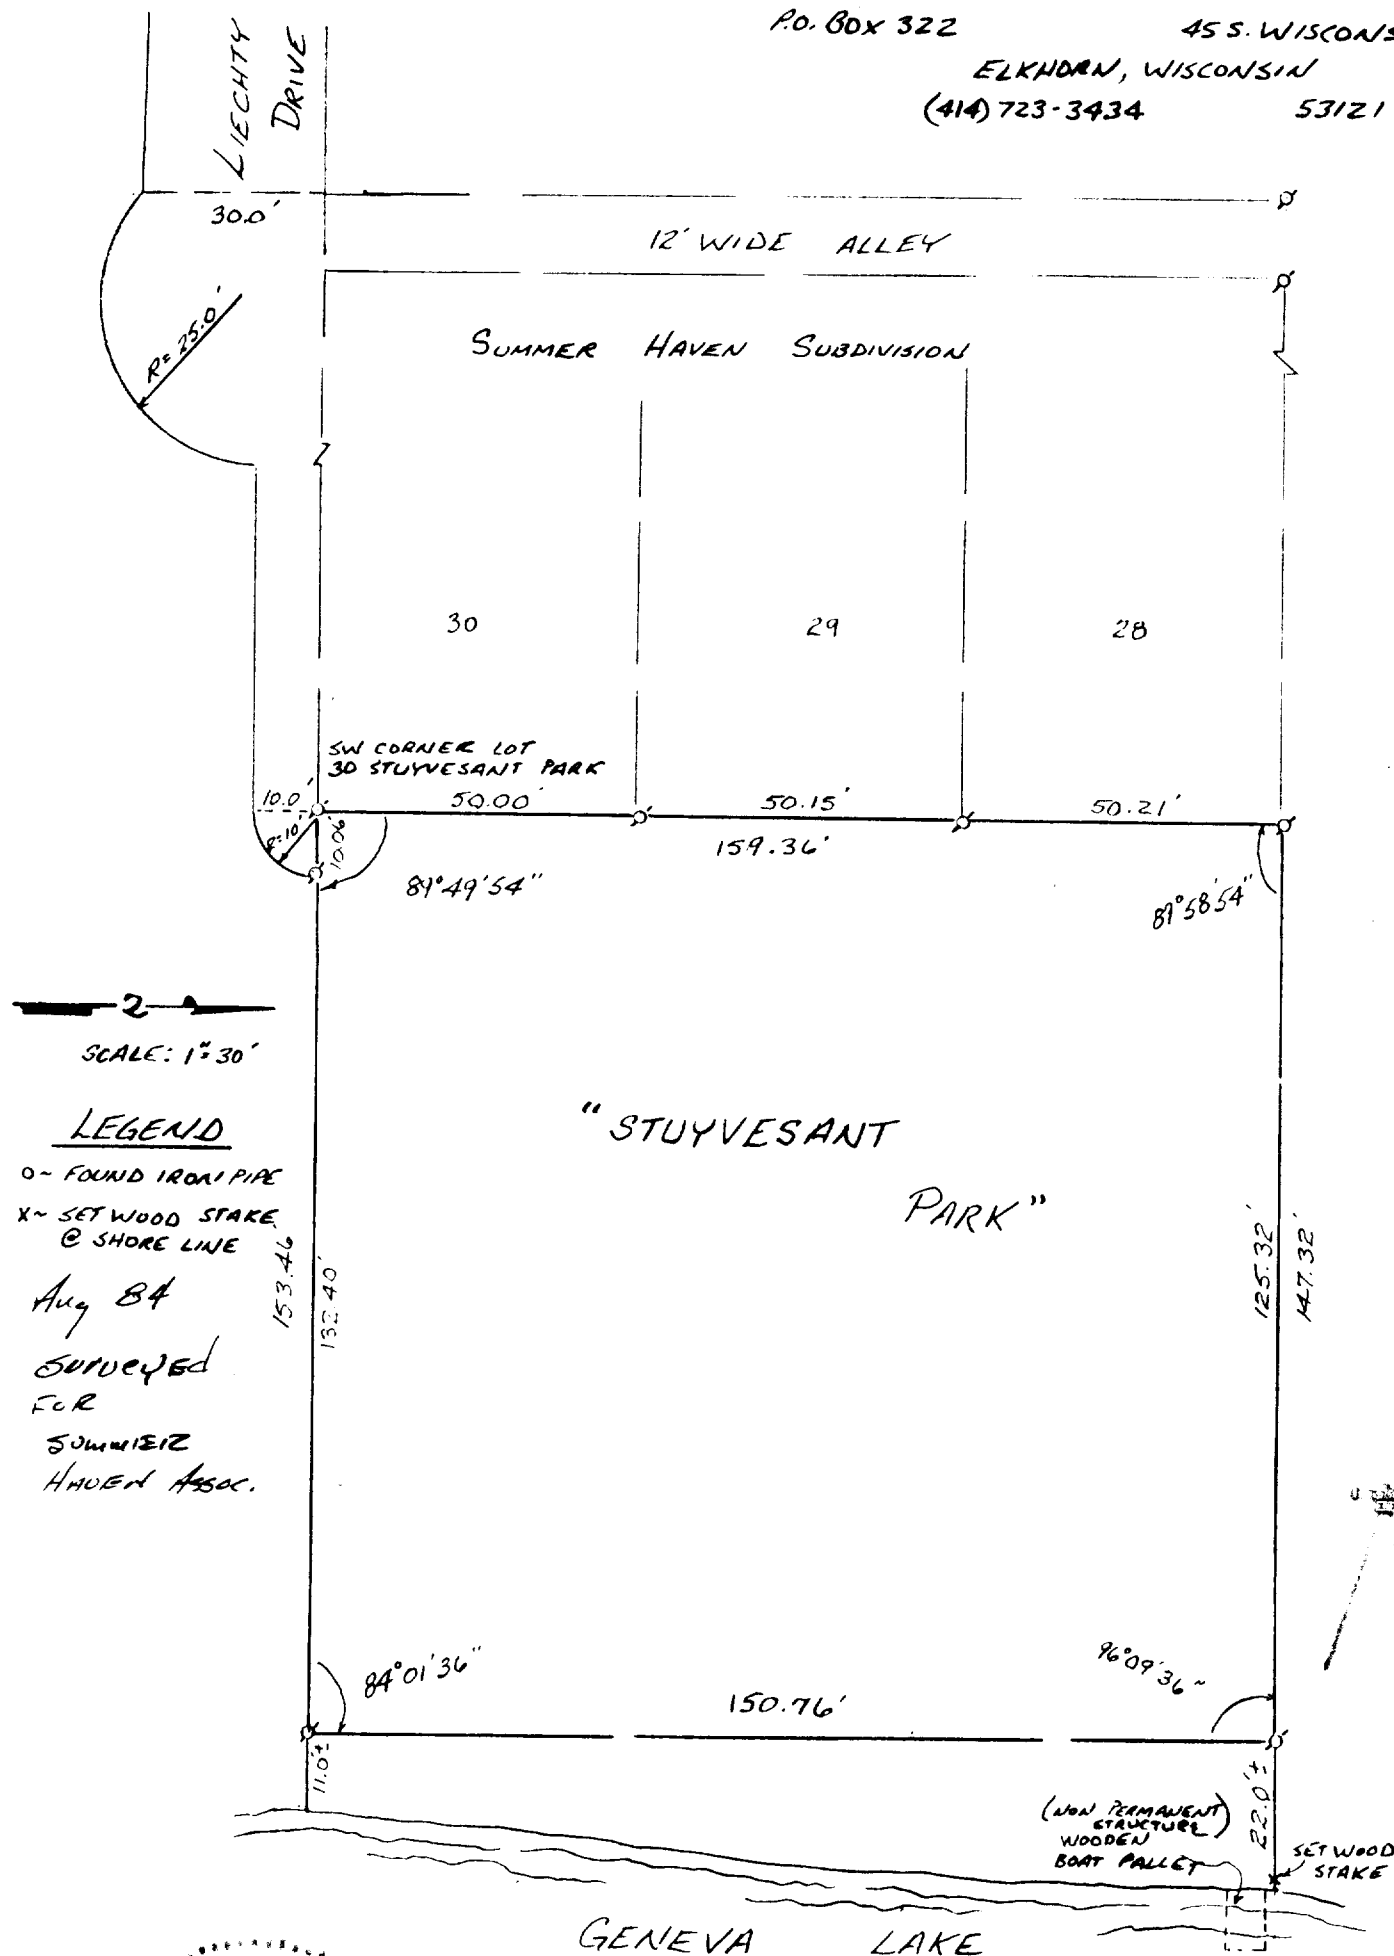

I HEREBY CERTIFY THAT THE ABOVE DESCRIBED  
PROPERTY HAS BEEN SURVEYED UNDER MY DIRECTION THAT  
THE PLAT HEREON IS AN ACCURATE SURVEY A TRUE  
REPRESENTATION THEREOF CORRECTLY SHOWS THE EXTERIOR  
BOUNDARY LINES ON SAID PROPERTY AND CORRECT MEAS-  
UREMENTS THEREOF

*Thomas A. Jensen*

1984.049

11-440-J

WSU-00050