

FARRIS, HANSEN & ASSOCIATES, INC.

ENGINEERING, SURVEYING & LAND PLANNING


718 W. WALWORTH ST. - BOX 407 - ELMHORN, WI.

PHONE: 414-733-2000

PROJ 2255

CHERRY STREET
(66.0' WIDE)

WILLIAMS STREET
(66.0' WIDE)

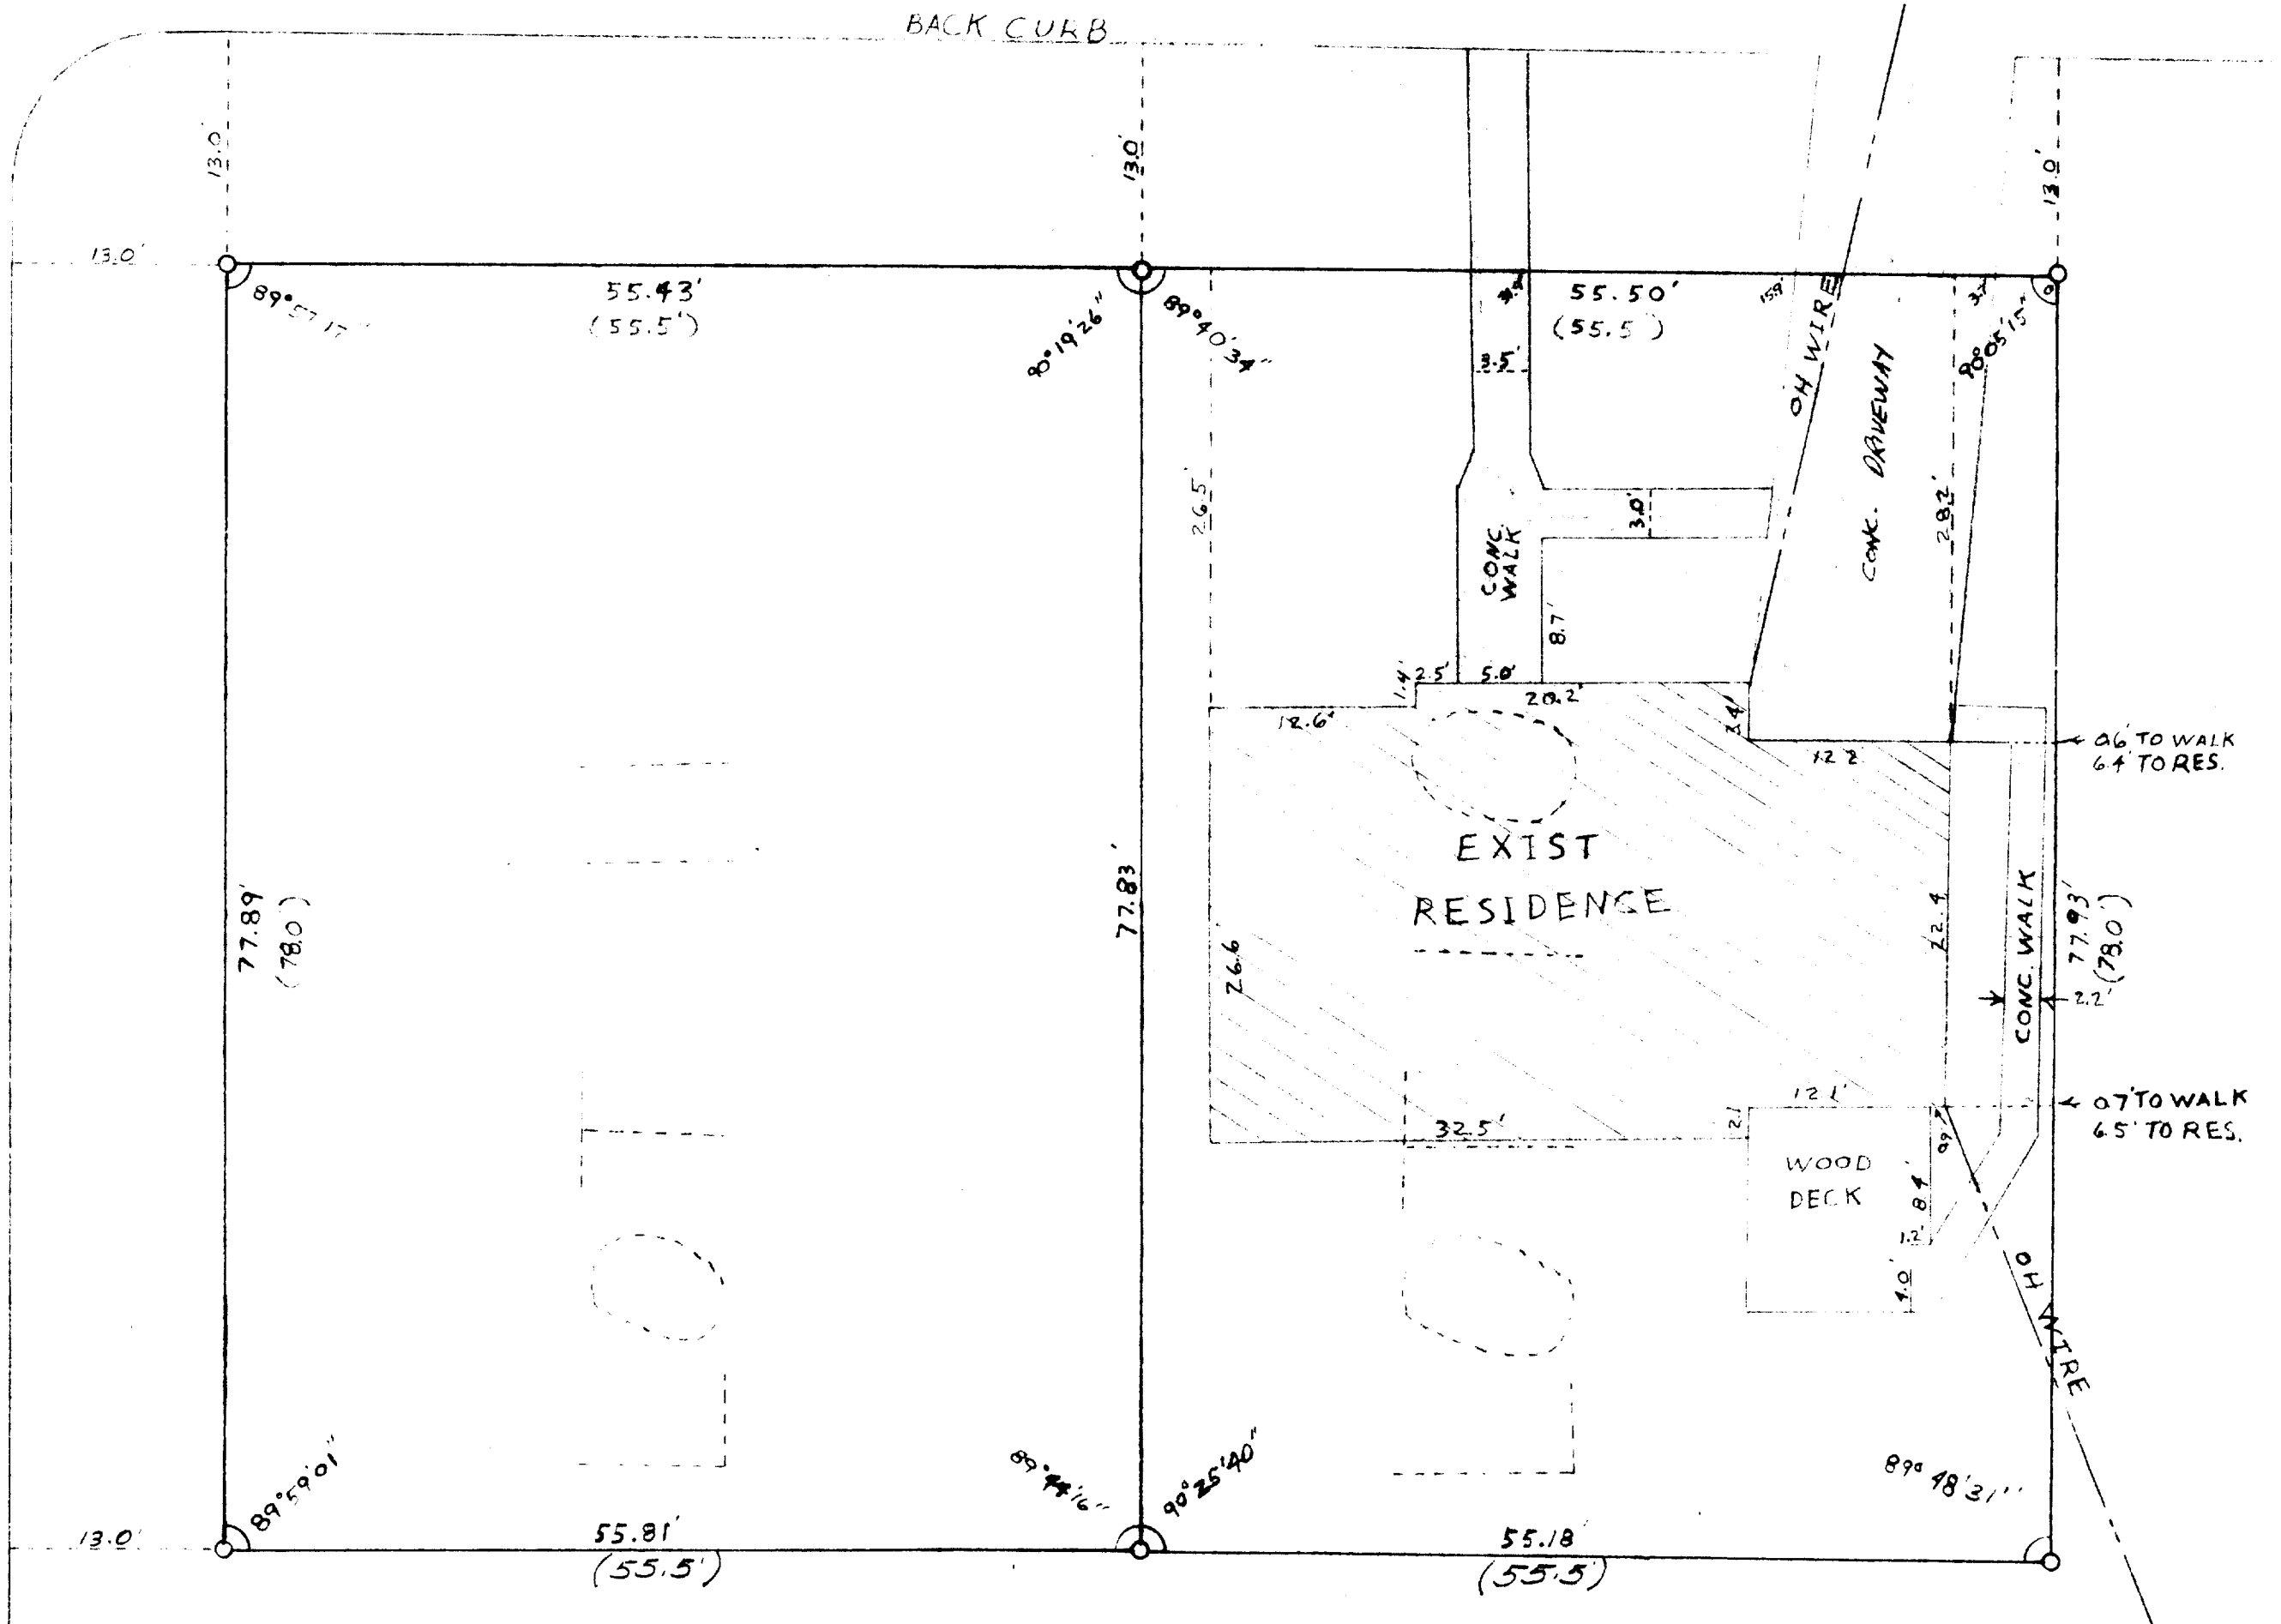

SCALE: 1"=10'

LEGEND

O - IRON PIPE FOUND

(---) - RECORDED DIMENSION

WORK ORDERED BY: REALTY WORLD MIDWEST
FOR: ROBERT & JOYCE ANDERSON

DRAWN BY: JOHN CALFERSON 5/22/84

PLAT OF SURVEY OF

THE NORTH 78 FEET OF LOTS 10 AND 11, BLOCK 3 OF THE
ORIGINAL PLAT OF THE VILLAGE OF WILLIAMS BAY,
WALWORTH COUNTY, WISCONSIN

I hereby certify that I have surveyed the above described property and that the above map is a true representation thereof and that the location of all the property, its corners, boundaries, the location of all the buildings, structures and structures of all principal buildings, structures, boundaries, structures, structures, structures and public easements, if any.

This survey is made for the use of the present owners of the property, and also those who purchase, mortgage, or otherwise acquire the title thereto within one (1) year from date hereof.



Robert A. Farris
ROBERT A. FARRIS

PROJ# 2255

11-441