


PLAT OF SURVEY OF

LOT 15 BLOCK 1, HARBOR VIEW SUBDIVISION, LOCATED
IN NE 1/4 SEC. 6, T1N, R1E, WILLIAMS BAY, WALWORTH COUNTY, WISCONSIN.

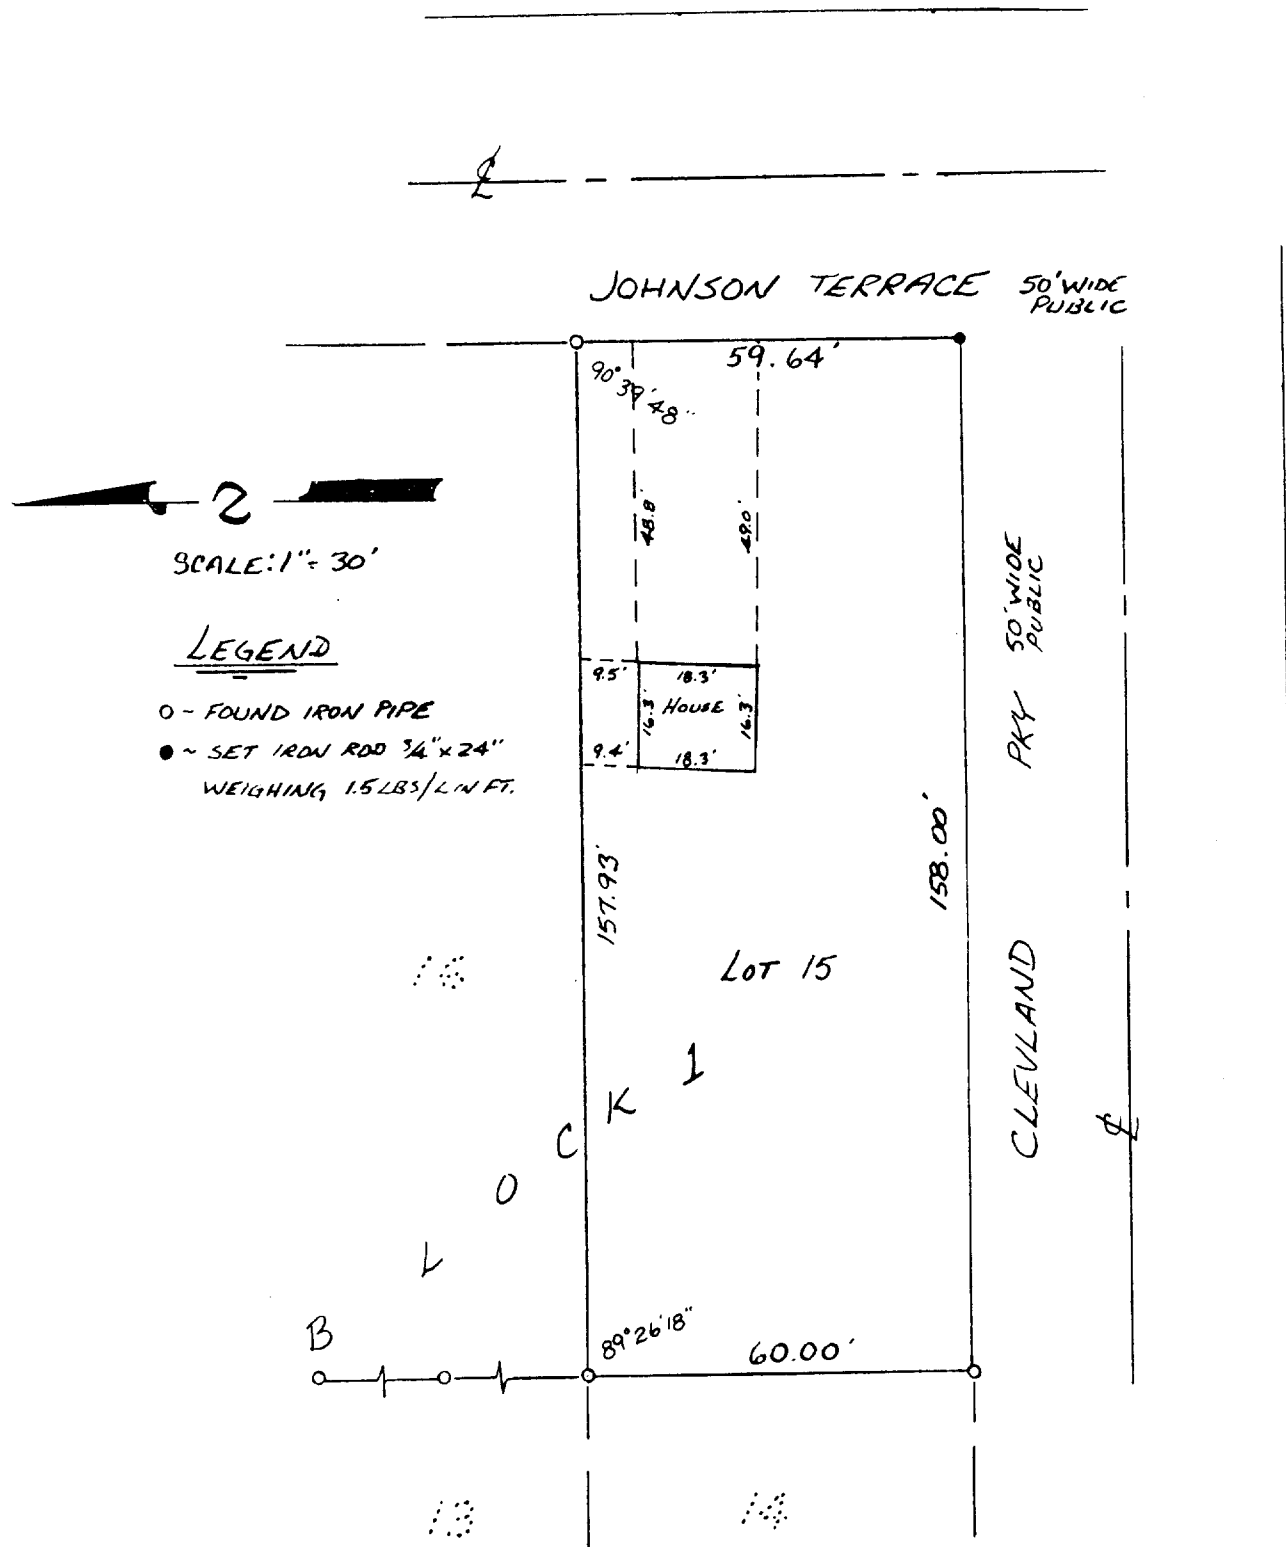

JENSEN SURVEYING & MAPPING S.C.

P.O. Box 322 ELKHORN, WISC 53115 45 S. WISCONSIN ST

SURVEYED: MIKE BRENNAN
FOR: HWY 67
WILLIAMS BAY, WIS.

I HEREBY CERTIFY THAT THE ABOVE DESCRIBED
PROPERTY HAS BEEN SURVEYED UNDER MY DIRECTION
THAT THE PLAT SHOWN HEREON IS AN ACCURATE SURVEY,
A TRUE REPRESENTATION THEREOF CORRECTLY SHOWS
THE EXTERIOR BOUNDARY LINES ON SAID PROPERTY
AND THE CORRECT MEASUREMENTS THEREOF AND
BUILDINGS THEREON.



THOMAS P.A. JENSEN RLS #1084

1984-062
11-441-J