



WALWORTH COUNTY
SURVEYING & MAPPING
LAKE GENEVA, WISCONSIN

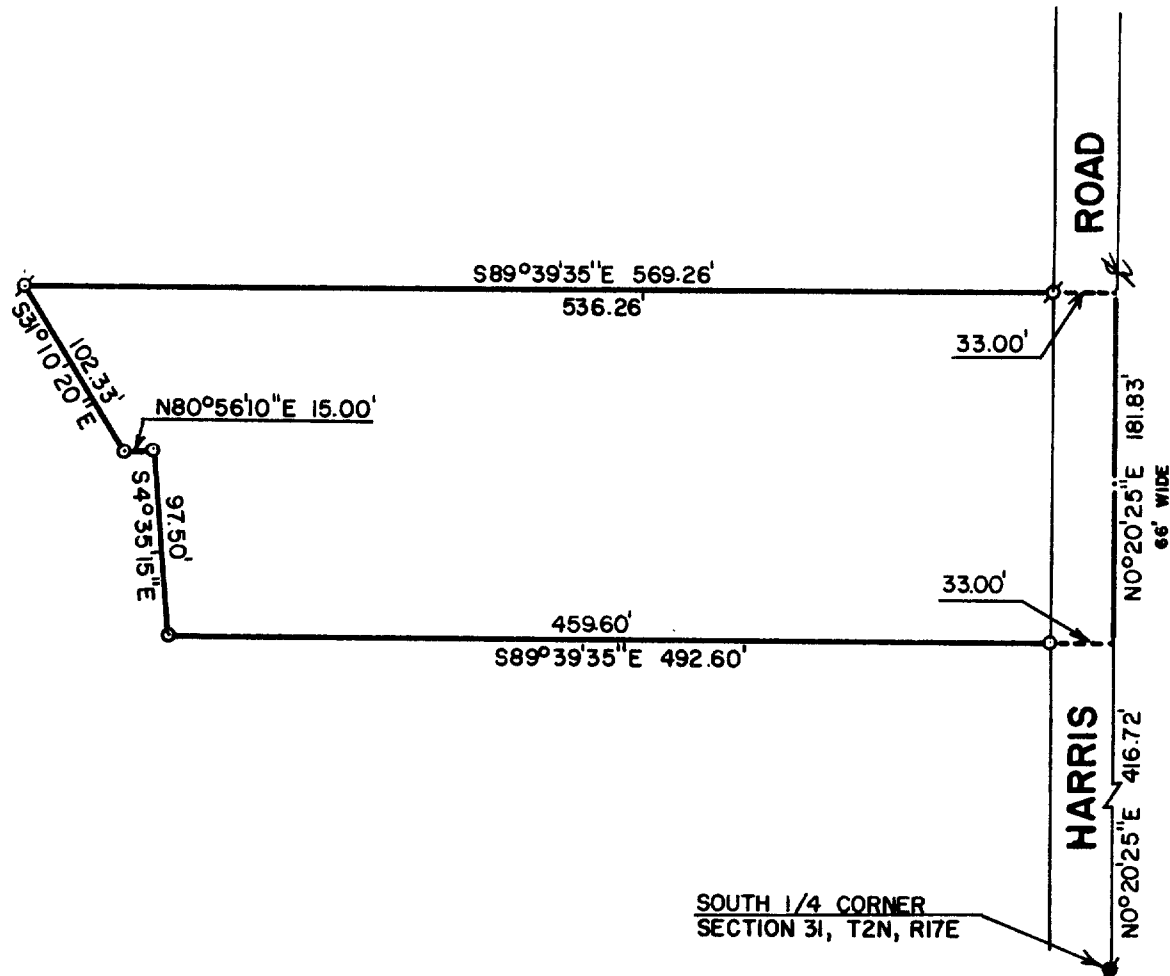

PLAT OF SURVEY OF

A PARCEL OF LAND LOCATED IN THE SOUTHWEST 1/4 OF SECTION 31, T 2 N, R 17 E, VILLAGE OF WILLIAMS BAY, WALWORTH COUNTY, WISCONSIN AND DESCRIBED AS FOLLOWS: COMMENCING AT THE SOUTH 1/4 CORNER OF SAID SECTION 31, THENCE N0°20'25"E 416.72 FEET TO THE PLACE OF BEGINNING; THENCE N89°39'35"W 492.60 FEET; THENCE N4°35'15"W 97.50 FEET; THENCE S80°56'10"W 15.00 FEET; THENCE N31°10'20"W 102.33 FEET; THENCE S89°39'35"E 569.25 FEET; THENCE S0°20'25"W 181.83 FEET TO THE PLACE OF BEGINNING, CONTAINING 2.16 ACRES OF LAND.

ORDERED BY: RON ANDERSON
KEEFE REAL ESTATE
704 MAIN STREET
LAKE GENEVA, WISCONSIN 53147

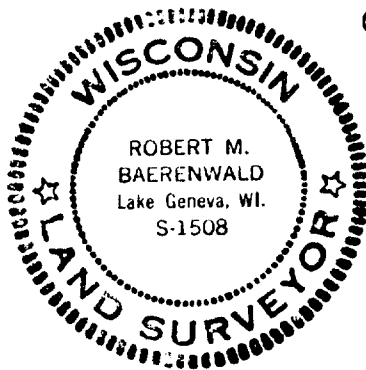

SCALE: 1"=100'

- - IRON PIPE FOUND
- - IRON PIPE PLACED
- - CONCRETE MONUMENT FOUND

I, ROBERT M. BAERENWALD, DO HEREBY CERTIFY THAT I HAVE SURVEYED THE PROPERTY HEREON DESCRIBED ACCORDING TO THE OFFICIAL RECORDS AND THAT THE PLAT HEREON IS A CORRECT REPRESENTATION OF THE PROPERTY LINES TO THE BEST OF MY KNOWLEDGE AND BELIEF.

Robert M. Baerenwald
ROBERT M. BAERENWALD
WISCONSIN REGISTERED LAND SURVEYOR, S-1508

DATE *June 6, 1984*

JOB NO. 0011-2

WWWDP-101

11-447-RB