




D.D. COOPER & CO. INC.

ROUTE 4, BOX 501 B
ELECTRON, WI 53121

PH 414-723-6265

SURVEYING • MODULAR MONIES

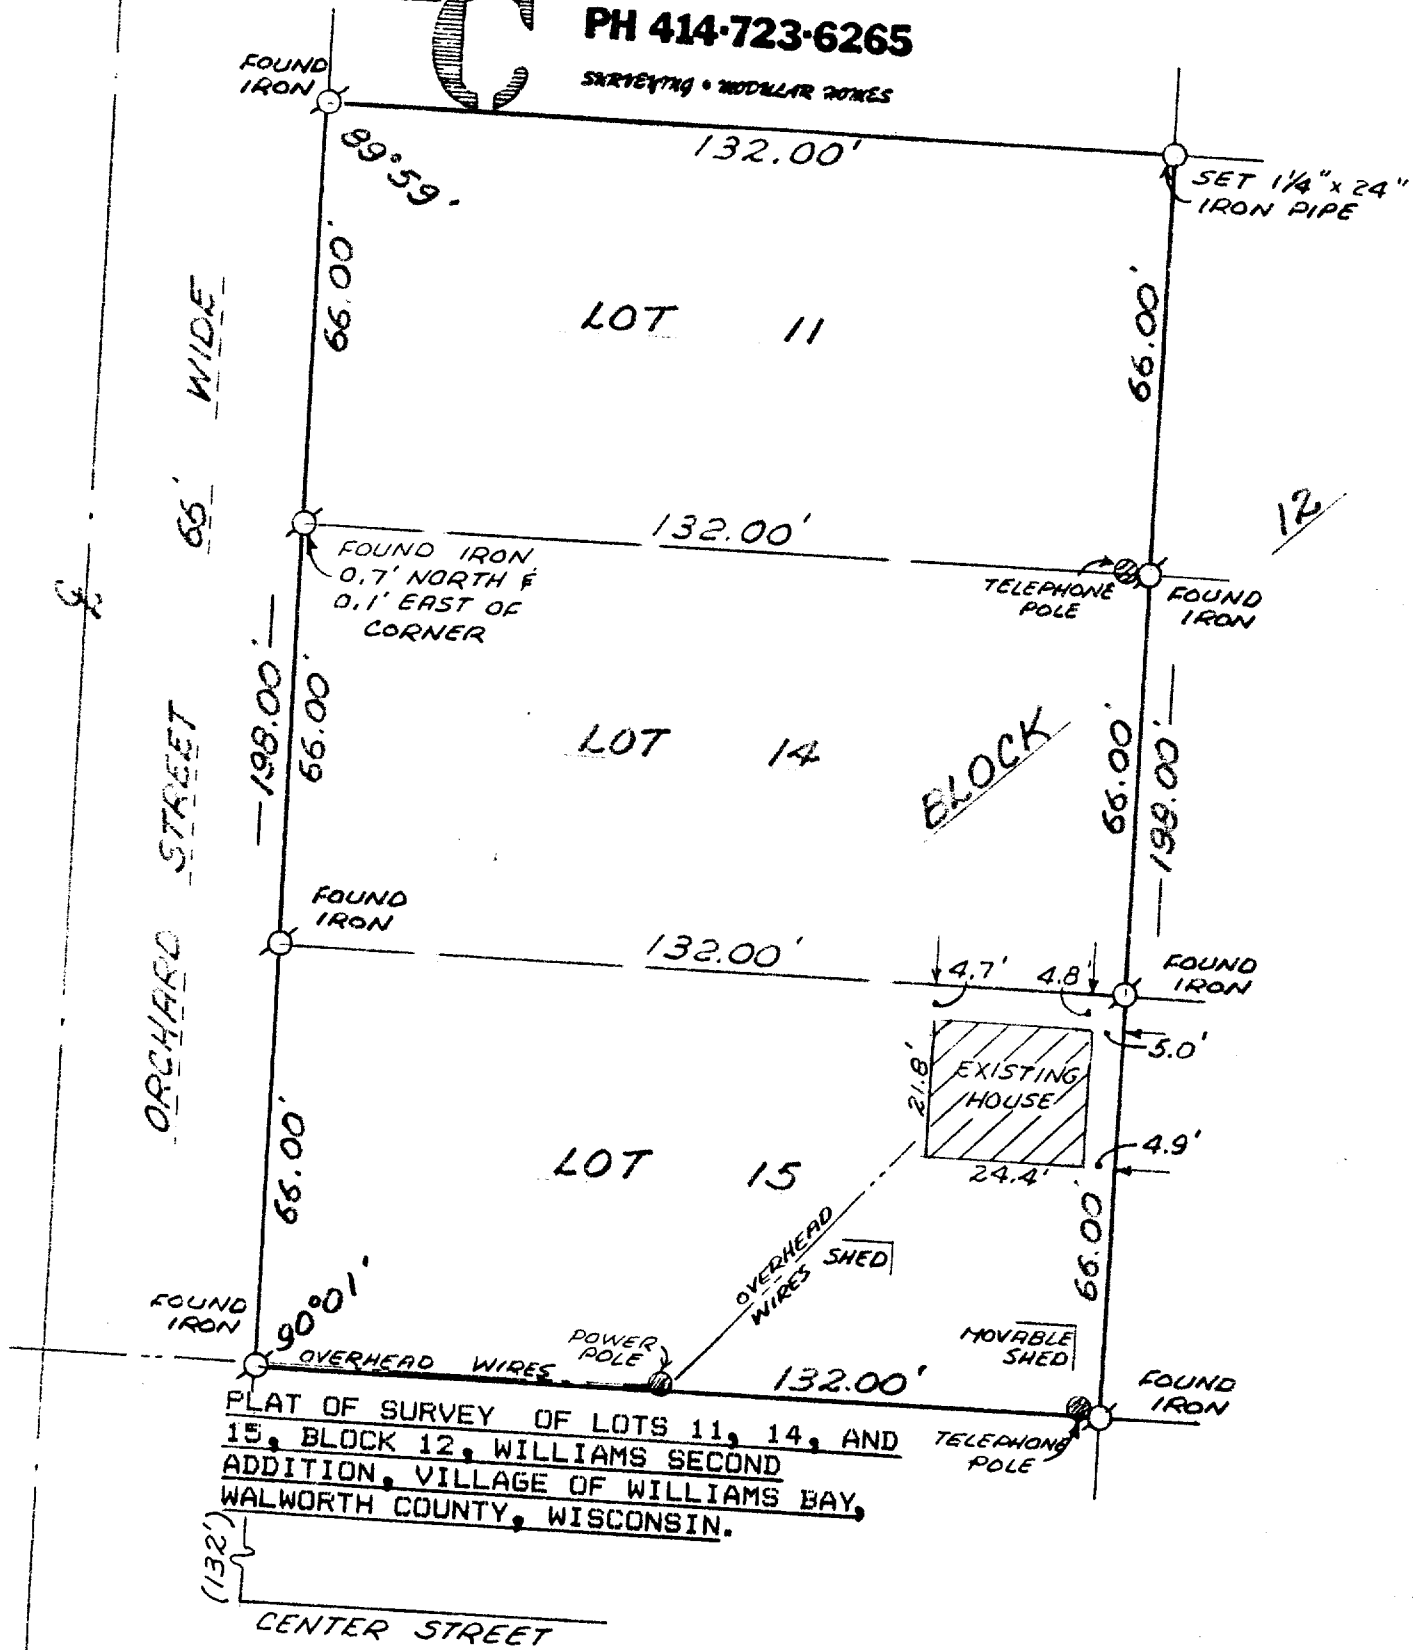

PLAT OF SURVEY OF LOTS 11, 14, AND 15, BLOCK 12, WILLIAMS SECOND ADDITION, VILLAGE OF WILLIAMS BAY, WALWORTH COUNTY, WISCONSIN.

CENTER STREET


I, DANIEL D. COOPER, REGISTERED SURVEYOR, DO HEREBY CERTIFY THAT I HAVE SURVEYED THE PROPERTY DESCRIBED HEREON AND THAT THE MAP SHOWN HEREON IS A TRUE AND ACCURATE REPRESENTATION THEREOF TO THE BEST OF MY PROFESSIONAL KNOWLEDGE AND BELIEF.

DATED THIS 4th DAY OF Oct., 1984

Daniel D. Cooper

DANIEL D. COOPER, RLS NO. S-14

- LEGEND
- — IRON PIPE FOUND
 - — IRON PIPE SET
 - () — RECORD DIMENSION

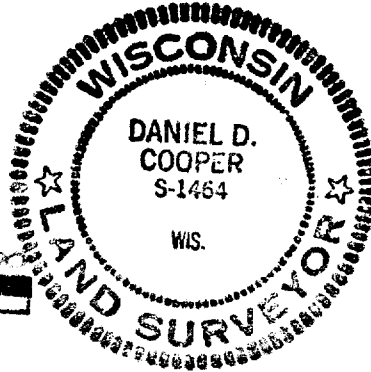

ORDERED BY:
KAY FRANZEN

PROJ. NO. 1981



WOP-181.184