


GEORGE T. DUNHAM
SURVEYING & SUBDIVIDING
DELAVER, WISCONSIN

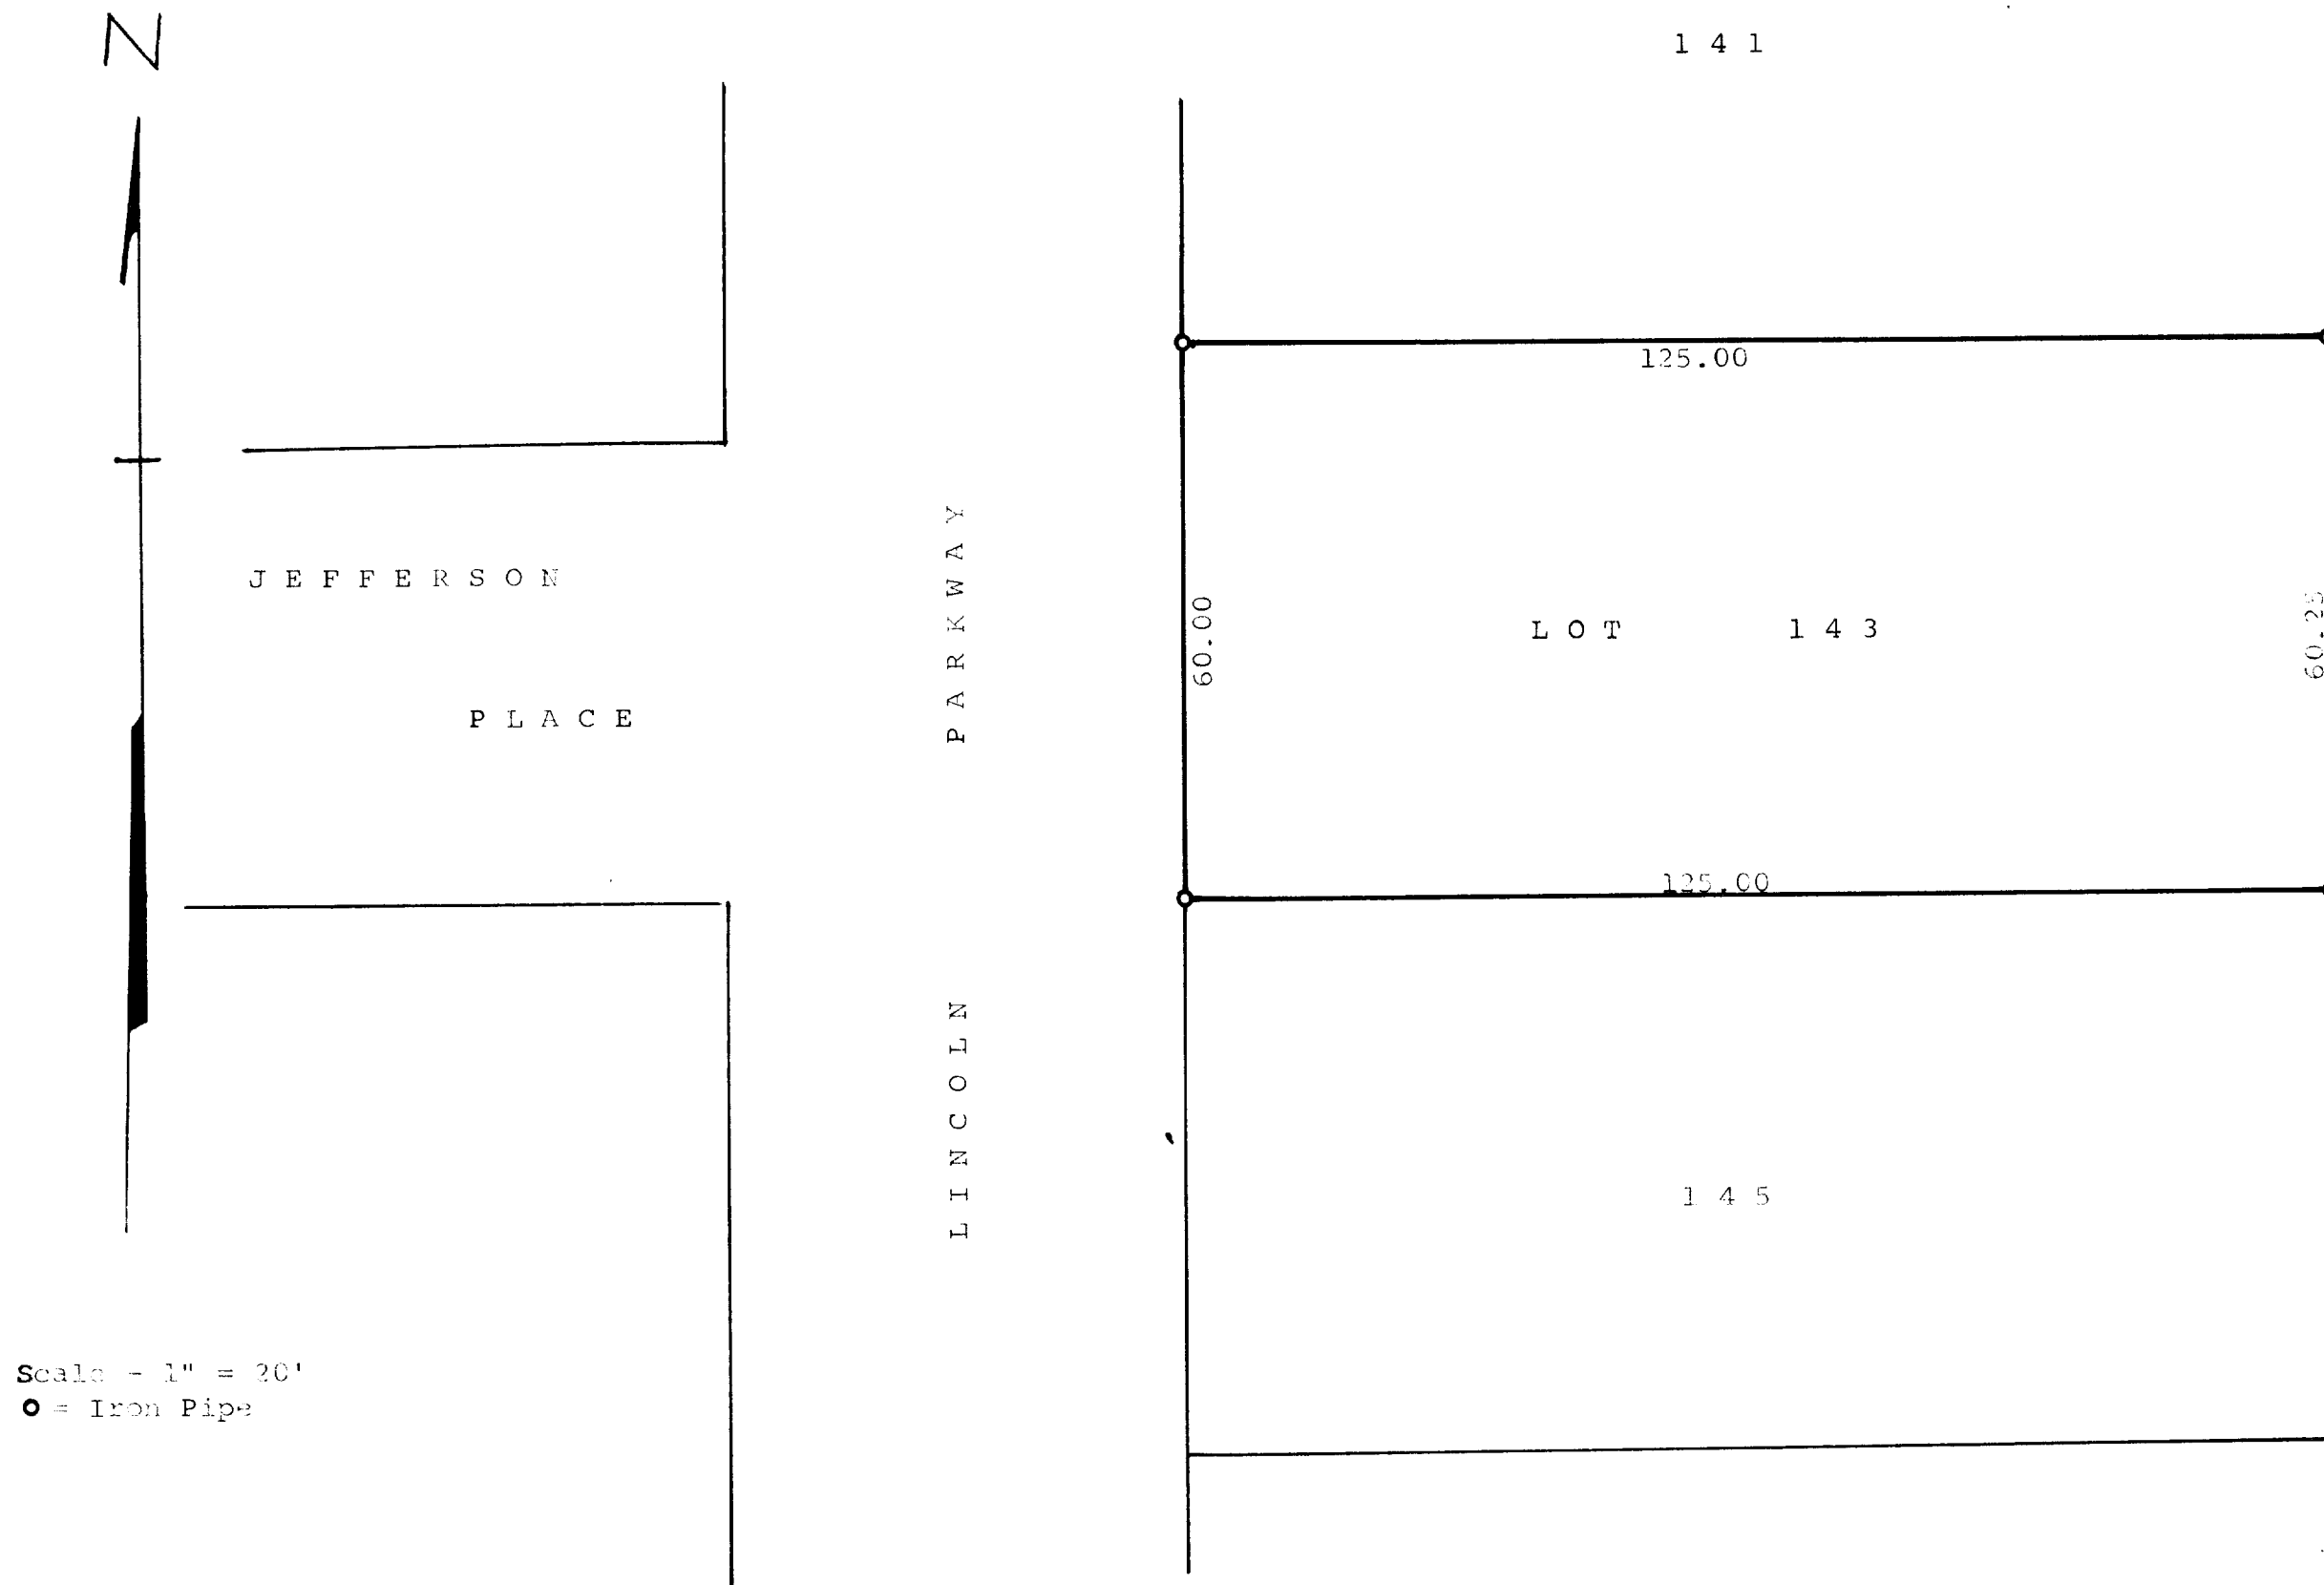

Plot of survey of Lot 143 in Cedar Point Park,
Village of Williams Bay, Walworth County, Wisconsin.
May 27, 1965

George T. Dunham
George T. Dunham, Surveyor

11-45