


PLAT OF SURVEY
LOT 21 WILLABAY WOODS
VILLAGE OF WILLIAMS BAY
WALWORTH CO. WI.

(XXX) RECORD DIMENSION
O = IRON PIPE SURVEY
STAKE FOUND.

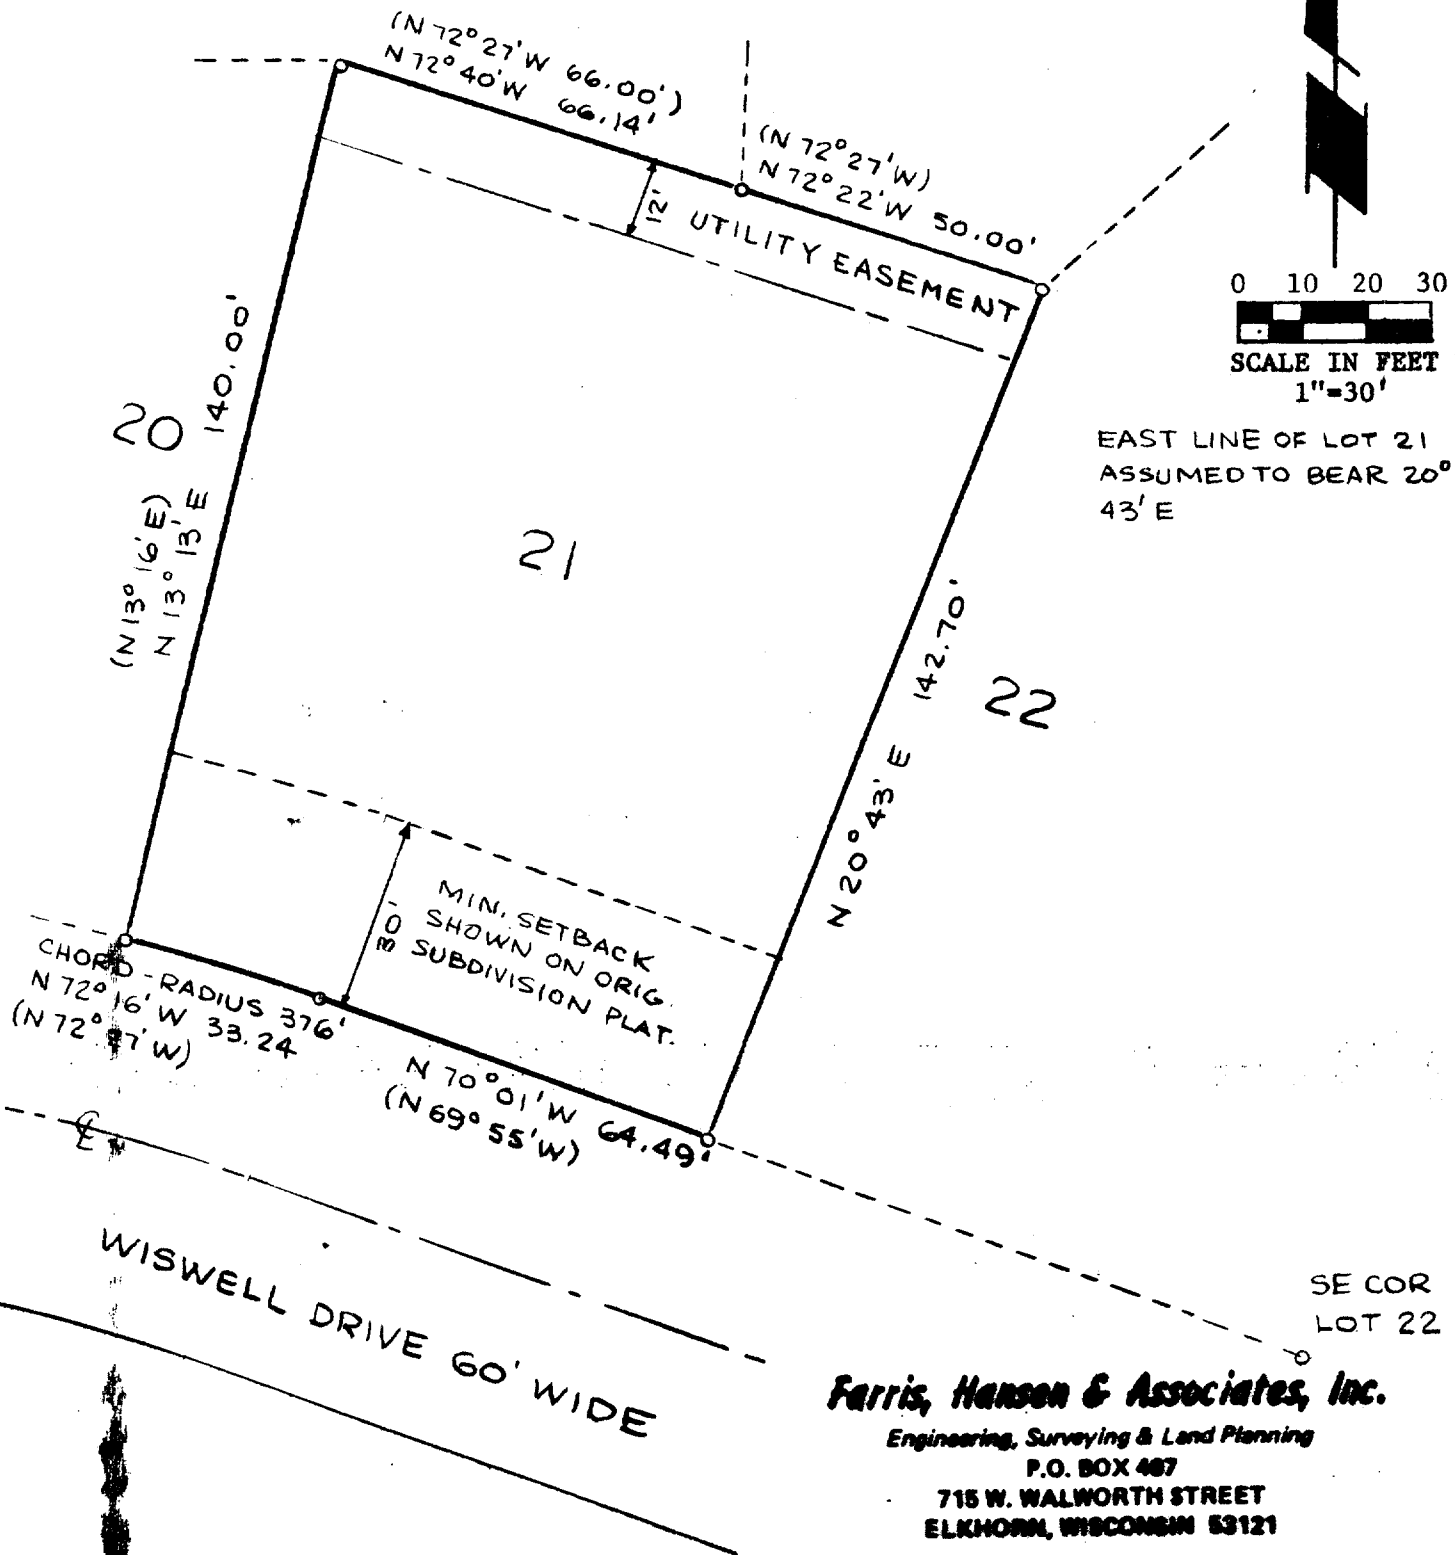


Farris, Hanson & Associates, Inc.

Engineering, Surveying & Land Planning
P.O. BOX 487
715 W. WALWORTH STREET
ELKHORN, WISCONSIN 53121

I HEREBY CERTIFY THAT THIS PLAT IS A TRUE
AND ACCURATE REPRESENTATION OF THE
BOUNDARY LINES TO THE BEST OF MY
KNOWLEDGE & BELIEF.

Robert A. Farris
ROBERT A. FARRIS

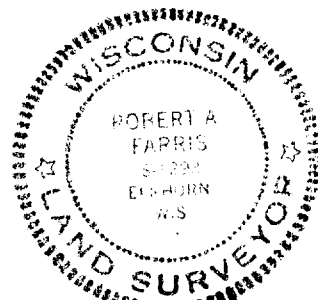

SURVEY ORDERED BY MRS.
ELSIE LINKA FOR MR. ROBERT
LINKA.

DATED 17 OCTOBER 1984

PROJECT NO. 2323

11-451