


PLAT OF SURVEY
LOT 21 WILLABAY WOODS
VILLAGE OF WILLIAMS BAY
WALWORTH CO. WI.

(XXX) RECORD DIMENSION
O = IRON PIPE SURVEY
STAKE FOUND.

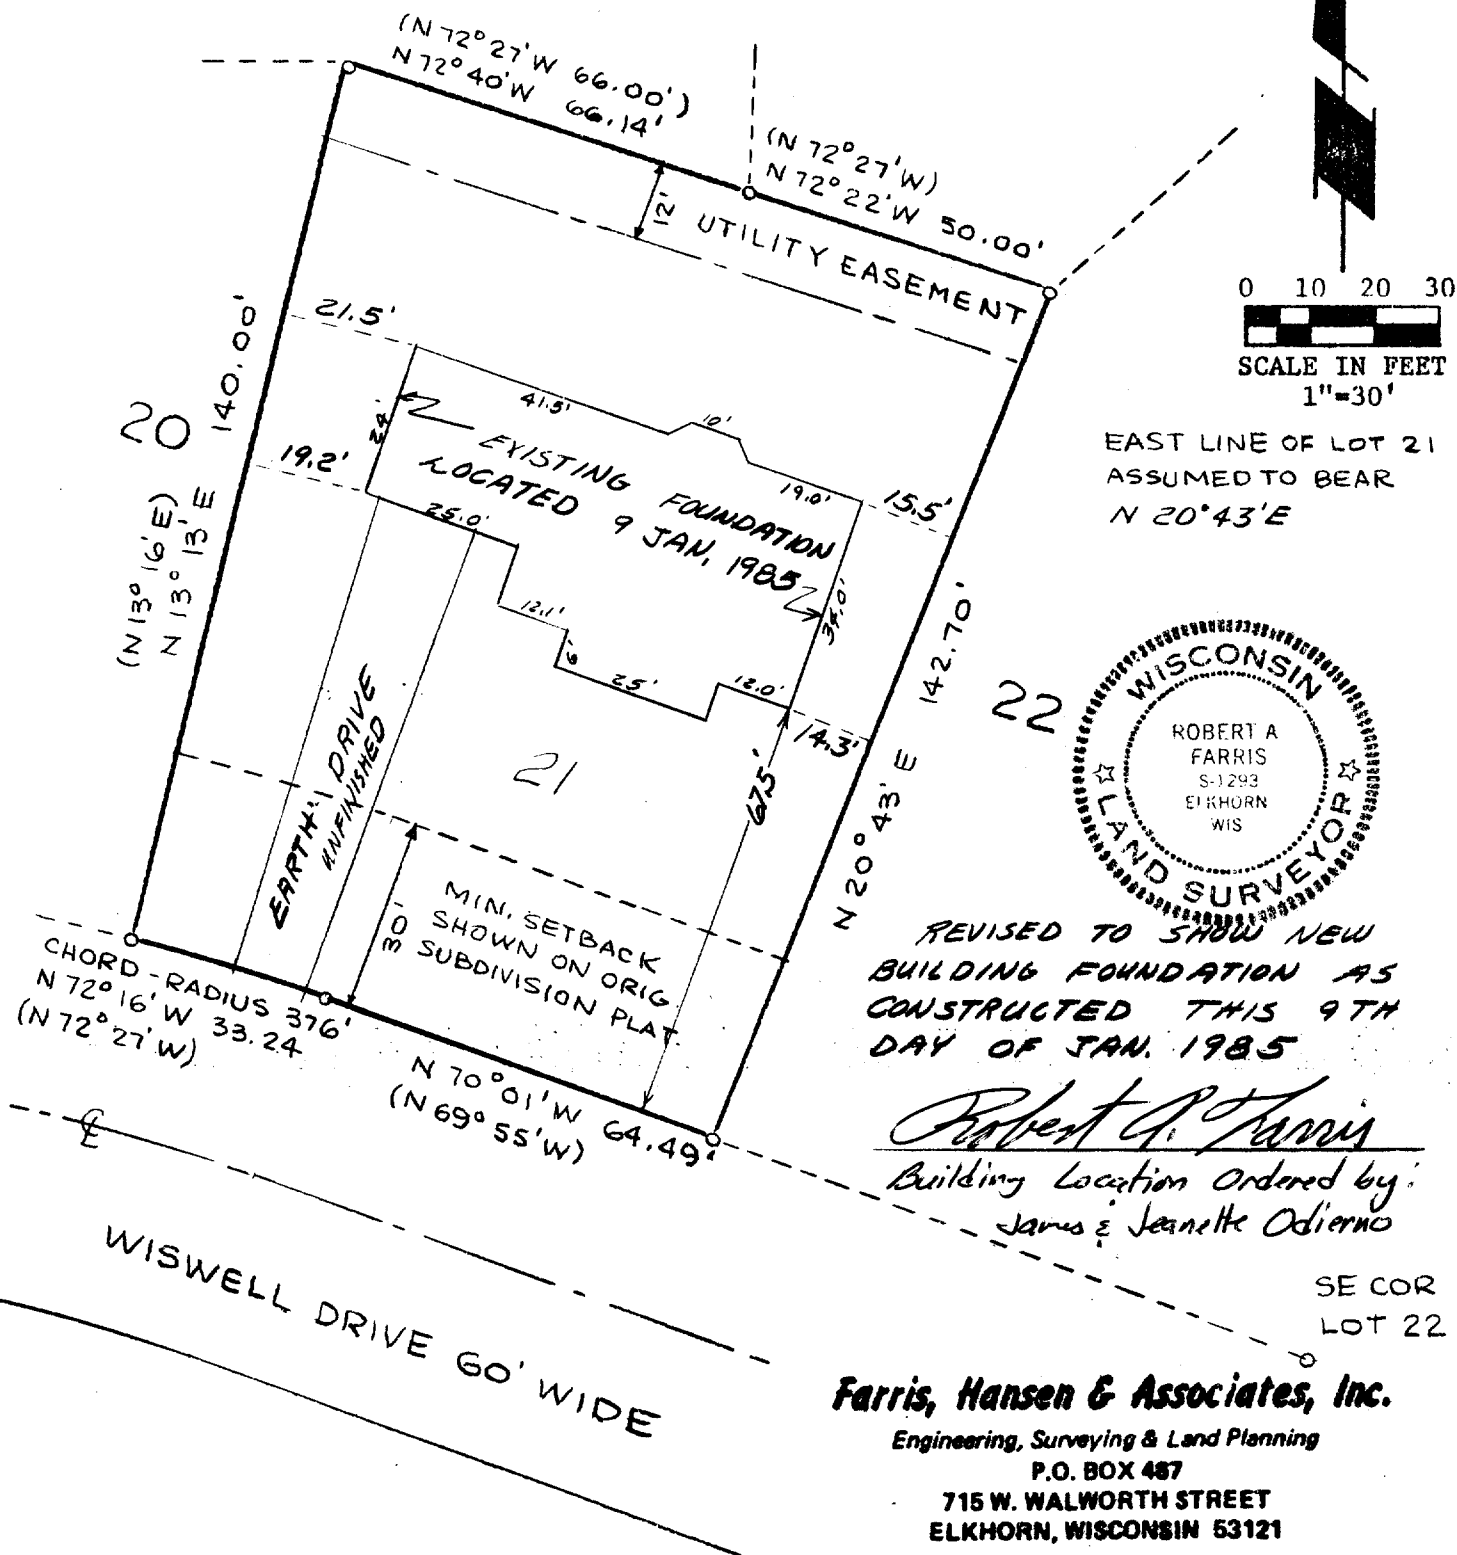

I HEREBY CERTIFY THAT THIS PLAT IS A TRUE
AND ACCURATE REPRESENTATION OF THE
BOUNDARY LINES TO THE BEST OF MY
KNOWLEDGE & BELIEF.

Robert A. Farris
ROBERT A. FARRIS

SURVEY ORDERED BY MRS.
ELSIE LINKA FOR MR. ROBERT
LINKA.

PROJECT NO. 2323

DATED 17 OCTOBER 1984
REVISED 9 JANUARY 1985