

2461

FARRIS, HANSEN & ASSOCIATES, INC.


ENGINEERING, SURVEYING & LAND PLANNING

710 E. WALNUT ST. - BOX 487 - ELKHORN, WI.

PHONE: 414-783-8888

LOT 11, WILLABAY WOODS
VILLAGE OF WILLIAMS BAY, WALWORTH COUNTY
WISCONSIN

I hereby certify that I have surveyed the above described property and that the above map is a true representation thereof and show the size and location of the property, its exterior boundaries, the location of all visible structures and dimensions of all principal buildings thereon, boundary fences, apparent easements, roadways and visible encroachments, if any.
This survey is made for the use of the present owners of the property, and also those who purchase, mortgage, or guarantee the title thereto within one (1) year from the date hereof.

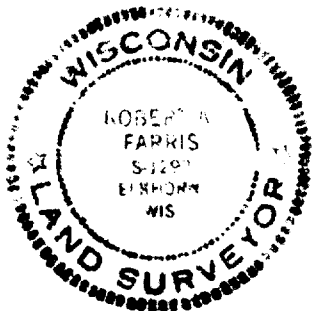


Robert A. Farris

RE-SURVEYED AND RE-CERTIFIED
THIS 6TH DAY OF SEPT., 1985.

WILLABAY DRIVE

(N 0°00'40" E 101.00')
N 0°05' E 101.02'

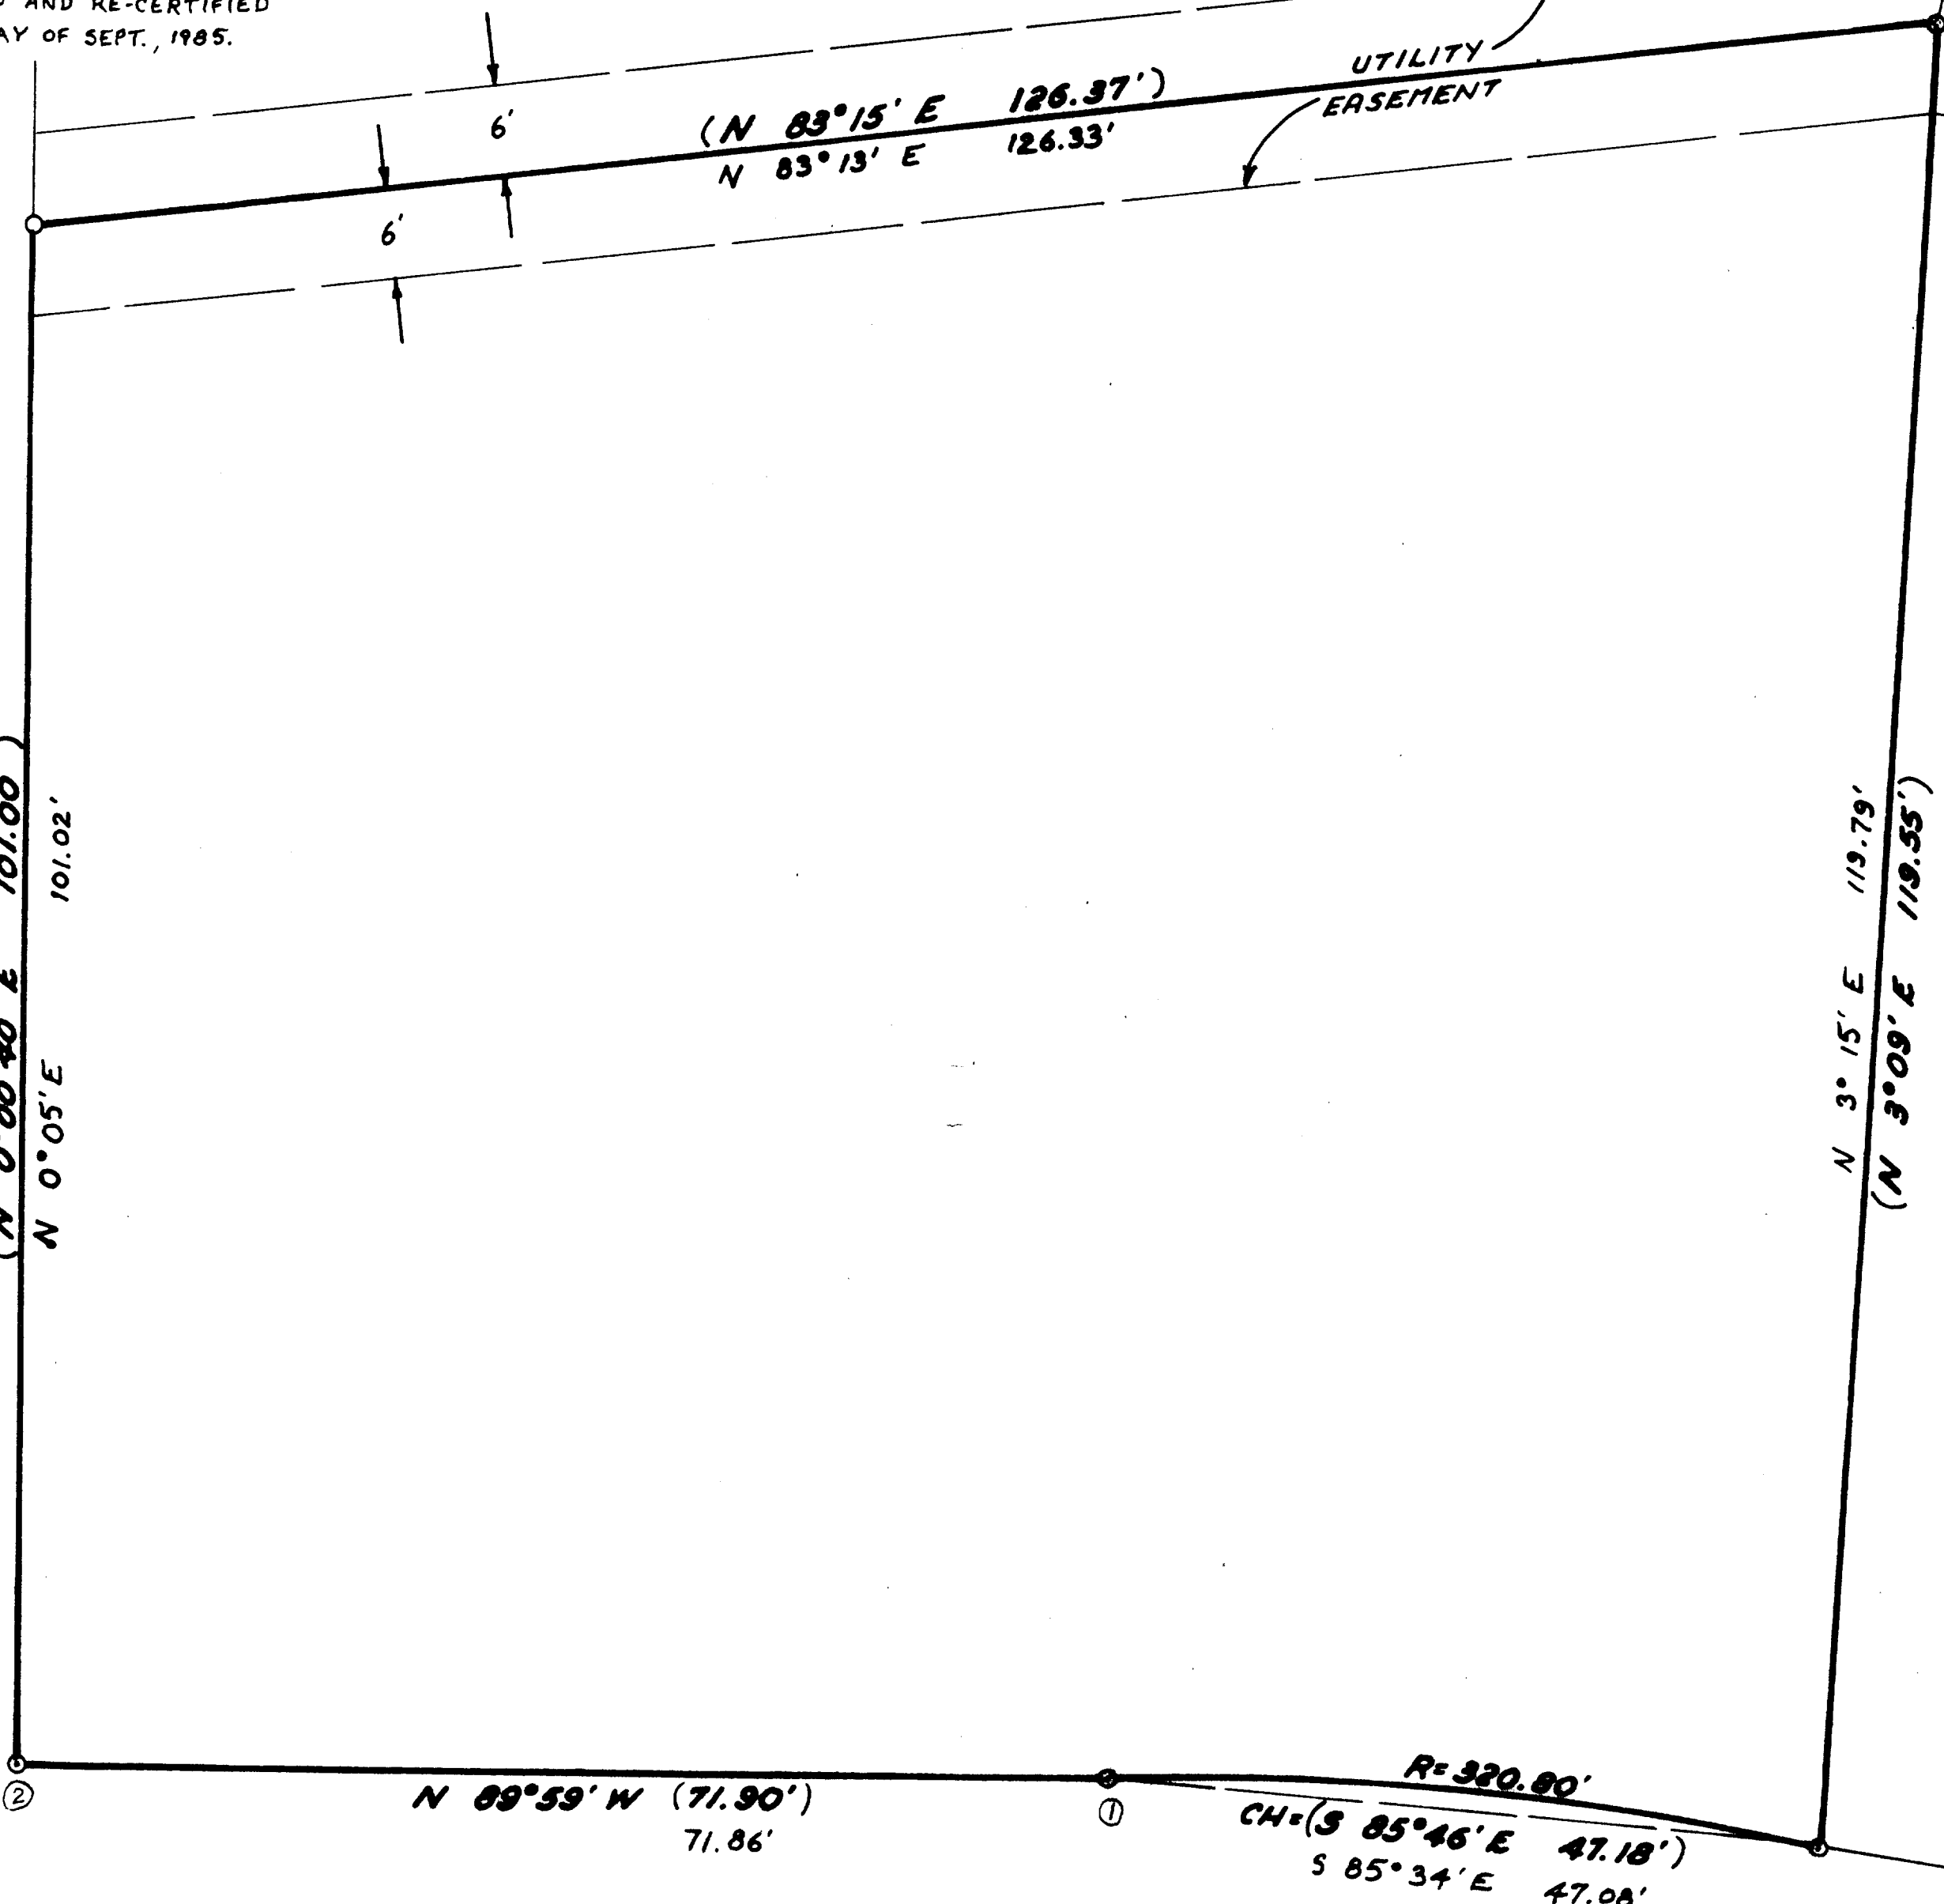

WISWELL DRIVE


NOTE: LINE ①-② N 89°59' W AS SHOWN
ON THE SUBDIVISION PLAT OF
WILLABAY WOODS.

PLAT OF SURVEY OF

LOT 11, WILLABAY WOODS, A SUBDIVISION
LOCATED IN THE NORTHEAST 1/4 OF SECTION
6, TOWN 1 NORTH, RANGE 17 EAST, VILLAGE
OF WILLIAMS BAY, WALWORTH COUNTY, WIS.

WORK ORDERED BY: MIDWEST REALTY

○ — 2" DIA. IRON PIPE FOUND
○ — 1" DIA. IRON PIPE FOUND

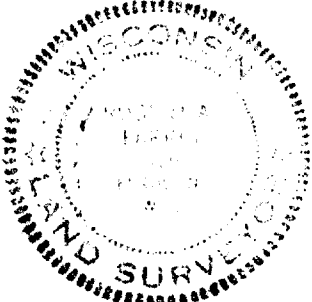

I HEREBY CERTIFY THAT THIS PLAT IS A TRUE
AND ACCURATE REPRESENTATION OF THE LOT LINES
TO THE BEST OF MY PROFESSIONAL KNOWLEDGE
AND BELIEF.

Robert A. Farris
ROBERT A. FARRIS, RLS

26 Nov. 1982
DATE

PROJECT NO. 2461