
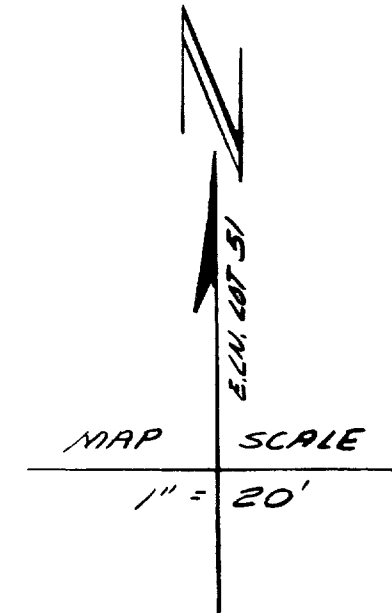


FARRIS, HANSEN & ASSOC., INC.
7 RIDGEWAY COURT
ELTHORN, WI.


LIECHTY DRIVE
(30' WIDE)

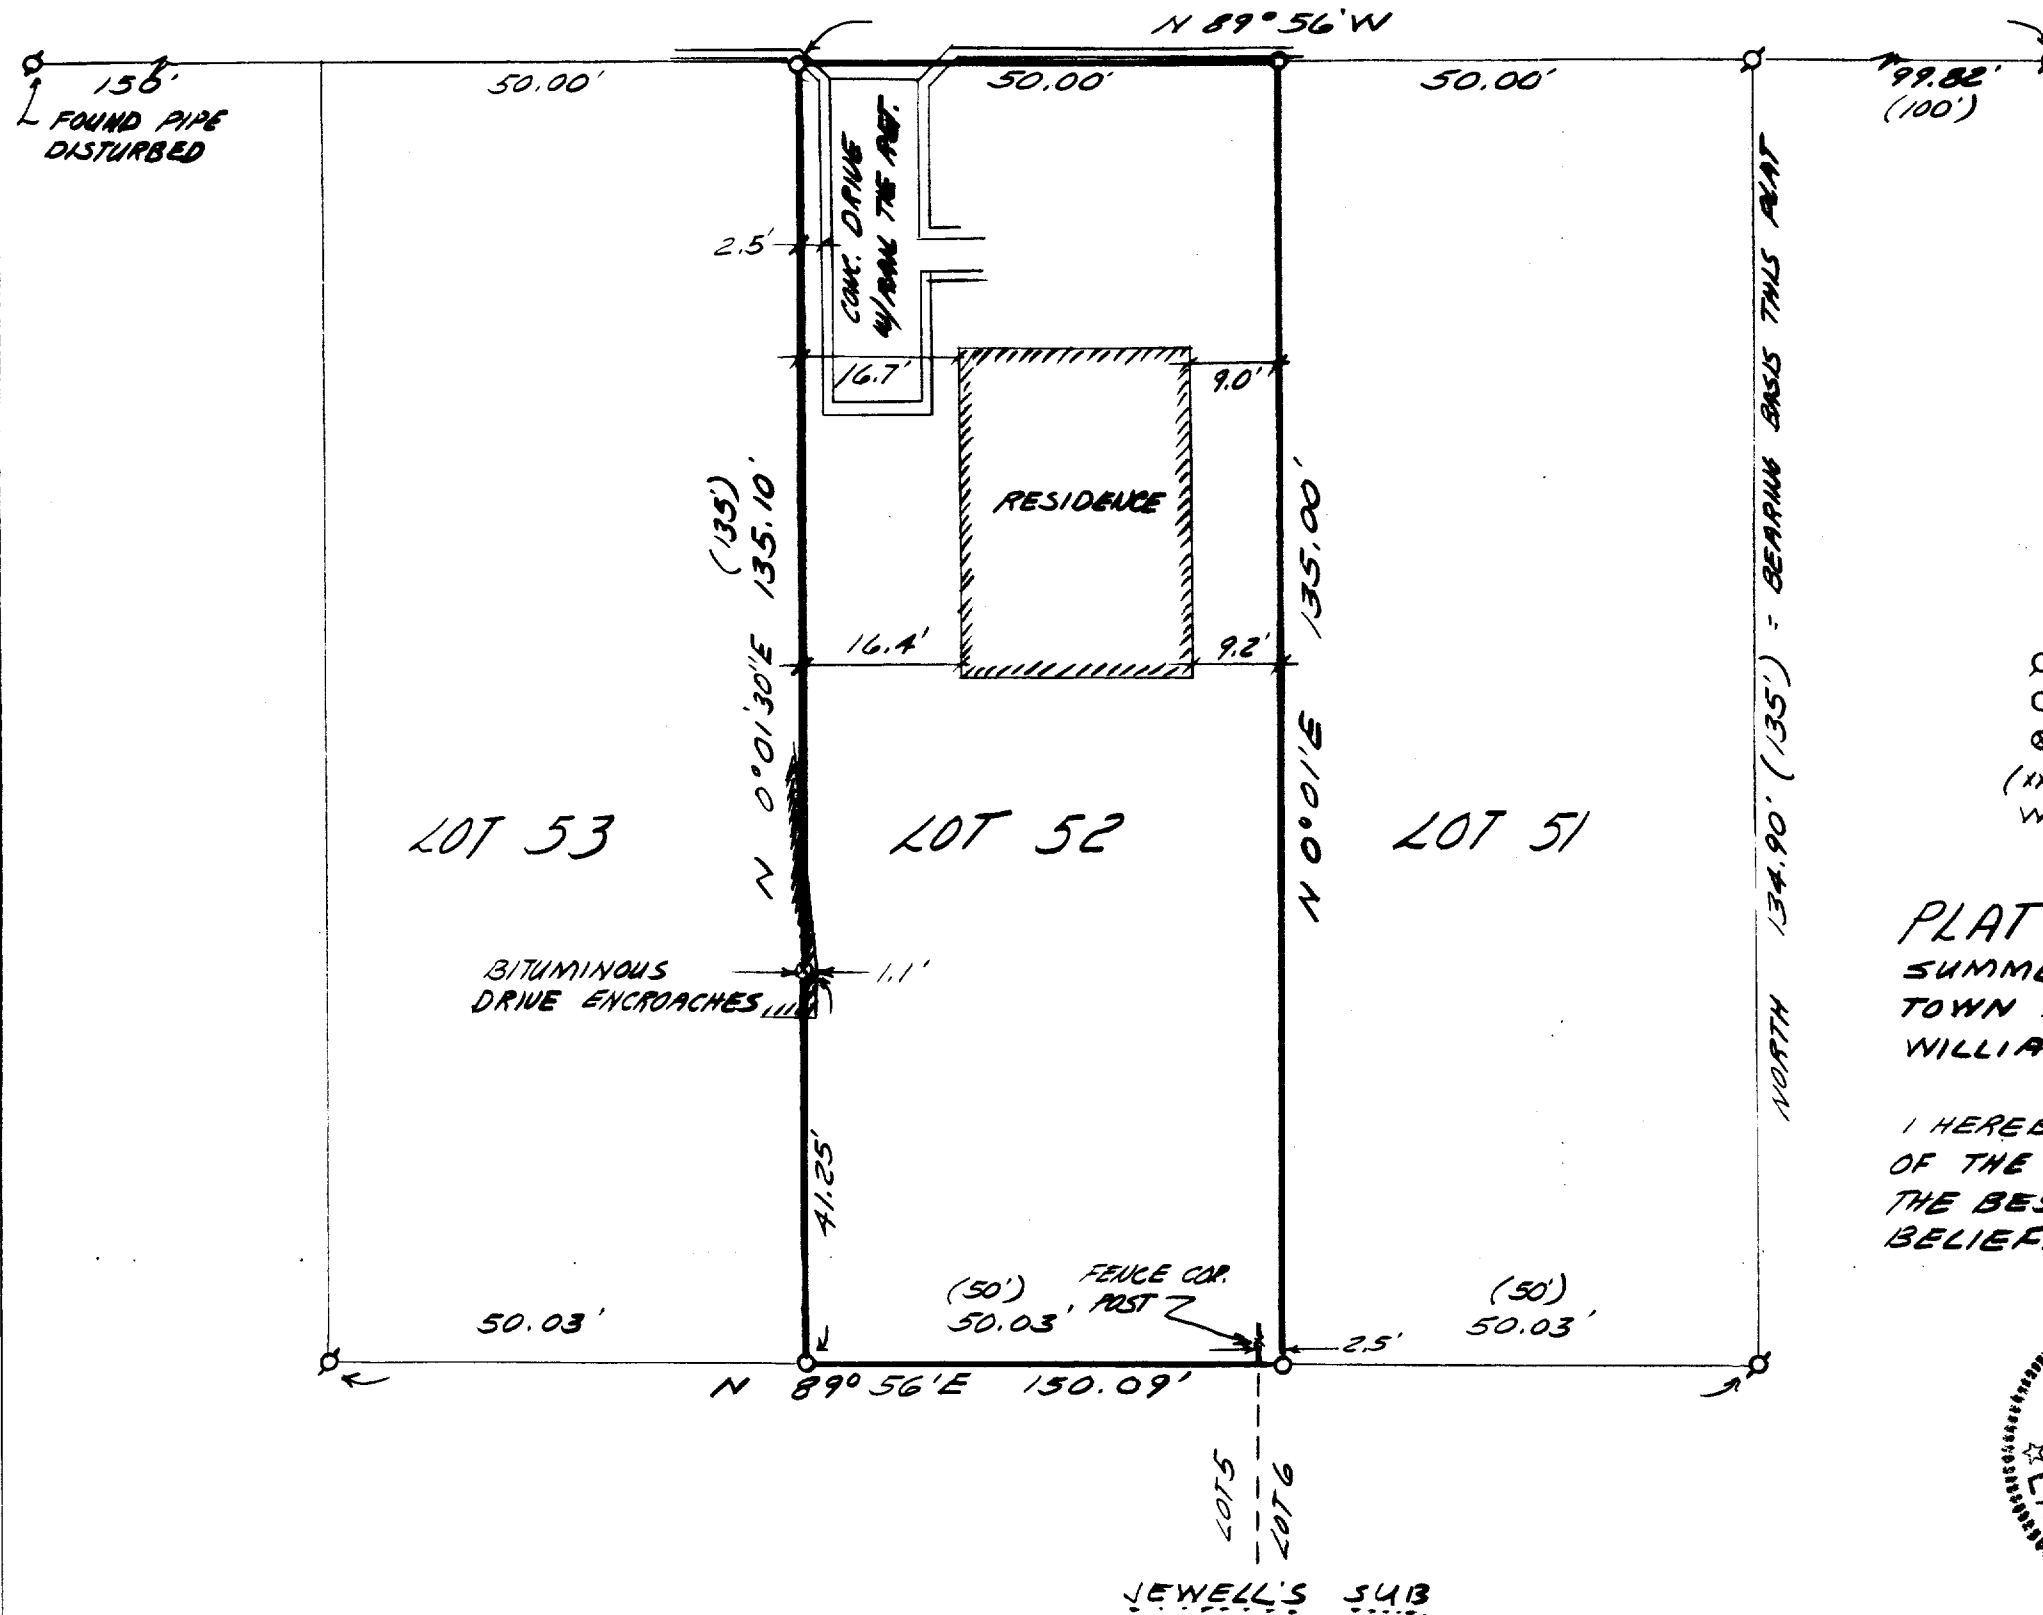

- = IRON PIPE SURVEY STAKE FOUND
 - = IRON PIPE STAKE SET
 - ⊙ = CONCRETE NAIL (PK) SET IN PAVEMENT
 - (XXX) = ORIGINAL SUBDIVISION PLAT DIMENSION
- WORK ORDERED BY SUSAN ACKLEY

PLAT OF SURVEY OF LOT 52 OF
SUMMER HAVEN LOCATED IN SE 1/4 SECTION 1,
TOWN 1 NORTH, RANGE 16 EAST, VILLAGE OF
WILLIAMS BAY, WALWORTH COUNTY, WISCONSIN

I HEREBY CERTIFY THIS PLAT IS A TRUE REPRESENTATION
OF THE LOT LINES AND OTHER FEATURES SHOWN TO
THE BEST OF MY PROFESSIONAL KNOWLEDGE AND
BELIEF.

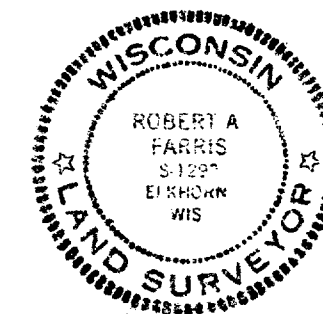

Robert A. Farris
DATED 5/23/85

PROJECT NO. 2413