
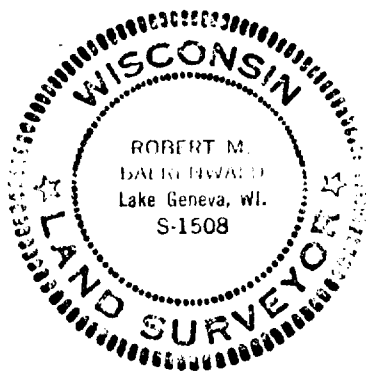


WALWORTH COUNTY
SURVEYING & MAPPING
LAKE GENEVA, WISCONSIN

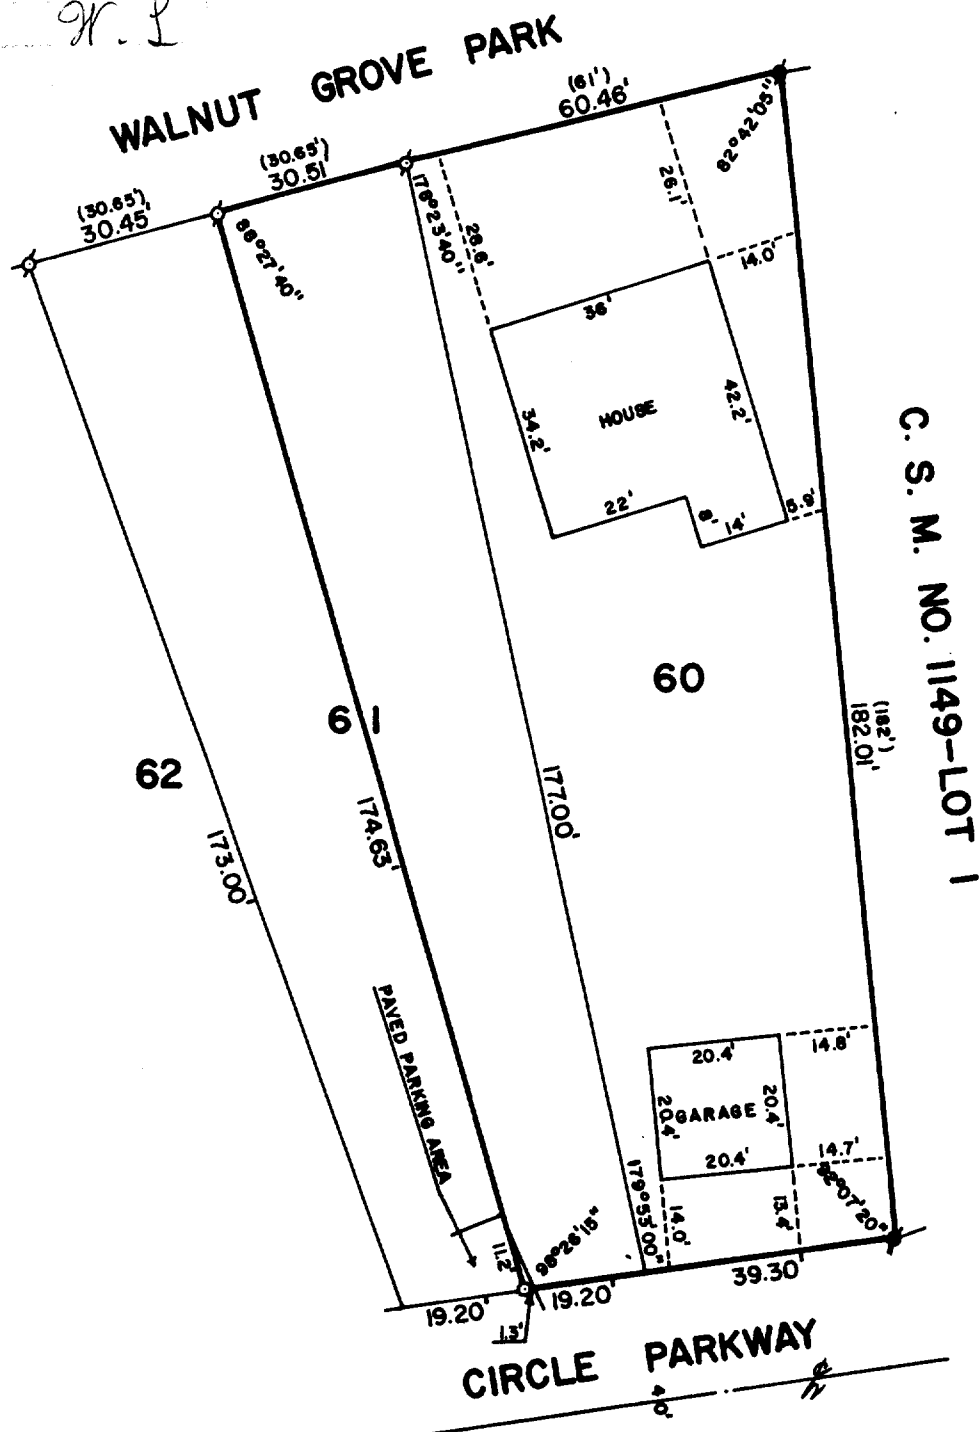

PLAT OF SURVEY OF

LOT 60 AND THE EAST 1/2 OF LOT 61 IN CEDAR
POINT PARK 1ST ADDITION, LOCATED IN THE
VILLAGE OF WILLIAMS BAY, WALWORTH COUNTY,
WISCONSIN.

ORDERED BY: MARGARET ROTCHFORD
CENTURY 21 FULL SERVICE REALTY
4044 N. LINCOLN AVENUE
CHICAGO, ILLINOIS 60618



SCALE: 1"=30'

- ⊙ - IRON PIPE FOUND
- ⊙ - CONCRETE MONUMENT FOUND
- () - RECORDED AS
- - IRON PIPE PLACED

I, ROBERT M. BAERENWALD, DO HEREBY CERTIFY THAT I
HAVE SURVEYED THE PROPERTY HEREON DESCRIBED ACCORDING
TO THE OFFICIAL RECORDS AND THAT THE PLAT HEREON IS A
CORRECT REPRESENTATION OF THE PROPERTY LINES TO THE
BEST OF MY KNOWLEDGE AND BELIEF.

Robert M. Baerenwald
ROBERT M. BAERENWALD
WISCONSIN REGISTERED LAND SURVEYOR, S-1508

Nov. 9, 1984
DATE JOB NO. 0146