



DUNHAM SURVEYING, S.C.
SURVEYING & SUBDIVIDING
DELAVER, WISCONSIN 53115

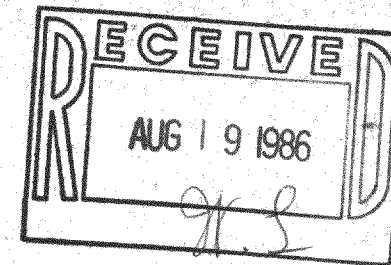

Concrete Monument located 0.15' North & 0.5' West of fence corner

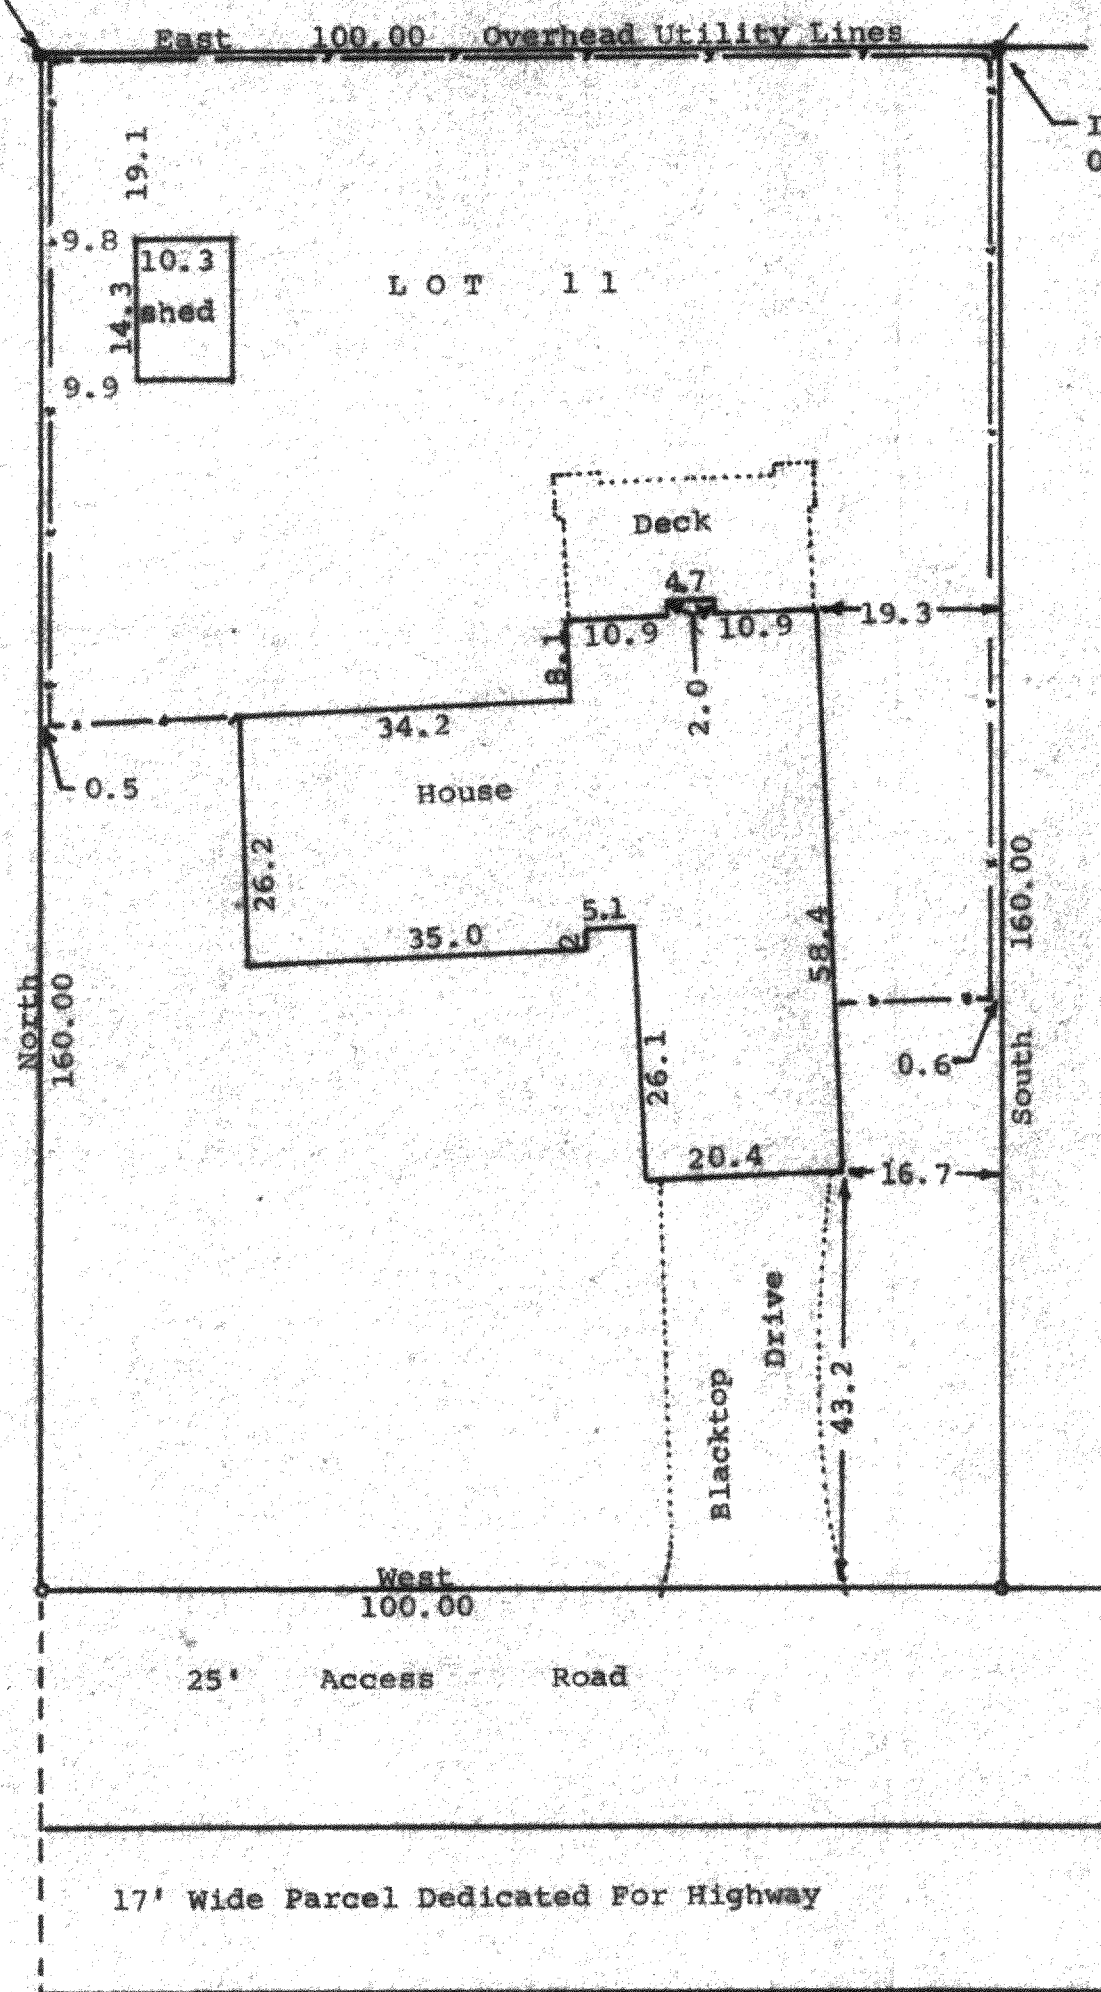

Iron Pipe located 0.15' North & 0.75' East of Fence Corner



Scale - 1" = 20'
 • = Concrete Monument Found
 / = 1 1/4" Iron Pipe Found
 o = 3/4" Iron Pipe Found
 Bearings used are those of record
 Survey ordered by: Modern Realty
 102 North Wisconsin
 Elkhorn, WI. 53121
 --- = Fence Line

Centerline of Geneva Street

STATE OF WISCONSIN)
 COUNTY OF WALWORTH)

I, George T. Dunham, Surveyor, certify that I have surveyed the property described as follows:

Lot 11 of Baywood Heights Subdivision located in the Village of Williams Bay, Walworth County, Wisconsin, and that the map shown above is a true representation thereof and shows the size and location of the property, its exterior boundaries, the location of all visible structures and dimensions of all principal buildings thereon, boundary fences, apparent easements, roadways and visible encroachments, if any, and that I have surveyed the property hereon described according to the official records to the best of my knowledge and belief.
 September 12, 1984

George T. Dunham
 George T. Dunham, Surveyor

