


OLIVE STREET

ELMHURST STREET



56' WIDE 132 00'

WALWORTH STREET

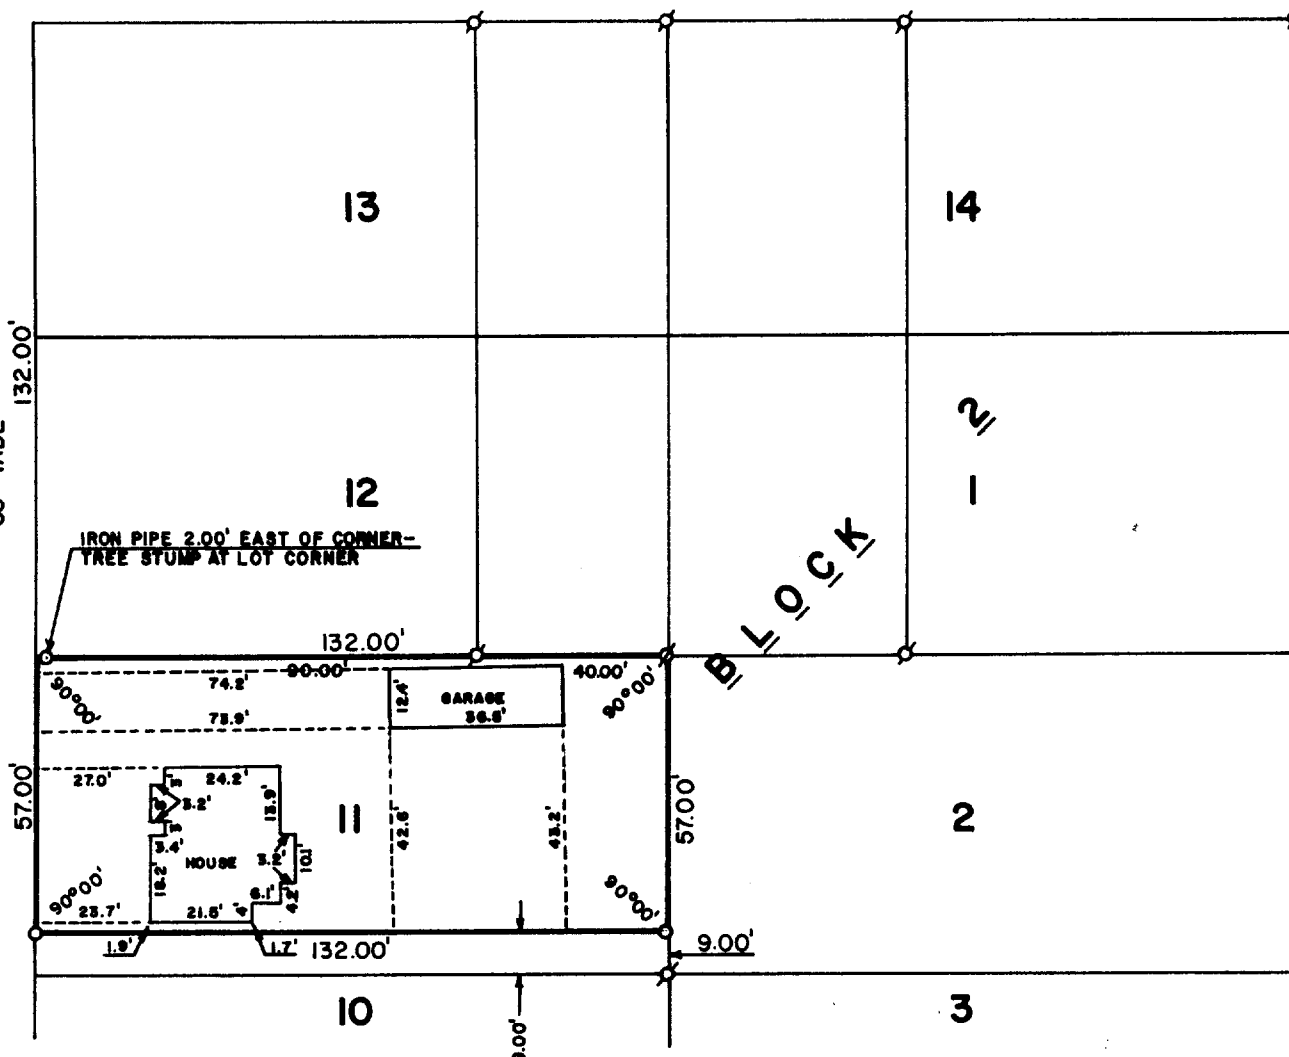

THE NORTH 57 FEET OF LOT 11, BLOCK 2
OF ADDITION NUMBER ONE TO THE VILLAGE
OF WILLIAMS BAY, WALWORTH COUNTY,
WISCONSIN.

ORDERED BY: KEEFE REAL ESTATE
704 MAIN STREET
LAKE GENEVA, WISCONSIN 53147

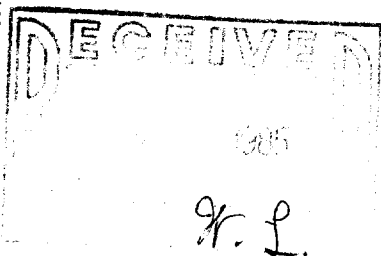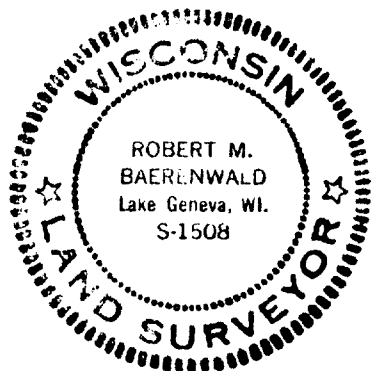

Ø - IRON PIPE FOUND
Ø - IRON ROD FOUND
○ - IRON PIPE PLACED

I, ROBERT M. BAERENWALD, DO HEREBY CERTIFY THAT I HAVE SURVEYED THE PROPERTY HEREON DESCRIBED ACCORDING TO THE OFFICIAL RECORDS AND THAT THE PLAT HEREON IS A CORRECT REPRESENTATION OF THE PROPERTY LINES TO THE BEST OF MY KNOWLEDGE AND BELIEF.

Robert M. Baerenwald
ROBERT M. BAERENWALD
WISCONSIN REGISTERED LAND SURVEYOR, S-1508

DATE Oct. 7, 1984 JOB NO. 0129

WOP-22

11-461