



HAROLD H. KOLB

REGISTERED PROFESSIONAL LAND SURVEYOR
LAKE GENEVA, WISCONSIN

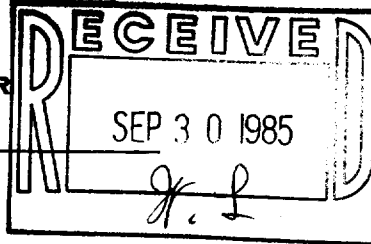

STARK STREET - 50' WIDE

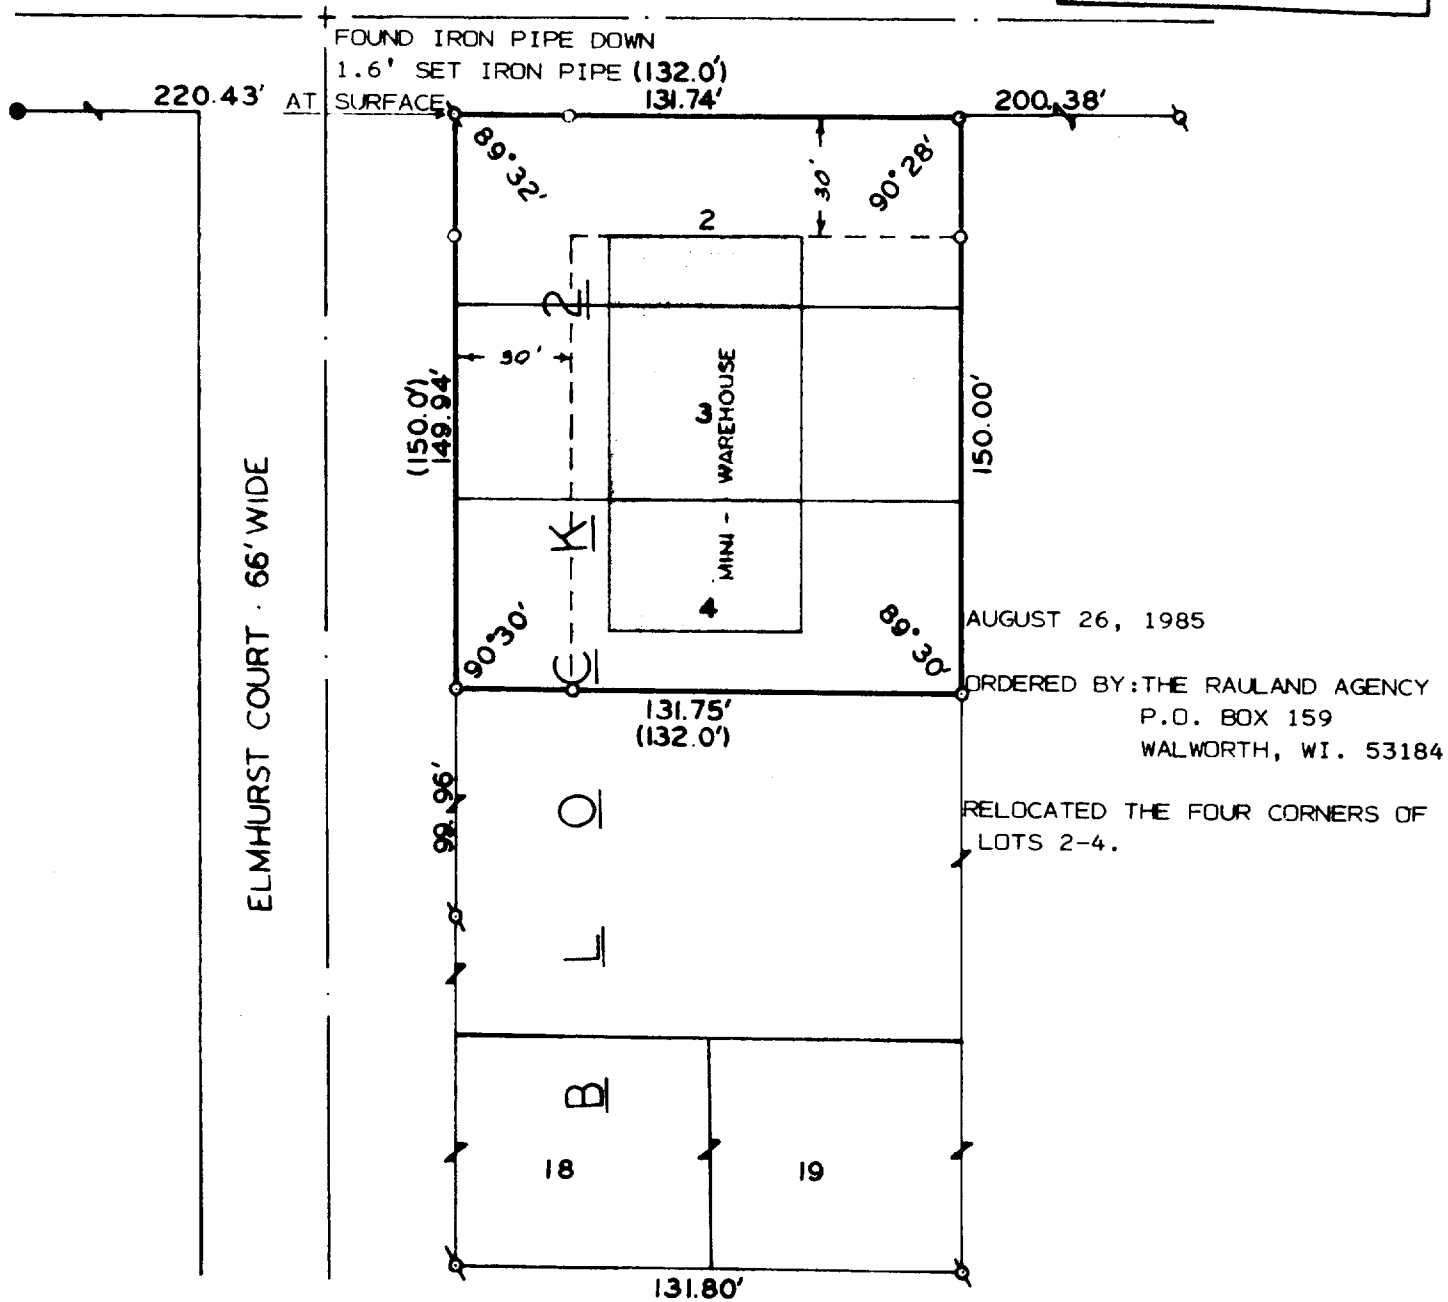

PLAT OF SURVEY OF

LOTS 2, 3, AND 4 IN BLOCK 2 OF STARK'S
SUBDIVISION, VILLAGE OF WILLIAMS BAY,
WALWORTH COUNTY, WISCONSIN.

ORDERED BY: HOWARD & ASSOCIATES
LAKE GENEVA, WI 53147

FOR: DEWLAND ASSOCIATES, INC.



SCALE: 1"=50'

LEGEND

- — IRON PIPE PLACED, 1" x 24" 1.13 LB./LIN. FT.
- — CONCRETE MONUMENT, 3" DIA. x 30"
- ⋈ — IRON PIPE FOUND

I, HAROLD H. KOLB, DO HEREBY CERTIFY THAT I HAVE
SURVEYED THE PROPERTY HEREON DESCRIBED ACCORDING
TO THE OFFICIAL RECORDS, AND THAT THE PLAT HEREON
IS A CORRECT REPRESENTATION OF THE LOT LINES, AND
THE PRINCIPAL LINES OF THE BUILDINGS THEREON.

Harold H. Kolb

HAROLD H. KOLB
WISCONSIN REGISTERED LAND SURVEYOR, 9-187

DATE JUNE 5, 1978

REVISED AUGUST 26, 1985

(1) - AS PLATTED