


CEDAR POINT DRIVE

WALWORTH COUNTY
SURVEYING & MAPPING
LAKE GENEVA, WISCONSIN

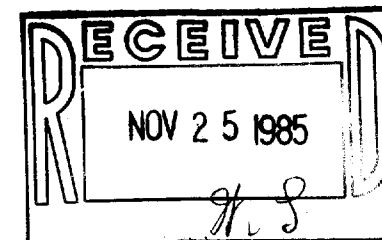



PLAT OF SURVEY OF
LOTS 12 AND 13 OF CEDAR POINT SUBDIVISION,
LOCATED IN SECTIONS 5 AND 6, T14N, R17E,
VILLAGE OF WILLIAMSBAY, WALWORTH COUNTY,
WISCONSIN.

PREPARED BY: JOHN LAW REALTORS
903 MAIN STREET
LAKE GENEVA, WISCONSIN 53147

SCALE: 1"=40'

LEGEND

Ø-IRON PIPE FOUND
()-RECORDED AS

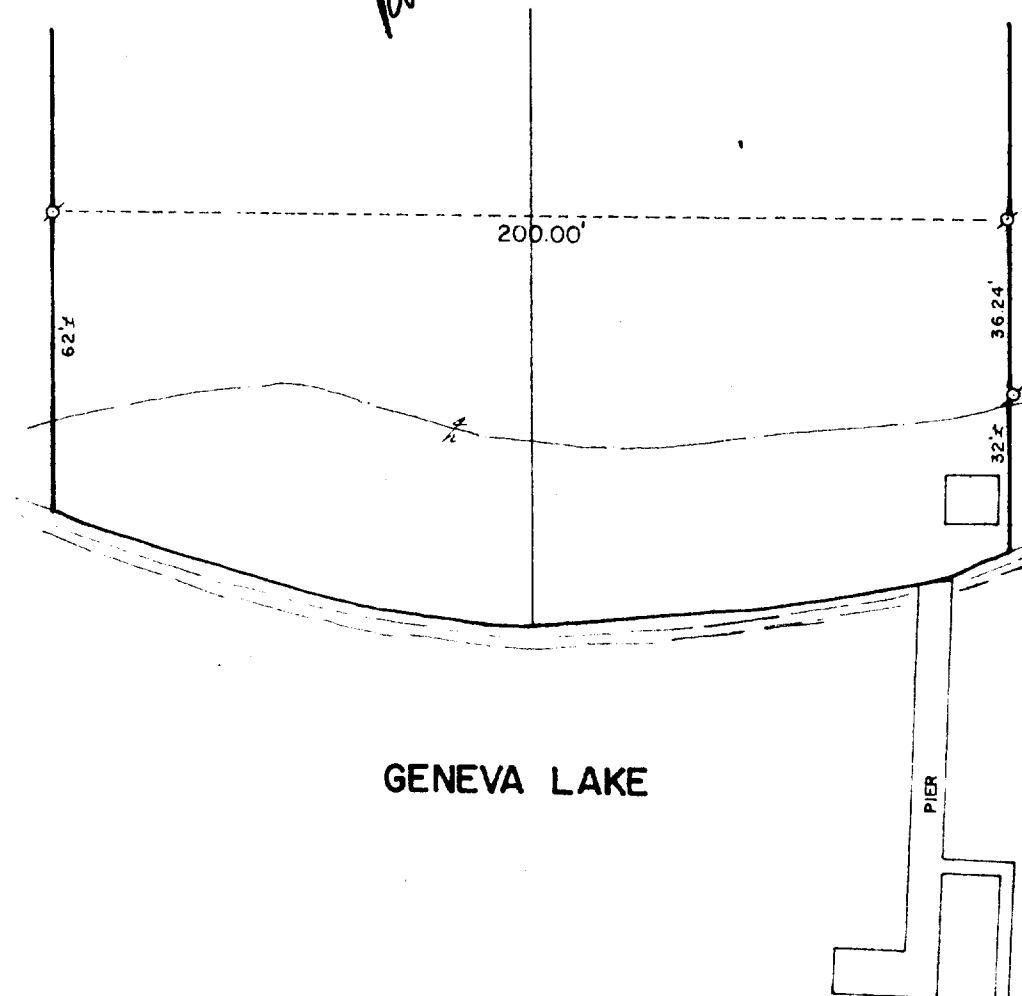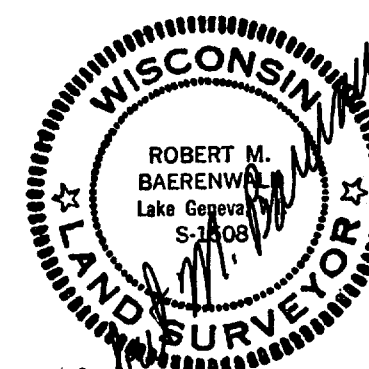

GENEVA LAKE

I HEREBY CERTIFY THAT I HAVE SURVEYED THE ABOVE
DESCRIBED PROPERTY AND THAT THE ABOVE MAP IS A TRUE
REPRESENTATION THEREOF AND SHOWS THE SIZE AND LOCATION
OF THE PROPERTY, ITS INTERIOR BOUNDARIES, THE LOCATION
OF ALL VISIBLE STRUCTURES AND DIMENSIONS OF ALL PRINCIPAL
BUILDINGS THEREON, BOUNDARY FENCES, APPARENT EASEMENTS,
EASEWAYS AND VISIBLE ENCROACHMENTS, IF ANY.

THIS SURVEY IS MADE FOR THE USE OF THE PRESENT OWNERS
OF THE PROPERTY AND ALSO THOSE WHO PURCHASE, MORTGAGE
OR IN ANY MANNER TAKE TITLE THEREIN WITHIN ONE (1) YEAR
OF THE DATE OF THIS SURVEY.

Robert M. Baerenwald
ROBERT M. BAERENWALD
WISCONSIN REGISTERED LAND SURVEYOR, 11408

25 NOV 1985
DATE: 25 NOV 1985

LOT 14

LOT 13

LOT 12

LOT 11

GENEVA LAKE