




N.E. CORNER OF
CEDAR POINT PARK

HUMBOLDT
PARKWAY

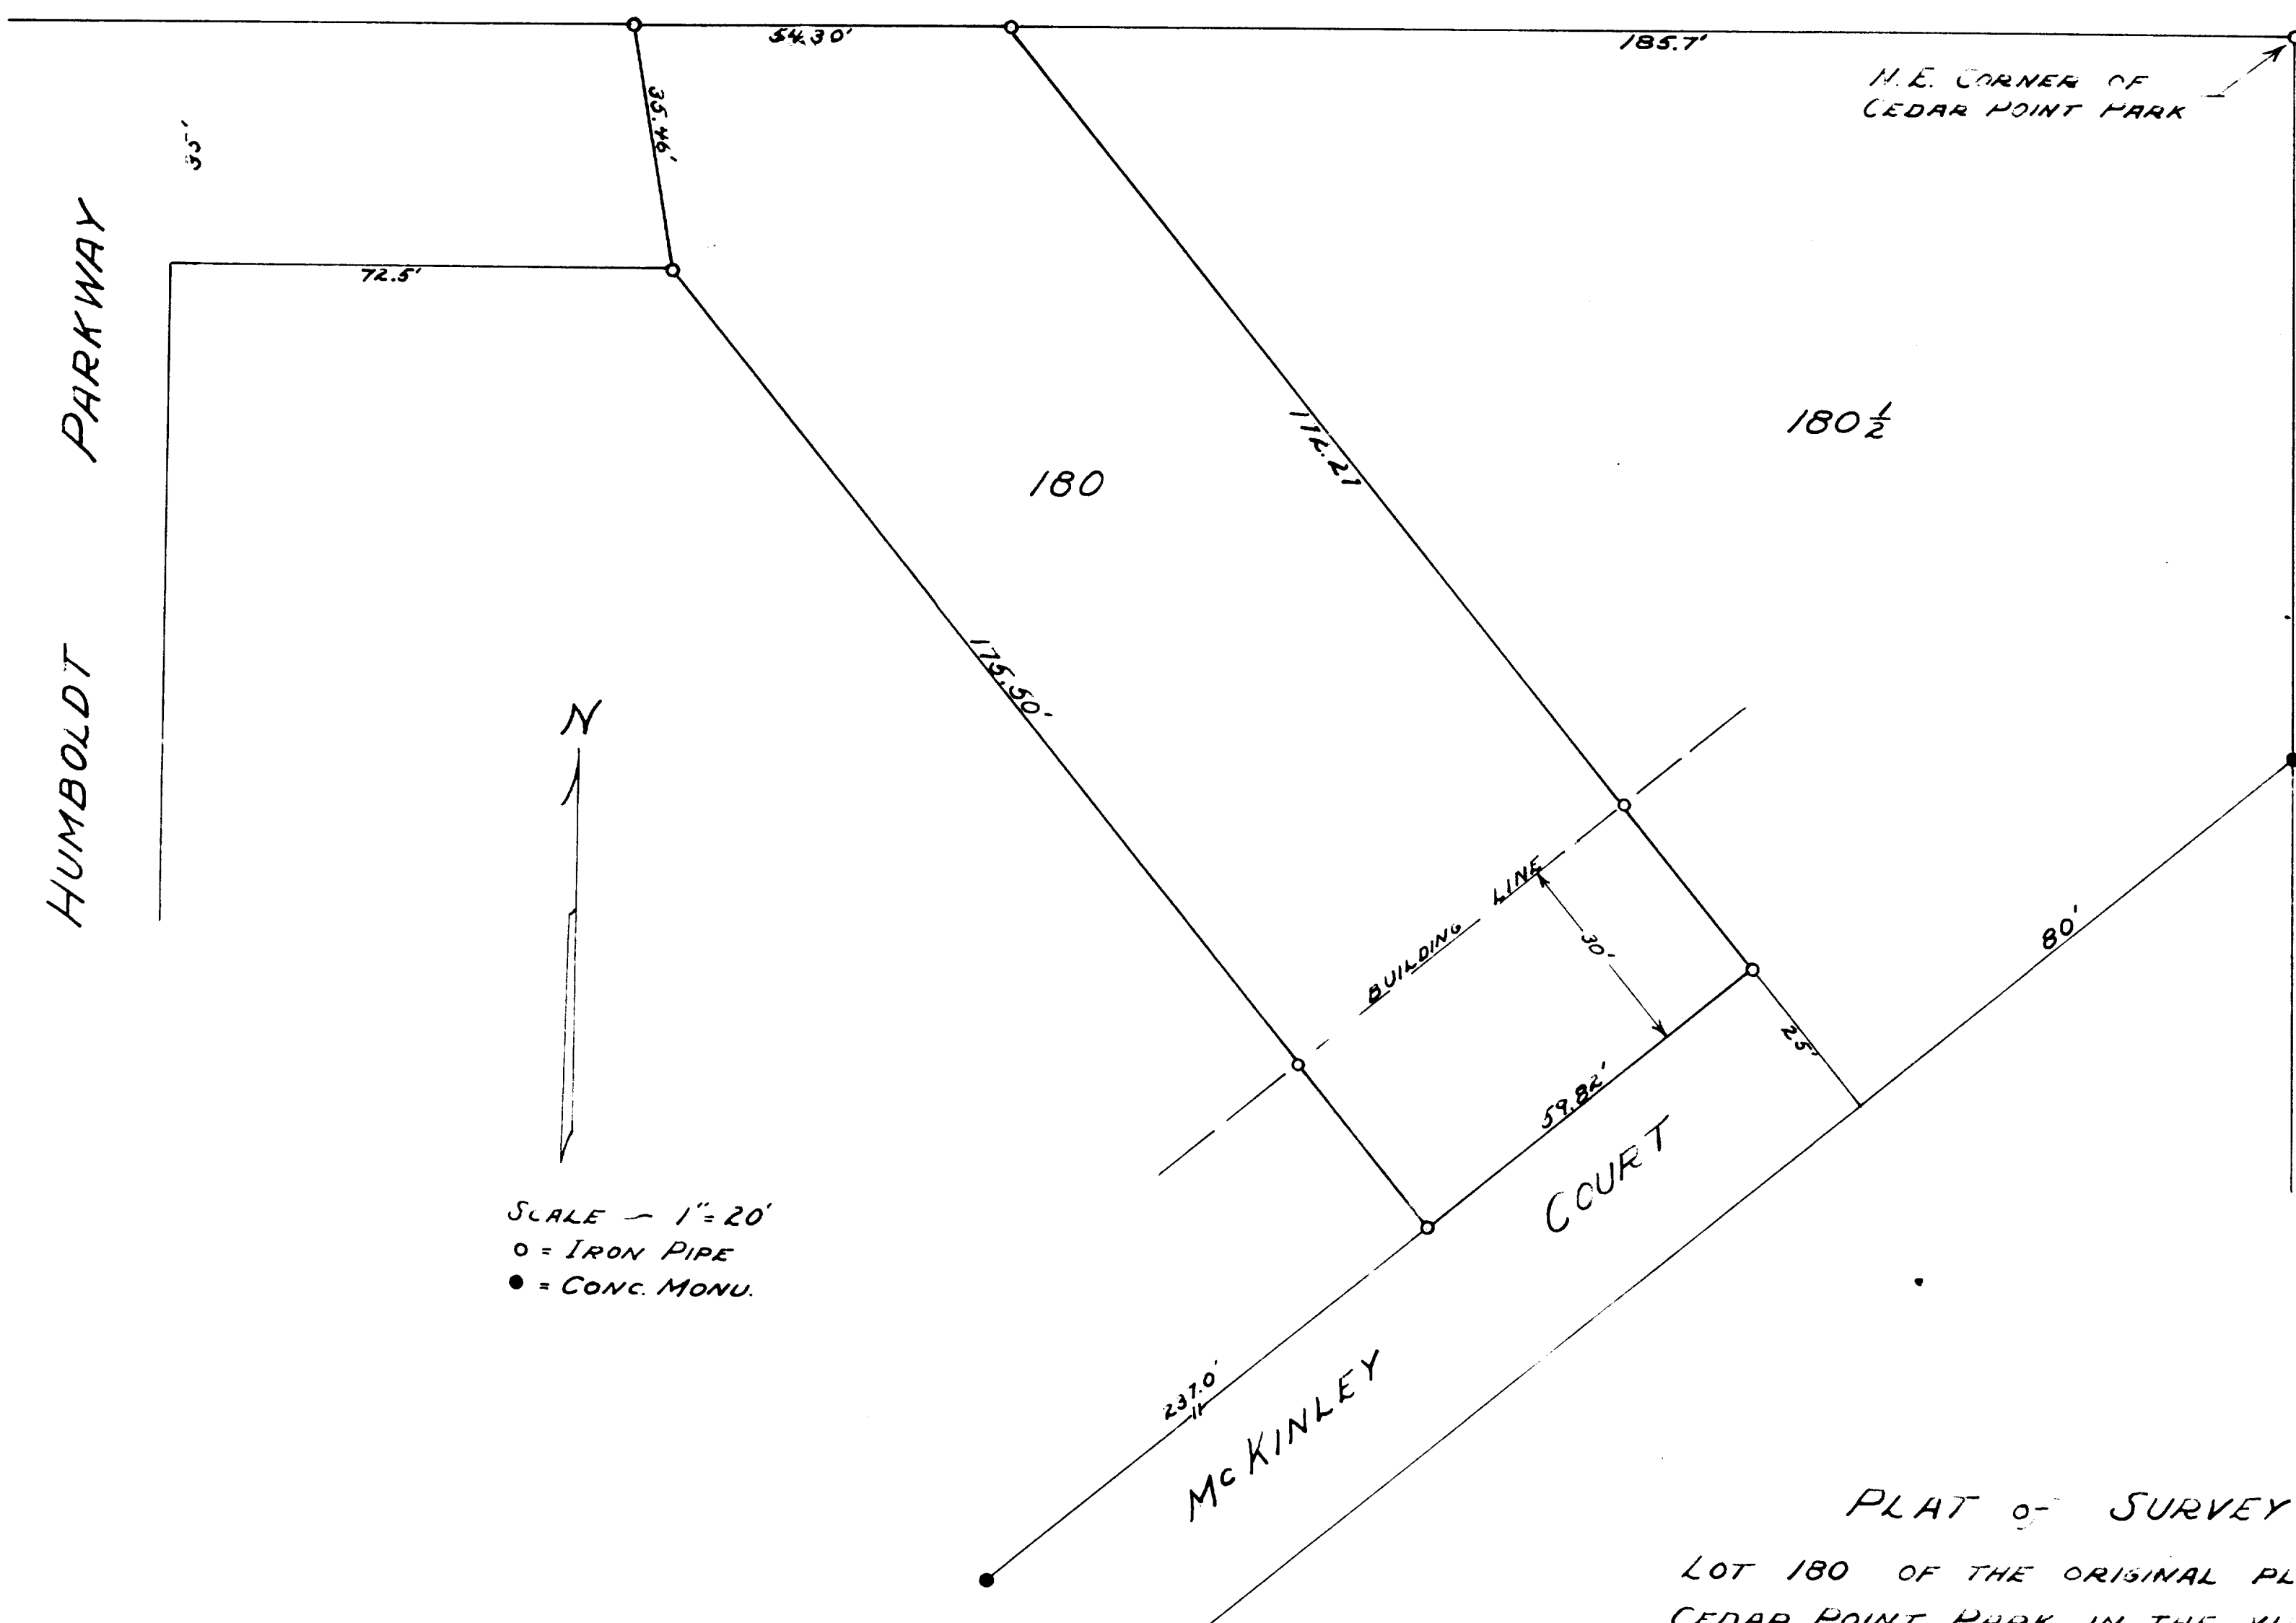

SCALE - 1" = 20'
 O = IRON PIPE
 • = CONC. MONU.

BUILDING LINE

COURT

McKINLEY

PLAT OF SURVEY

LOT 180 OF THE ORIGINAL PLAT OF
 CEDAR POINT PARK, IN THE VILLAGE
 OF WILLIAMS BAY, WALNORTH COUNTY,
 WISCONSIN.

NOVEMBER 18, 1948

11-46J

Lloyd L. Jensen
 SURVEYOR