



FARRIS, HANSEN & ASSOCIATES, INC.
7 RIDGEWAY COURT, ELKHORN, WI
414-723-2098

PLAT OF SURVEY OF LOT 11 OF BETHEL BLOCK LOCATED IN NE 1/4 SECTION 1, TOWN 1 NORTH, RANGE 16 EAST
VILLAGE OF WILLIAMS BAY, WALWORTH COUNTY, WISCONSIN
Work Ordered by: Robert Vyskocil

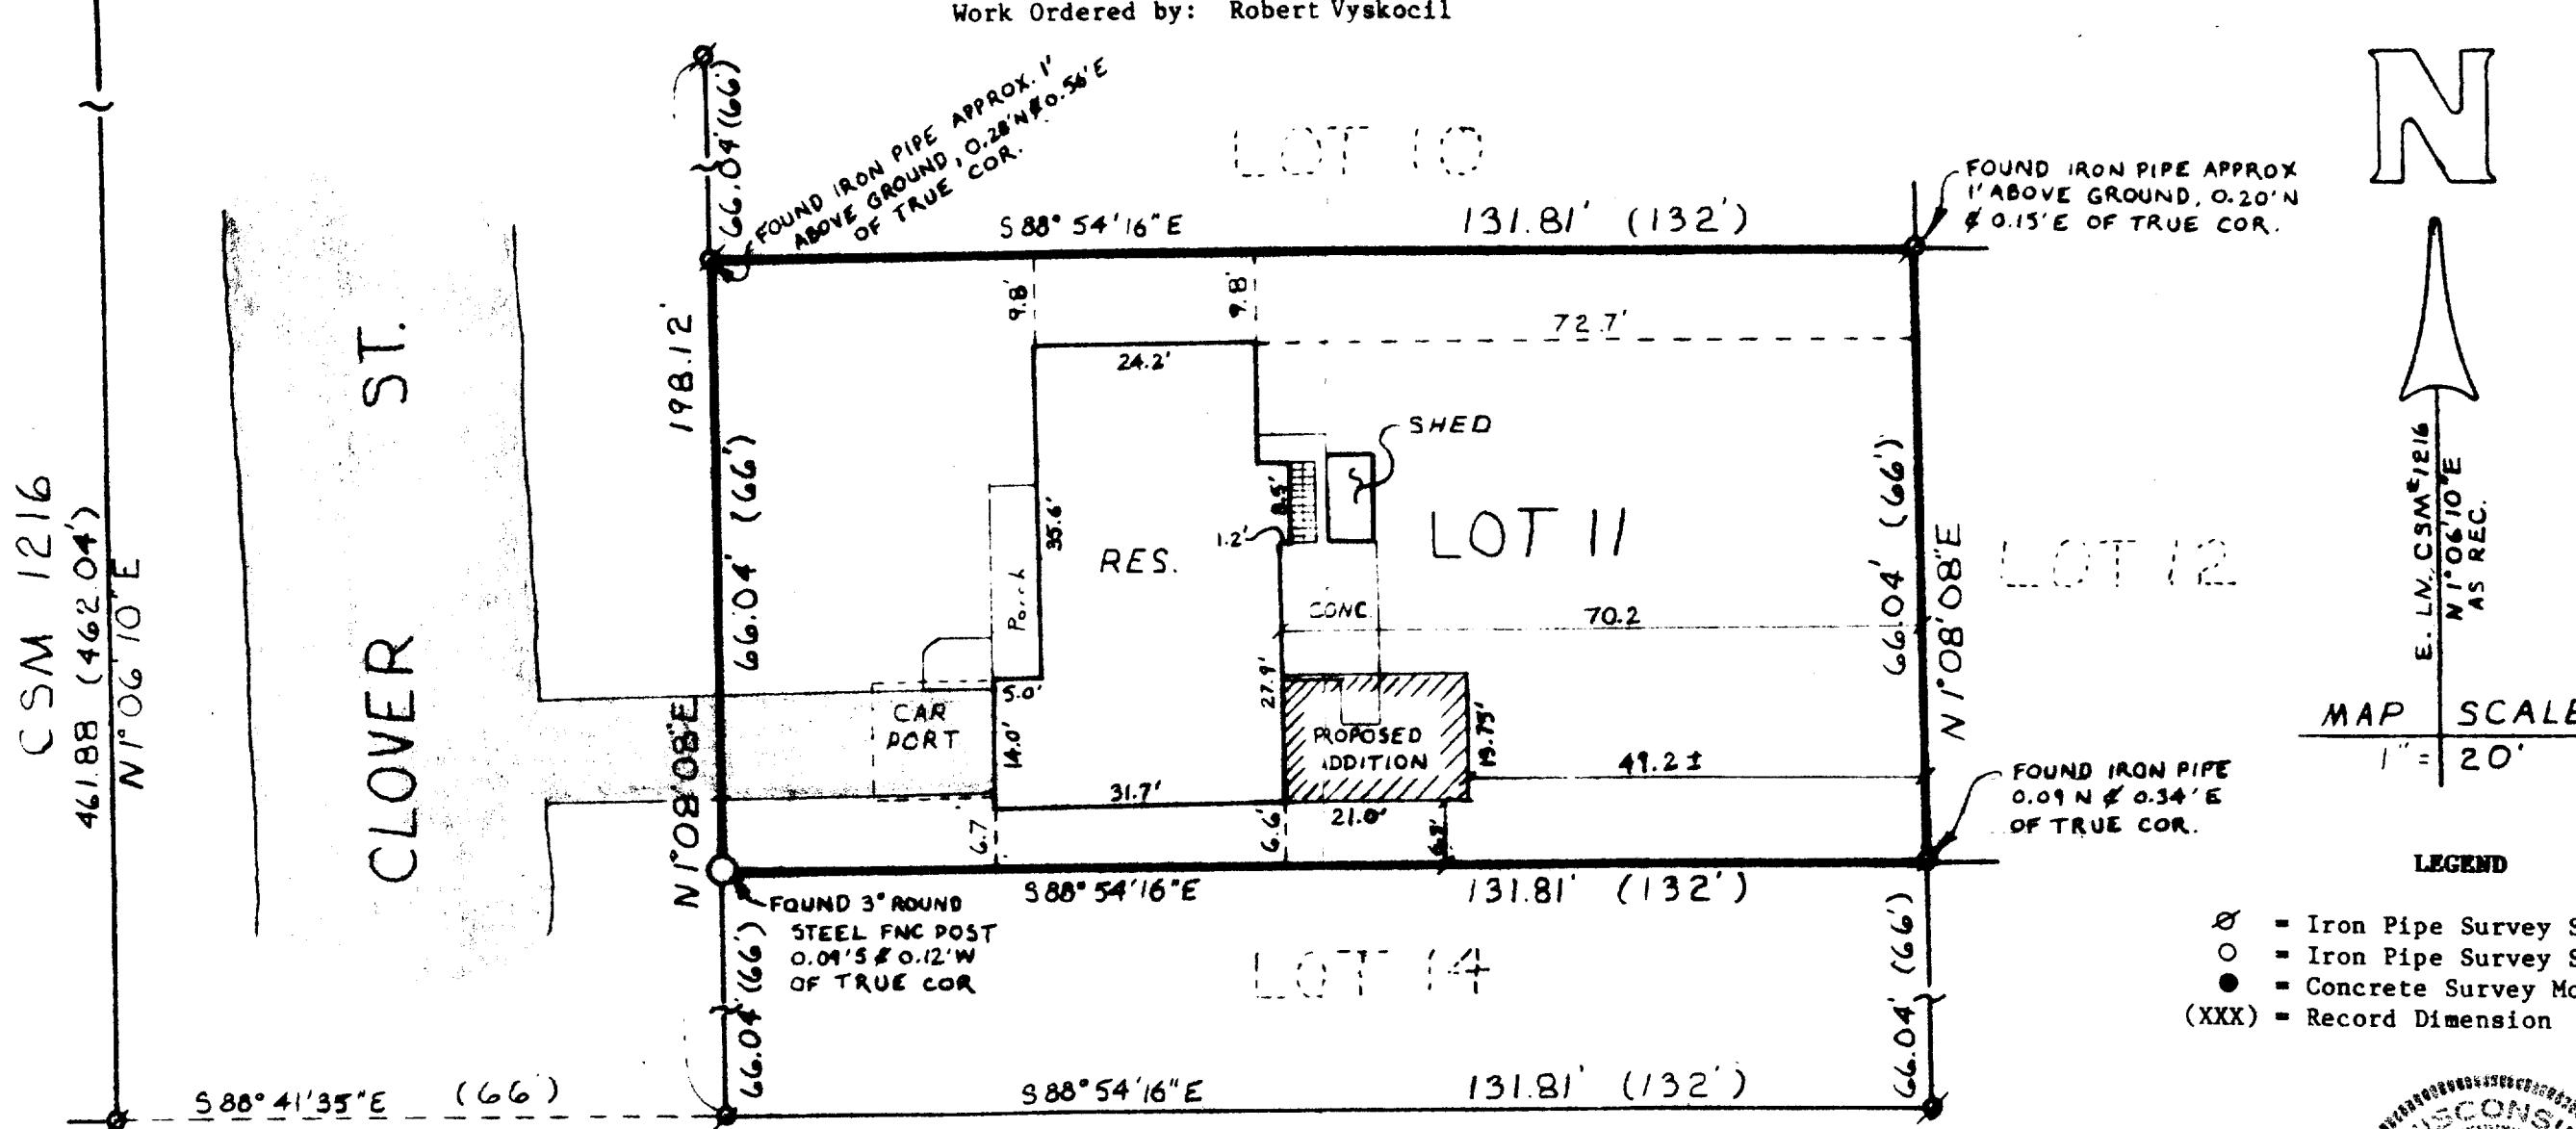

I hereby certify that I have surveyed the above described property and that the above map is a true representation thereof and shows the size and location of the property, its exterior boundaries, the location of all visible structures and dimensions of all principal buildings thereon, to the best of my professional knowledge and belief.

Robert A. Farris
Robert A. Farris, R.L.S.
Dated this 24th Day of October, 1985

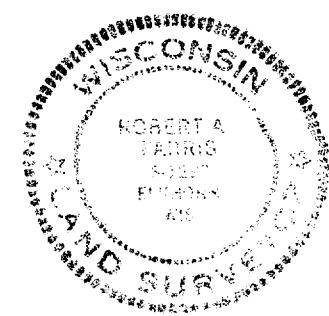

PROJ. NO. 2490

11-478 ✓

WBX-00010