
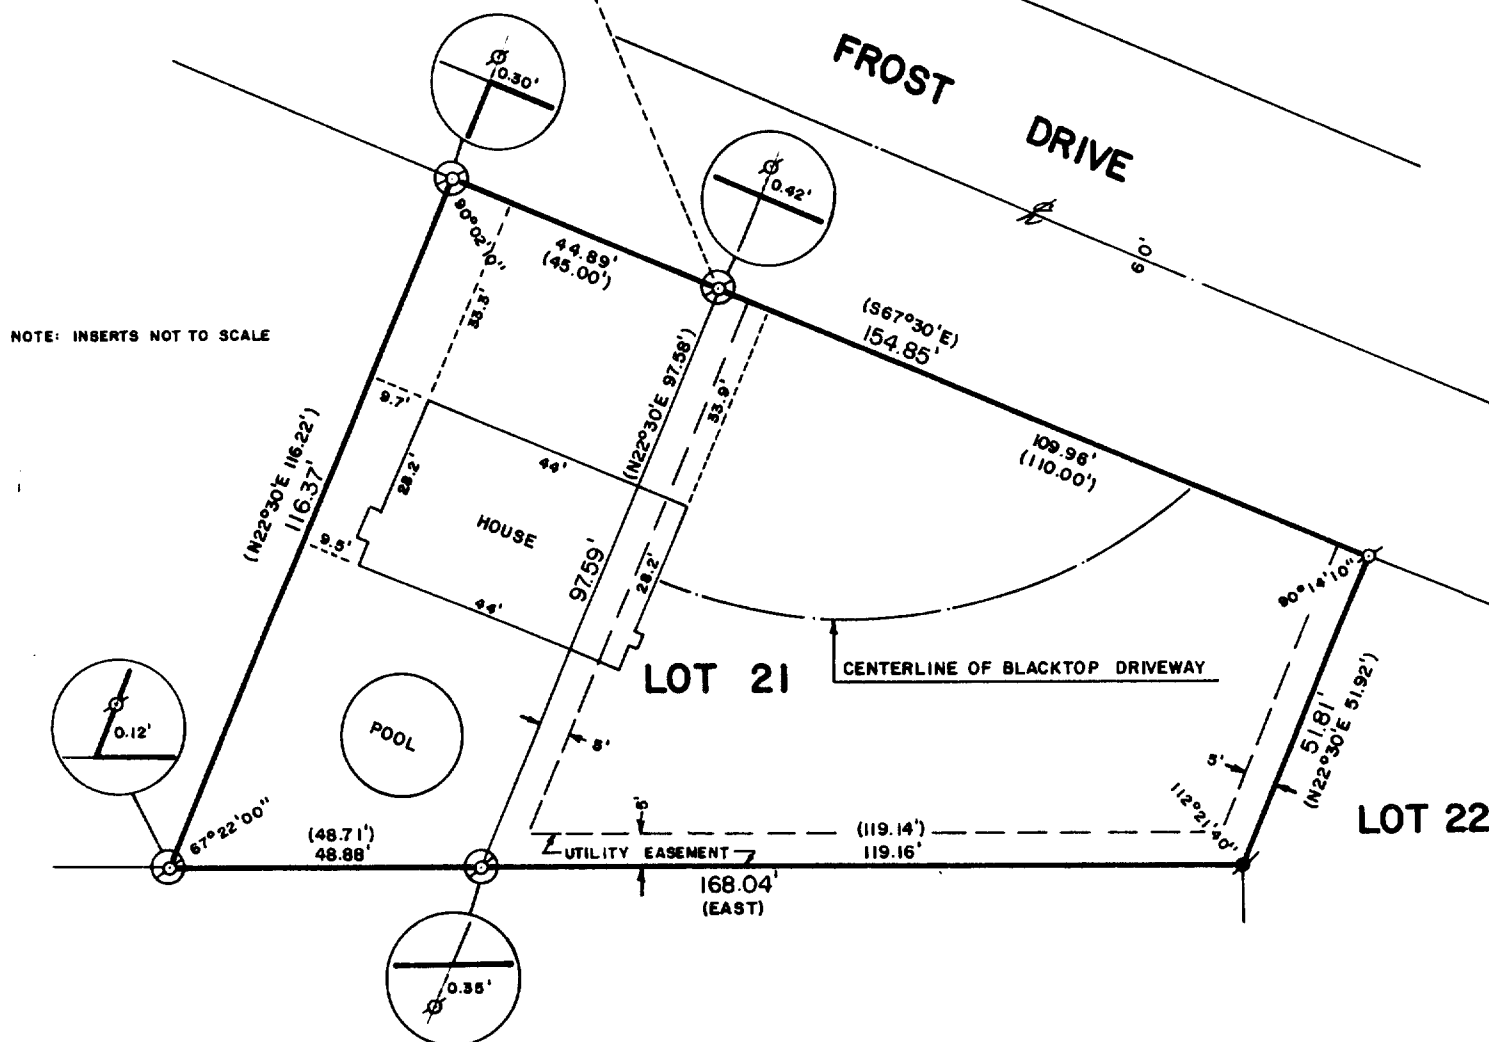



WALWORTH COUNTY
SURVEYING & MAPPING
LAKE GENEVA, WISCONSIN

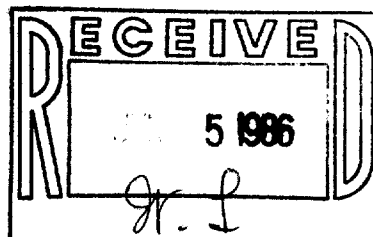

PLAT OF SURVEY OF

LOT 21 OF BAYWOOD HEIGHTS ADDITION NUMBER ONE, A SUBDIVISION LOCATED IN THE NORTHWEST 1/4 OF SECTION 1, T 1 N, R 16 E, IN THE VILLAGE OF WILLIAMS BAY, WALWORTH COUNTY, WISCONSIN AND A PARCEL OF LAND ADJOINING SAID LOT, DESCRIBED AS FOLLOWS: BEGINNING AT THE NORTHWEST CORNER OF SAID LOT 21, THENCE N67°30'W 45.00 FEET; THENCE S22°30'W 116.22 FEET; THENCE EAST 48.71 FEET TO THE SOUTHWEST CORNER OF SAID LOT 21; THENCE N22°30'E ALONG SAID WEST LINE OF LOT 21 TO THE PLACE OF BEGINNING.

ORDERED BY: KENOSHA SAVINGS & LOAN
410 BROAD STREET
LAKE GENEVA, WISCONSIN 53147

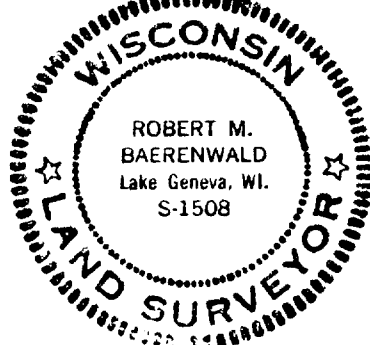

I, ROBERT M. BAERENWALD, DO HEREBY CERTIFY THAT I HAVE SURVEYED THE PROPERTY HEREON DESCRIBED ACCORDING TO THE OFFICIAL RECORDS AND THAT THE PLAT HEREON IS A CORRECT REPRESENTATION OF THE PROPERTY LINES TO THE BEST OF MY KNOWLEDGE AND BELIEF.

Robert M. Baerenwald
ROBERT M. BAERENWALD
WISCONSIN REGISTERED LAND SURVEYOR, S-1508

May 20, 1986
DATE JOB NO. 0549



⊙ - IRON PIPE FOUND
● - CONCRETE MONUMENT FOUND
() - RECORDED AS

WBW1-00001 + Part of WWP-00004C

11-479-B