


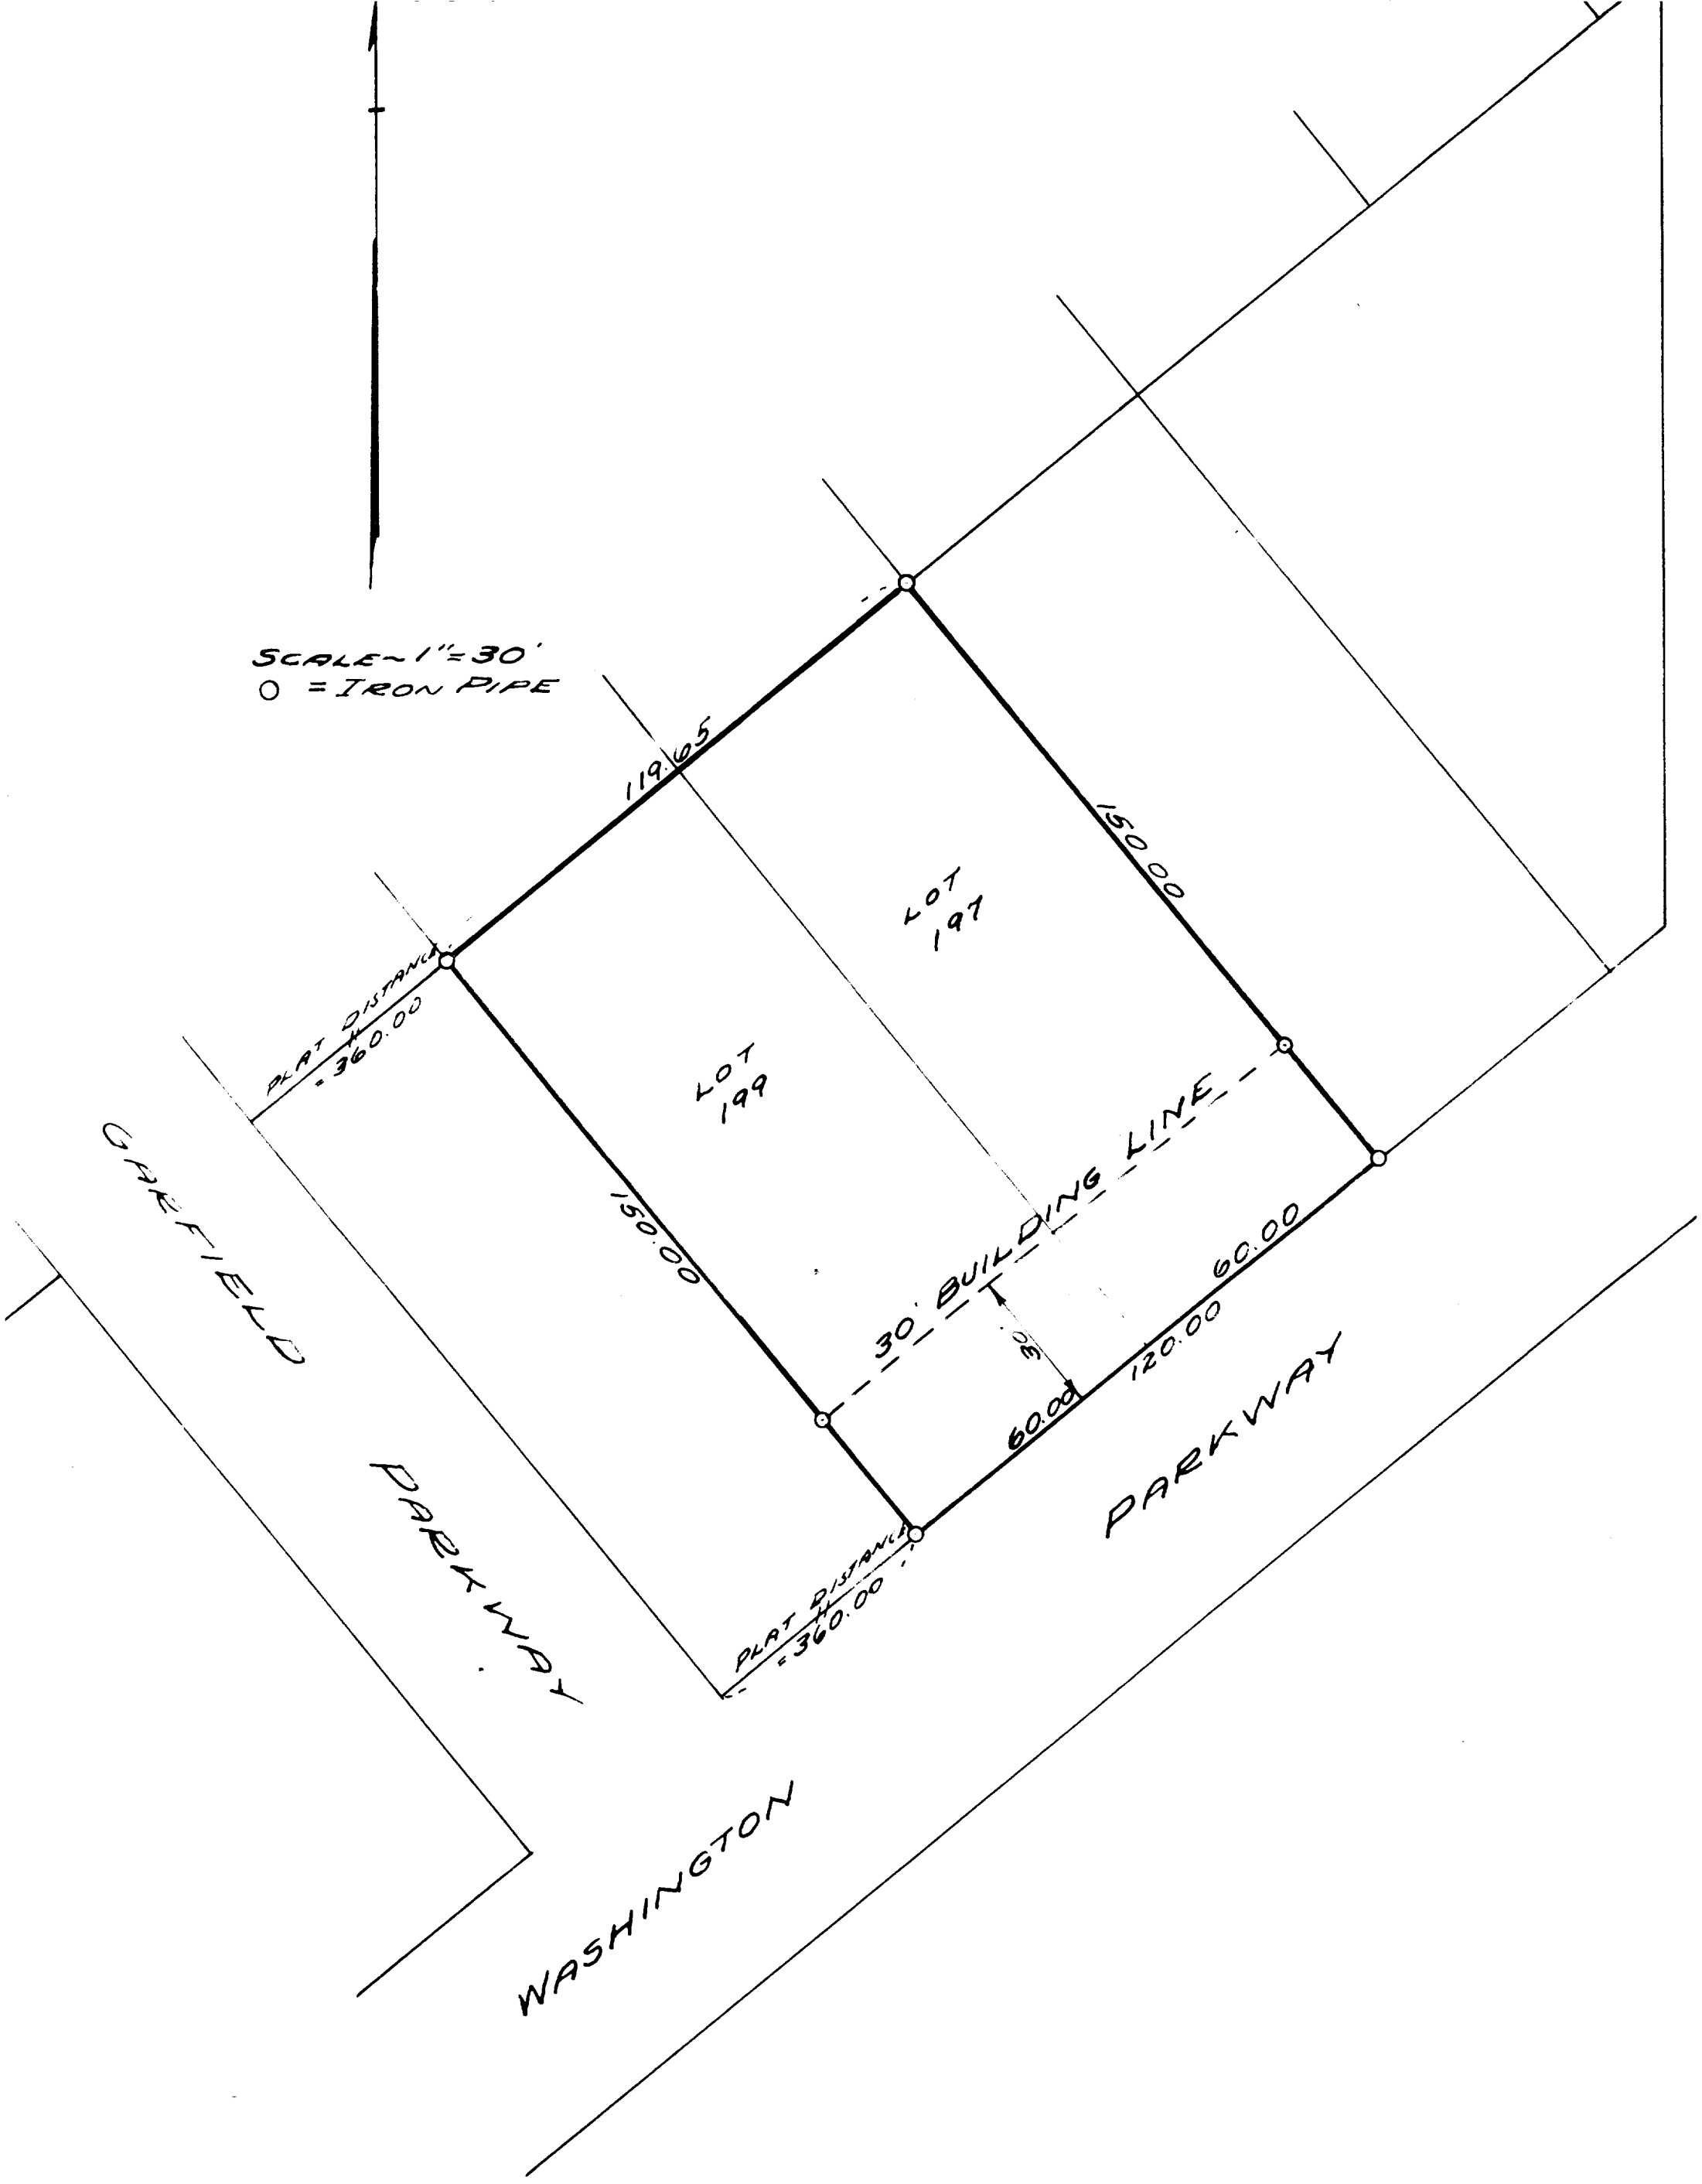

SCALE - 1" = 30'
O = IRON PIPE

PLAT OF SURVEY OF LOTS 197 AND 199 OF CEDAR
POINT PARK, LOCATED IN THE VILLAGE OF
WILLIAMS BAY, WALWORTH COUNTY, WISCONSIN.

SEPTEMBER, 1948

H. E. Johnson 11-47
SURVEYOR

WCP-172, 174