


GEORGE T. DUNHAM
SURVEYING & SUBDIVIDING
DELAVER, WISCONSIN

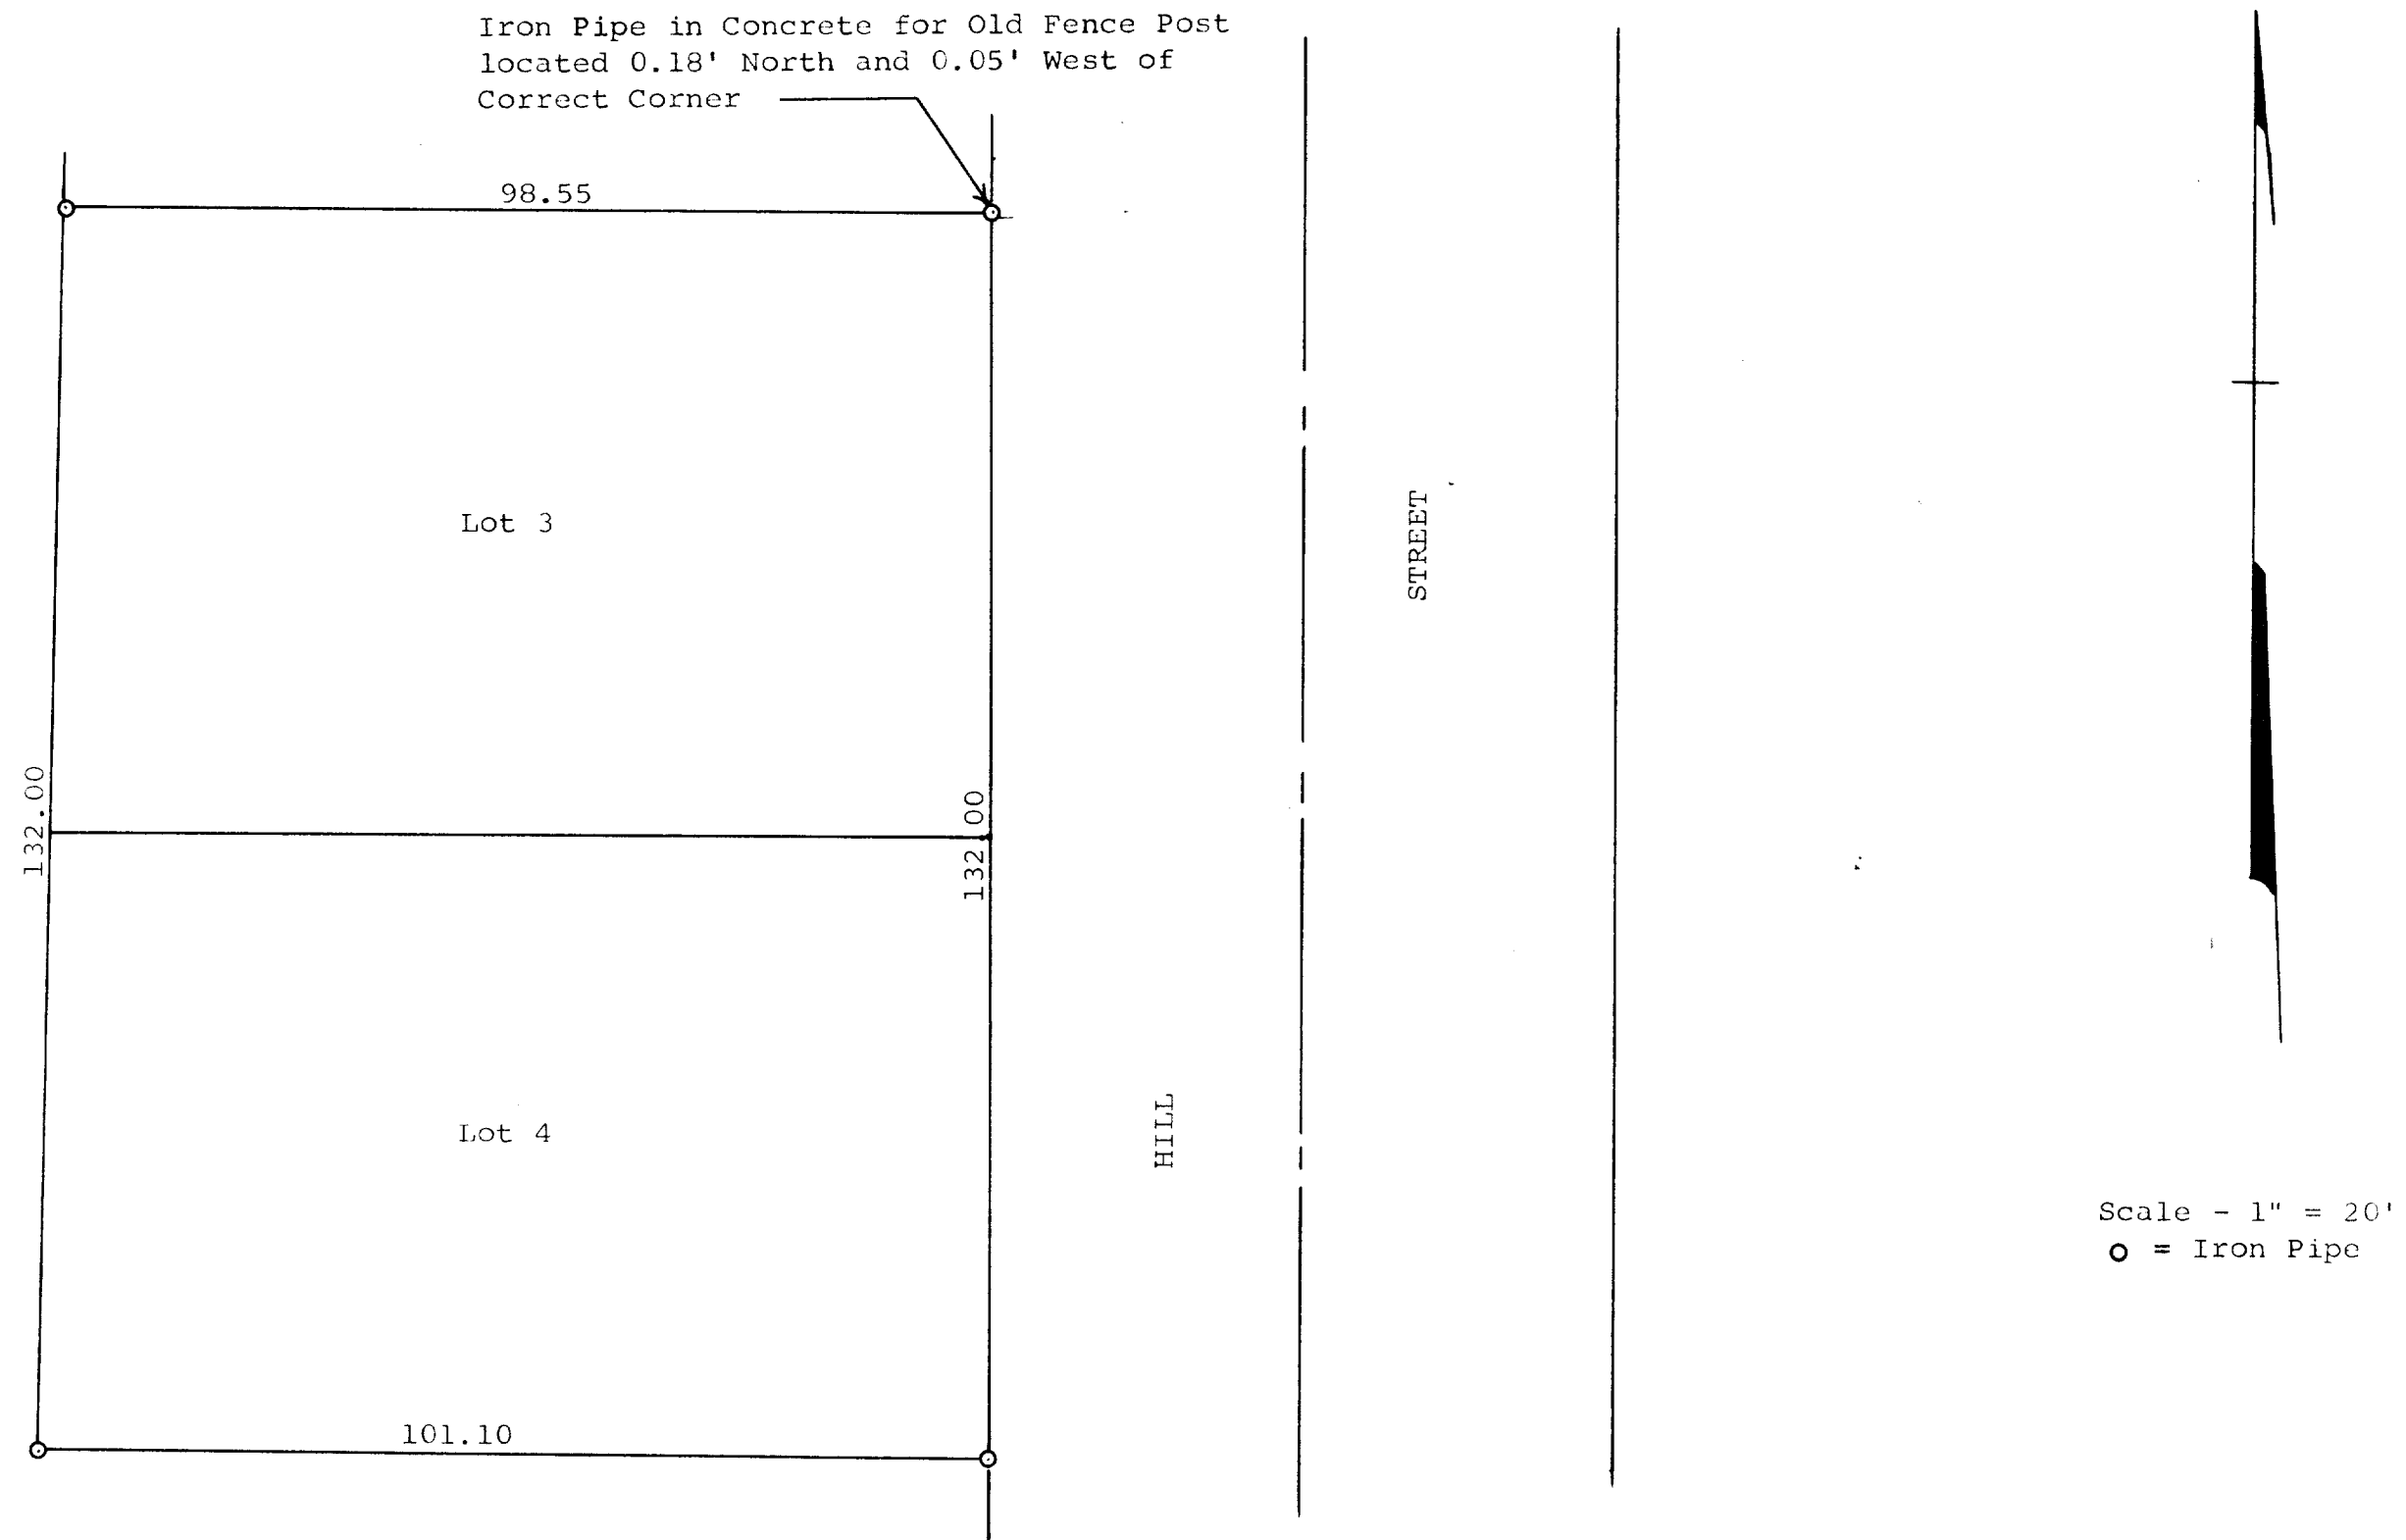

STATE OF WISCONSIN) ss
WALWORTH COUNTY)

I, George T. Dunham, Surveyor, do certify that I have surveyed the property described as follows,

Lots 3 and 4 in Block 14 of William's Second Addition to Williams Bay, Walworth County, Wisconsin, and that the above plat is an accurate and a true representation thereof and correctly shows the boundary lines and the correct measurements thereof.

March 23, 1970

George T. Dunham
George T. Dunham, Surveyor

11-49