

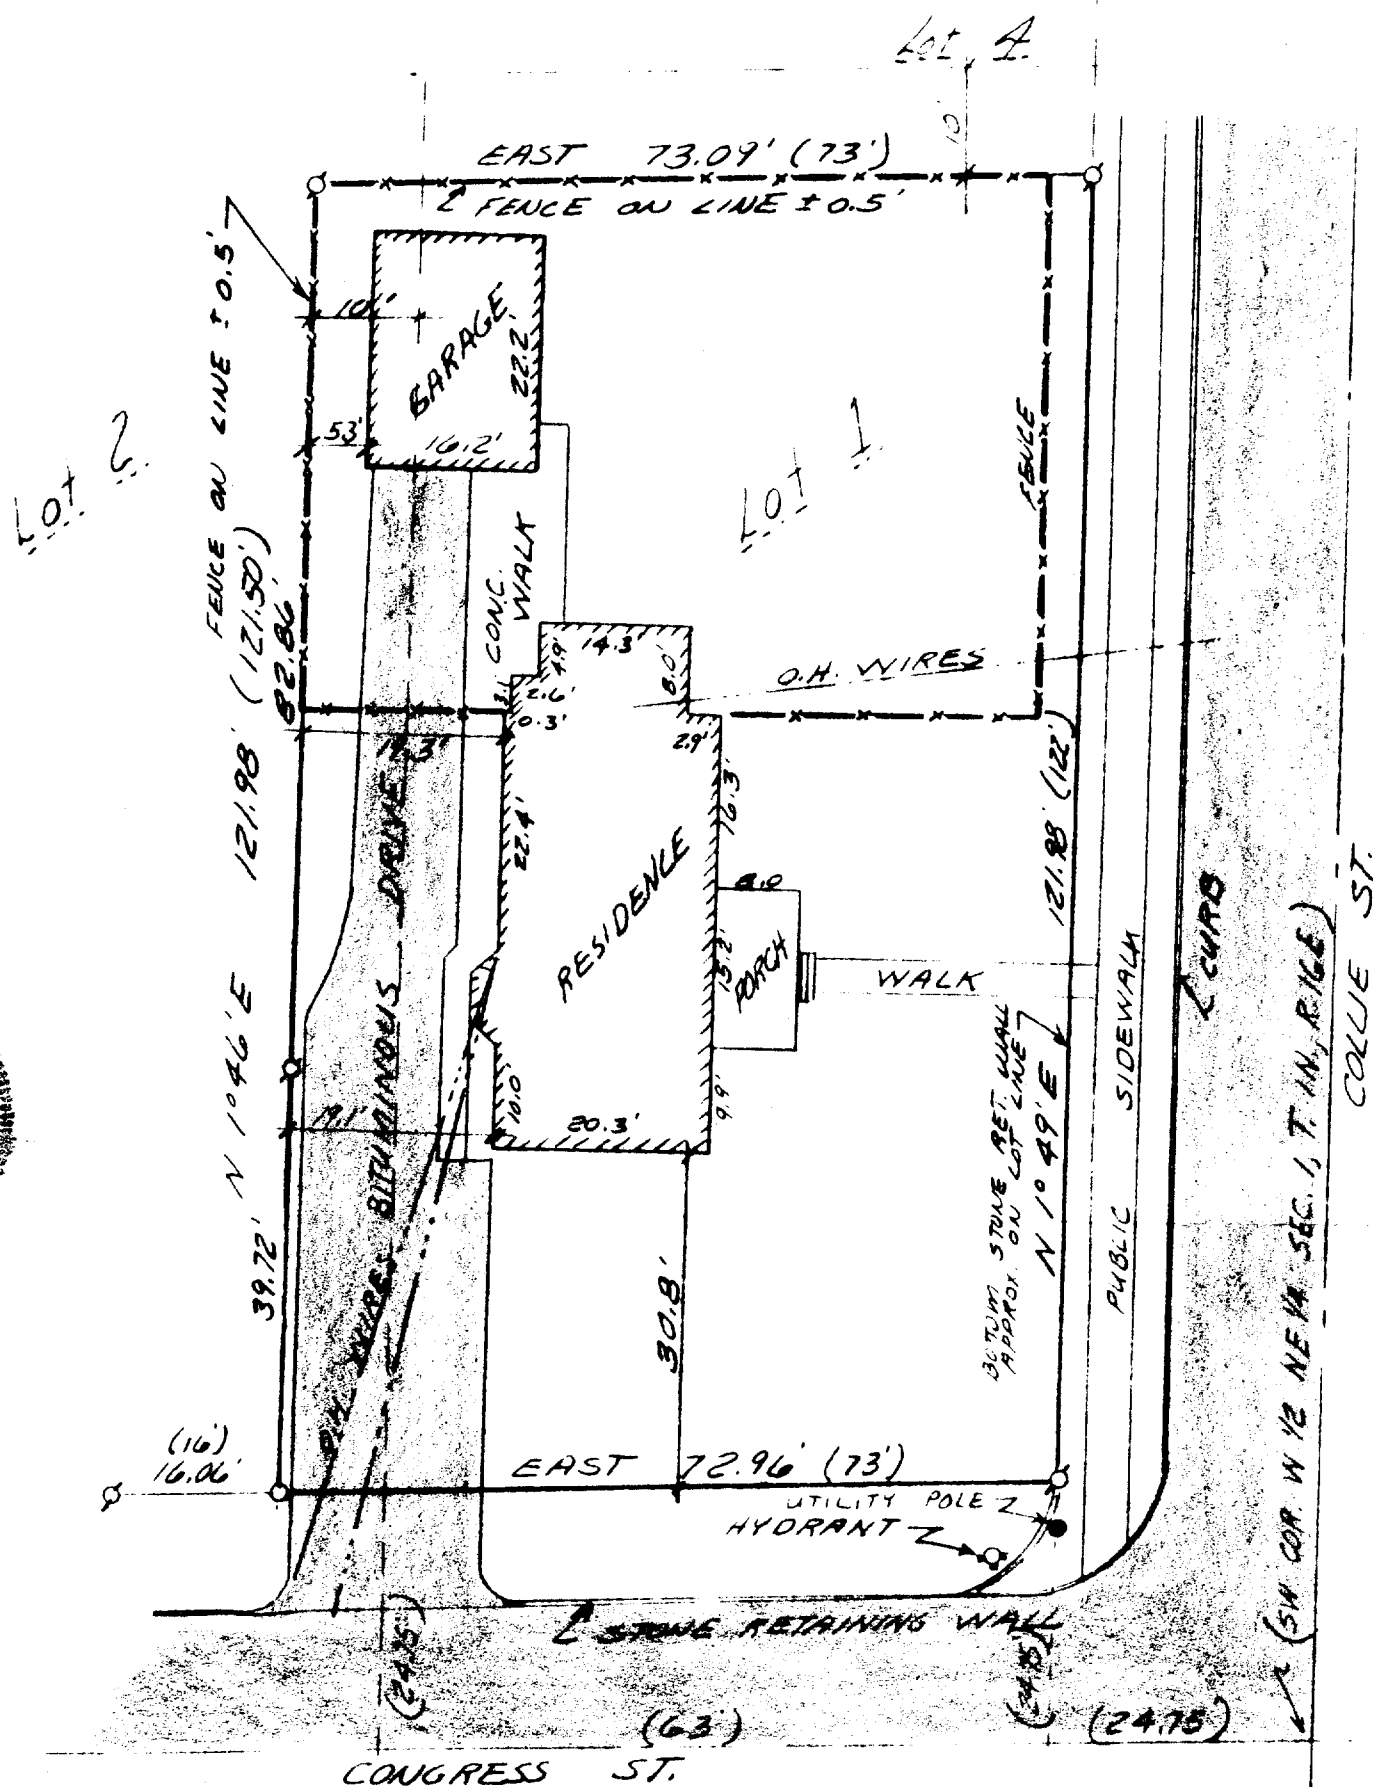
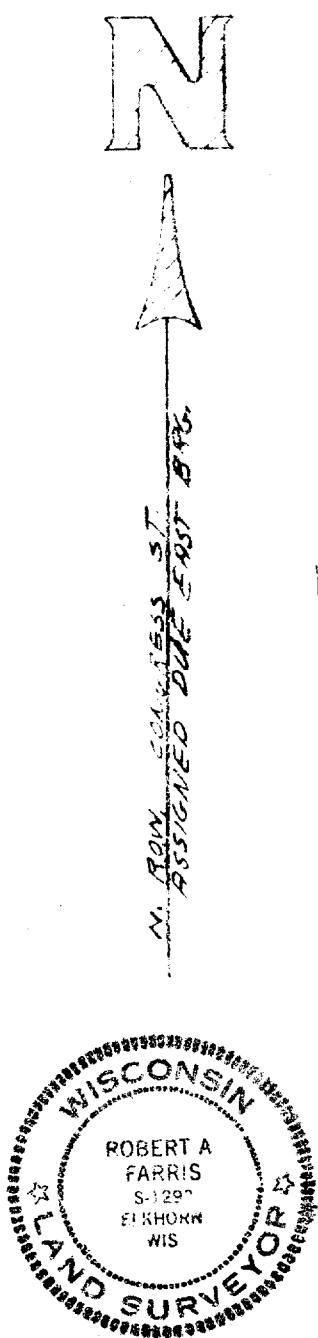


ELKHORN, WISCONSIN 53121

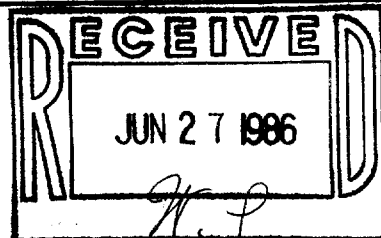

WORK ORDERED BY: COLDWELL BANKER FOR SHAWN CALLAHAN & KATHRYN FLORENCE

Ø = Iron Pipe Survey Stake Found
 O = Iron Pipe Survey Stake Set
 (xxx) = Record Dimension

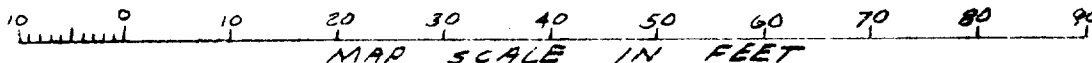

This survey is made for the use of the present owners of the property, and also for those who purchase, mortgage, or guarantee the title thereto within one (1) year from the date hereof.

Robert A. Farris
Robert A. Farris, R.L.S.

Dated this 20~~th~~ day of June, 1986

PROJECT NO. 1697.086

WMA-00001

11-491✓