



# PLAT OF SURVEY OF LOT 21 LOCKWOOD'S SUB. VILLAGE OF WILLIAMS BAY, WALWORTH CO., WIS.

FOR  
MIDWEST REAL ESTATE

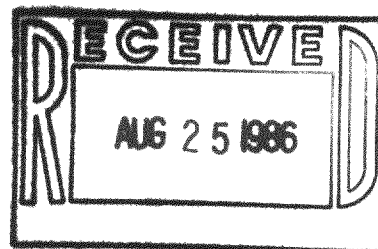

N

LINE A-B  
N 0° 06' W ASSIGNED

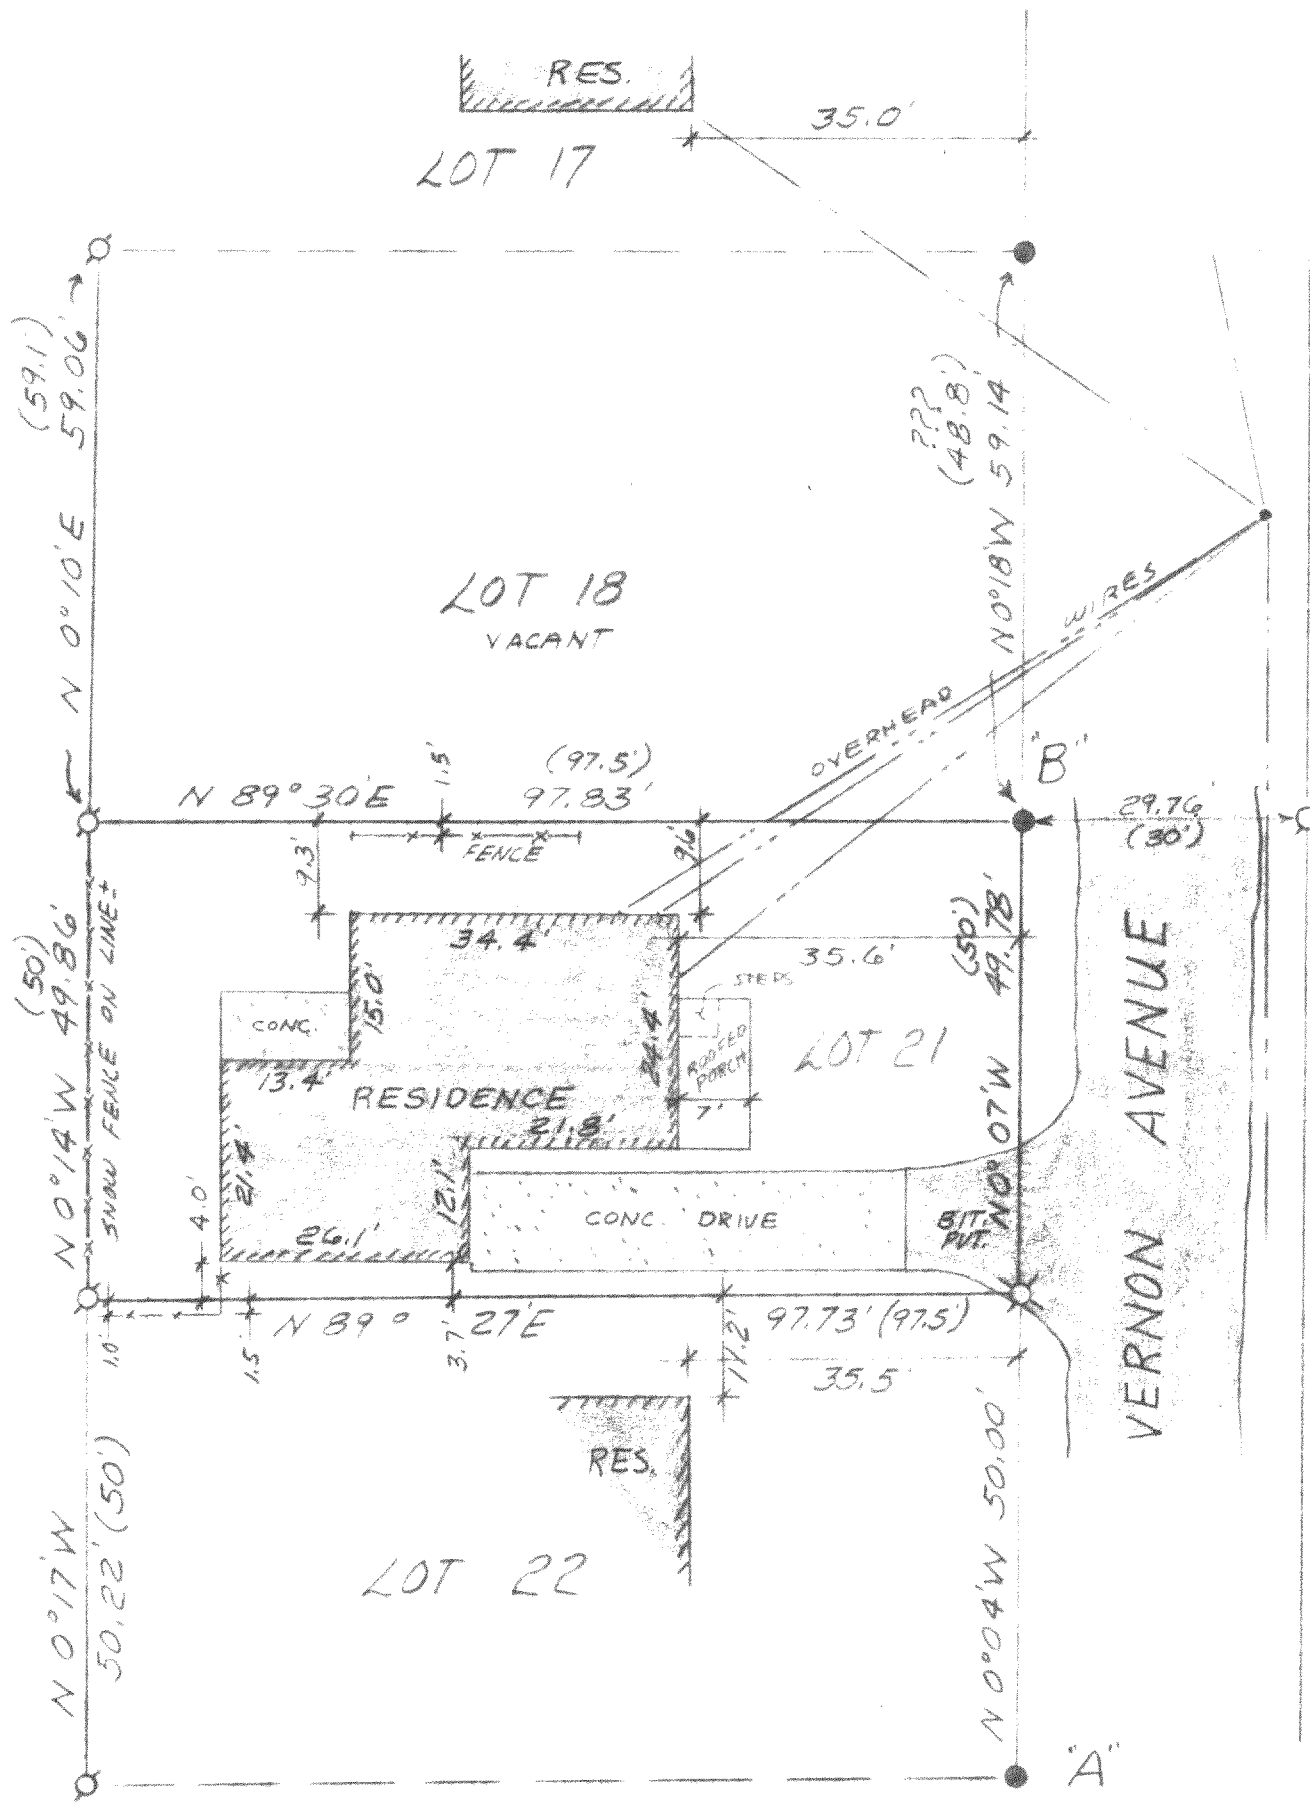


10 0 10 20 30 40 50 60 70 80  
MAP SCALE IN FEET

- = IRON ROD STAKE FOUND
- = IRON PIPE STAKE FOUND
- ⊗ = NAIL SET IN PAVEMENT (METAL DETECTOR INDICATES IRON OBJECT BENEATH PAVEMENT)
- (xxx) = RECORD DIMENSION

I hereby certify that I have surveyed the above described property and that the above map is a true representation thereof and shows the size and location of the property, its exterior boundaries, the location of all visible structures and dimensions of all principal buildings thereon, boundary fences, apparent easements, roadways and visible encroachments, if any.  
This survey is made for the use of the present owners of the property, and also those who purchase, mortgage, or guarantee the title thereto within one (1) year from the date hereof.

*Robert A. Farris*

DATED 08/22/86

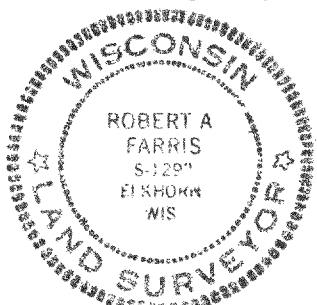

FARRIS, HANSEN & ASSOCIATES, INC.  
7 Ridgeway Court - P.O. Box 487  
Elkhorn, Wisconsin  
414-723-2098

PROJECT NO. 2641