



WALWORTH COUNTY
SURVEYING & MAPPING
LAKE GENEVA, WISCONSIN

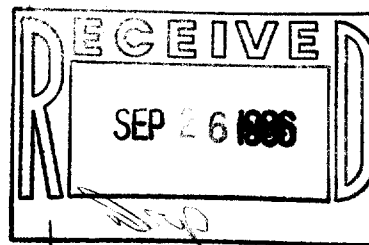

LOWER LOCH VISTA DRIVE

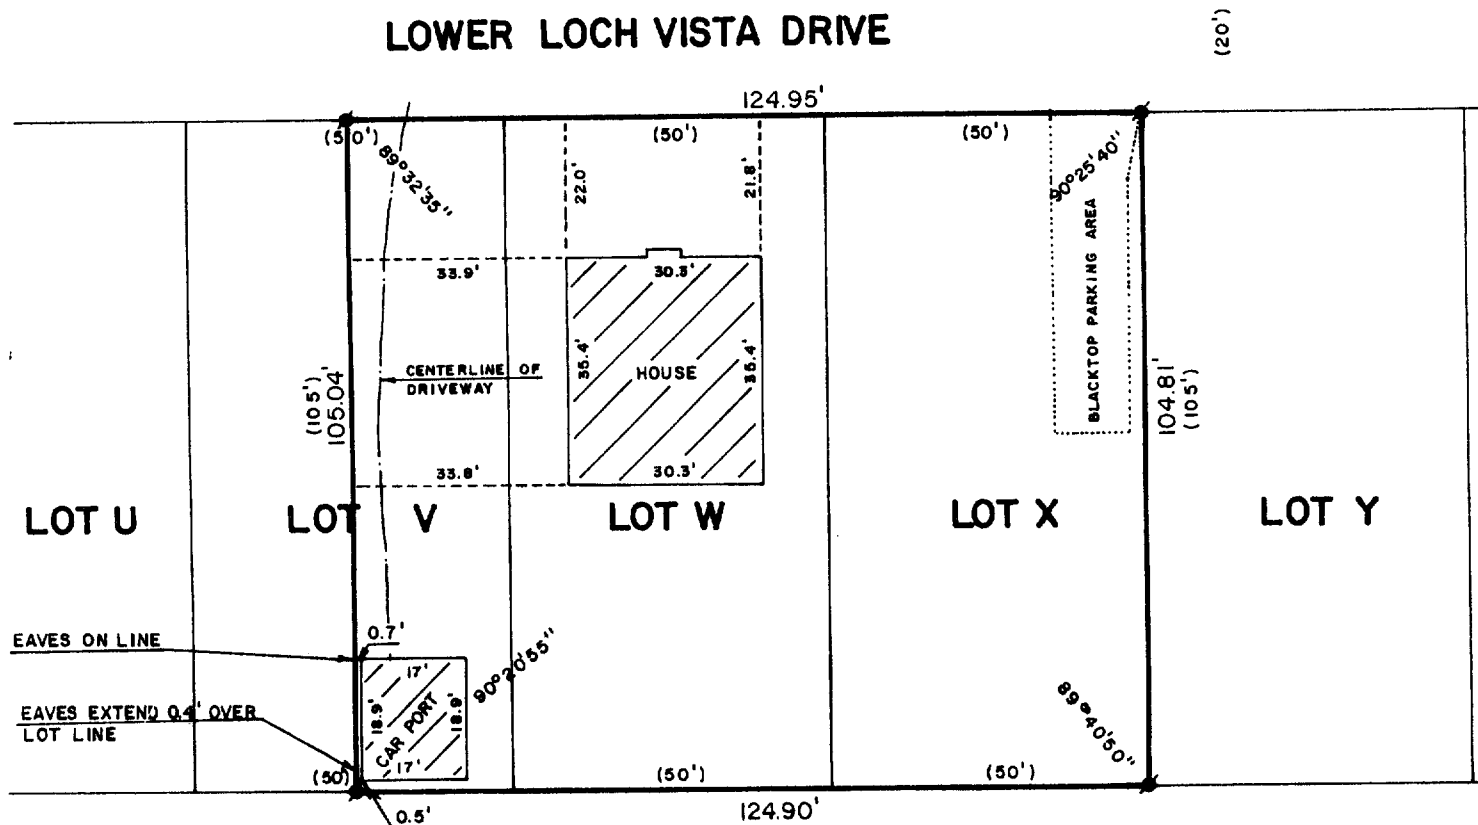

PLAT OF SURVEY OF

THE EAST 1/2 OF LOT "V", ALL OF
LOTS "W" AND "X" OF LOCH VISTA
CLUB SUBDIVISION #2, LOCATED IN
THE VILLAGE OF WILLIAMS BAY,
WALWORTH COUNTY, WISCONSIN.

ORDERED BY: ASSURED REALTY
P. O. BOX 367
WILLIAMS BAY, WISCONSIN



SCALE: 1"=30'

• - CONCRETE MONUMENT FOUND
() - RECORDED AS

I, ROBERT M. BAERENWALD, DO HEREBY CERTIFY THAT I
HAVE SURVEYED THE PROPERTY HEREON DESCRIBED ACCORDING
TO THE OFFICIAL RECORDS AND THAT THE PLAT HEREON IS A
CORRECT REPRESENTATION OF THE PROPERTY LINES TO THE
BEST OF MY KNOWLEDGE AND BELIEF.

Robert M. Baerenwald
ROBERT M. BAERENWALD
WISCONSIN REGISTERED LAND SURVEYOR, S-1508

Sept. 10, 1986
DATE JOB NO. 0678

NOTE: THIS IS NOT A CERTIFIED COPY UNLESS SEALED.