


GARFIELD PARKWAY

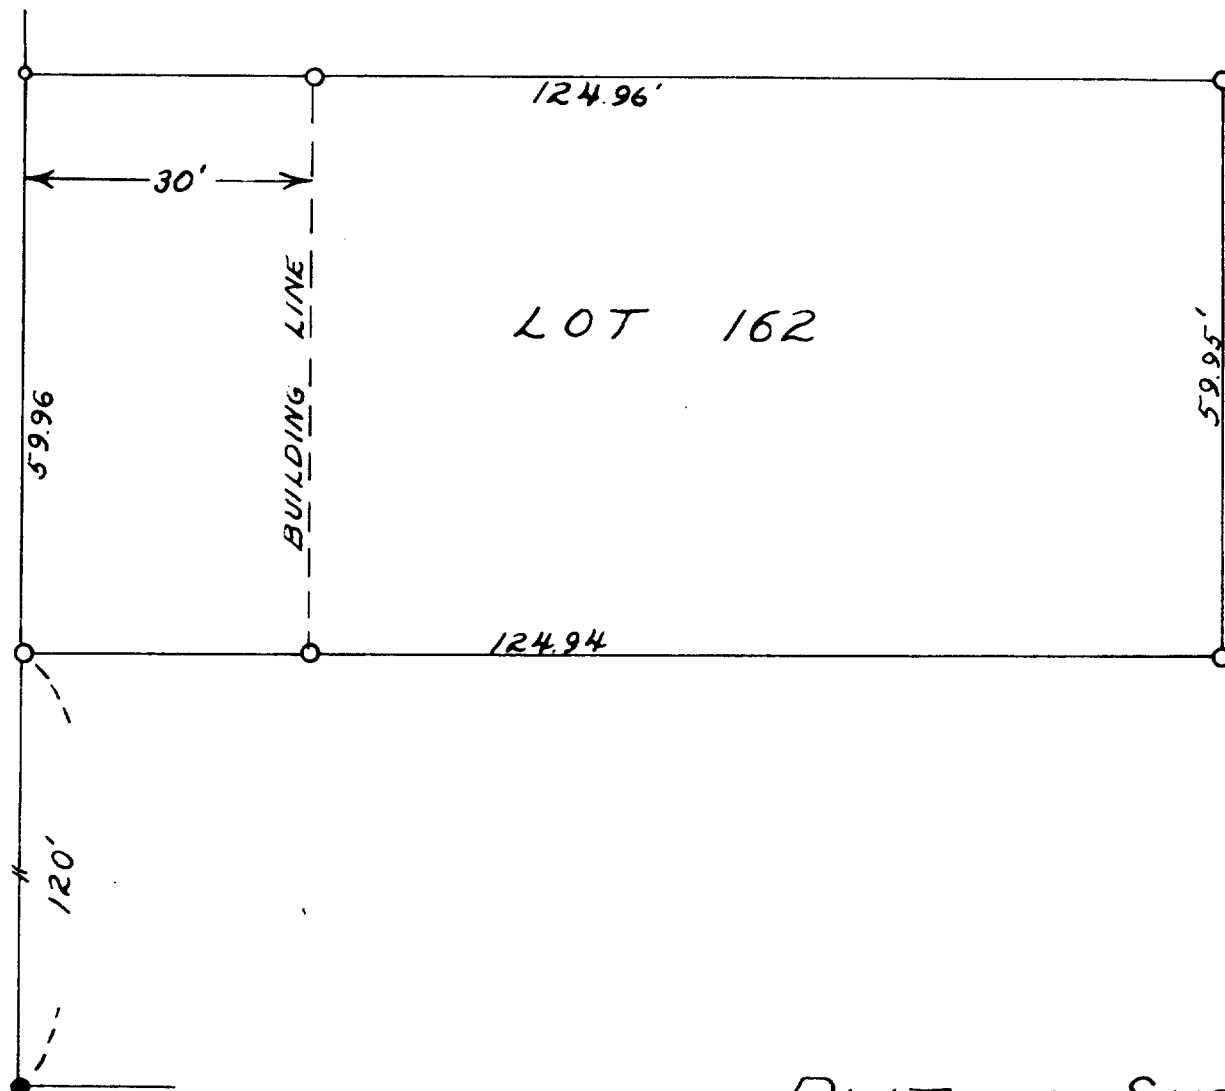

SCALE — 1" = 20'
○ = IRON PIPE
● = CONC. MONU.

PLAT of SURVEY

LOT 162, CEDAR POINT PARK, VILLAGE
OF WILLIAMS BAY, WALWORTH COUNTY,
WISCONSIN.

H. E. Johnson
SURVEYOR

11-50 J