
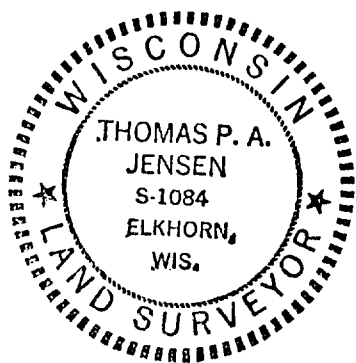


LOT 125 AND PART OF LOT 124, CEDAR POINT
PARK 2ND ADDITION, LOCATED IN THE NE $\frac{1}{4}$
OF SECTION 6, T1N R1E, VILLAGE OF
WILLIAMS BAY, WALWORTH COUNTY, WISCONSIN.

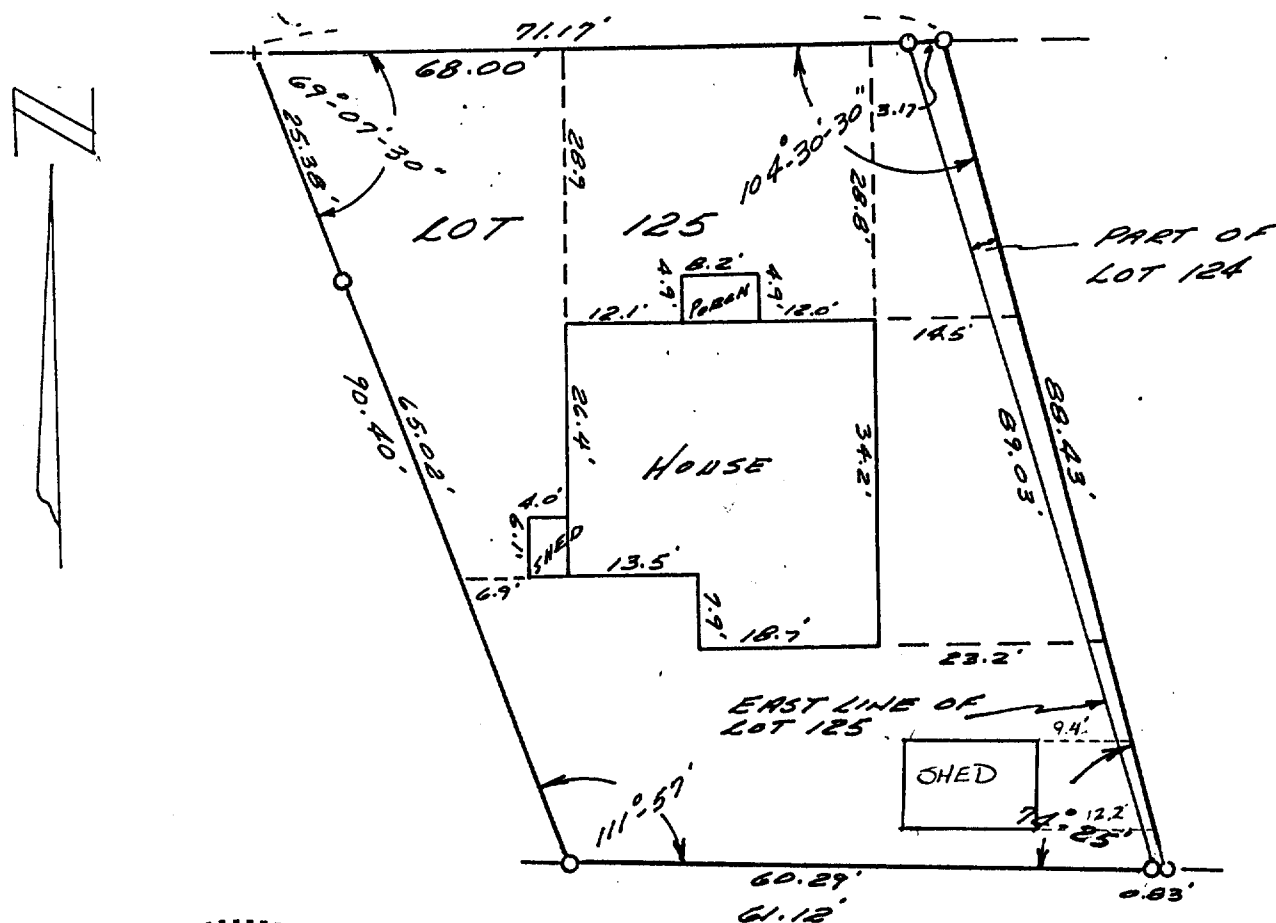

Recertified by: Jensen Surveying & Mapping S.C.
45 S. Wis. P.O. Box 322
Elkhorn, Wisconsin. 53121
June 25, 1986. *[Signature]*

June 25, 1986.


Thomas P.A. Jensen S-1084

SURVEY AND PLAT BY
JENSEN & JOHNSON, INC.
CIVIL ENGINEERS AND SURVEYORS

Elkhorn, Wisconsin

∅ — Iron Pipe SET
 ● — Concrete Monument
 Scale 1" = 20'

0 - IRON PIPE FOUND
+ - CHISEL CROSS CUT FOUND

WE CERTIFY: That we have surveyed the above described property and that the plat shown hereon is an accurate survey and a true representation thereof and correctly shows the exterior boundary lines and all divisions of said property, *AND ALL BUILDINGS THEREON.*

Date JULY 23, 1973

Wisconsin Registered Land Surveyor, No. S-108

1986.052

11-511