
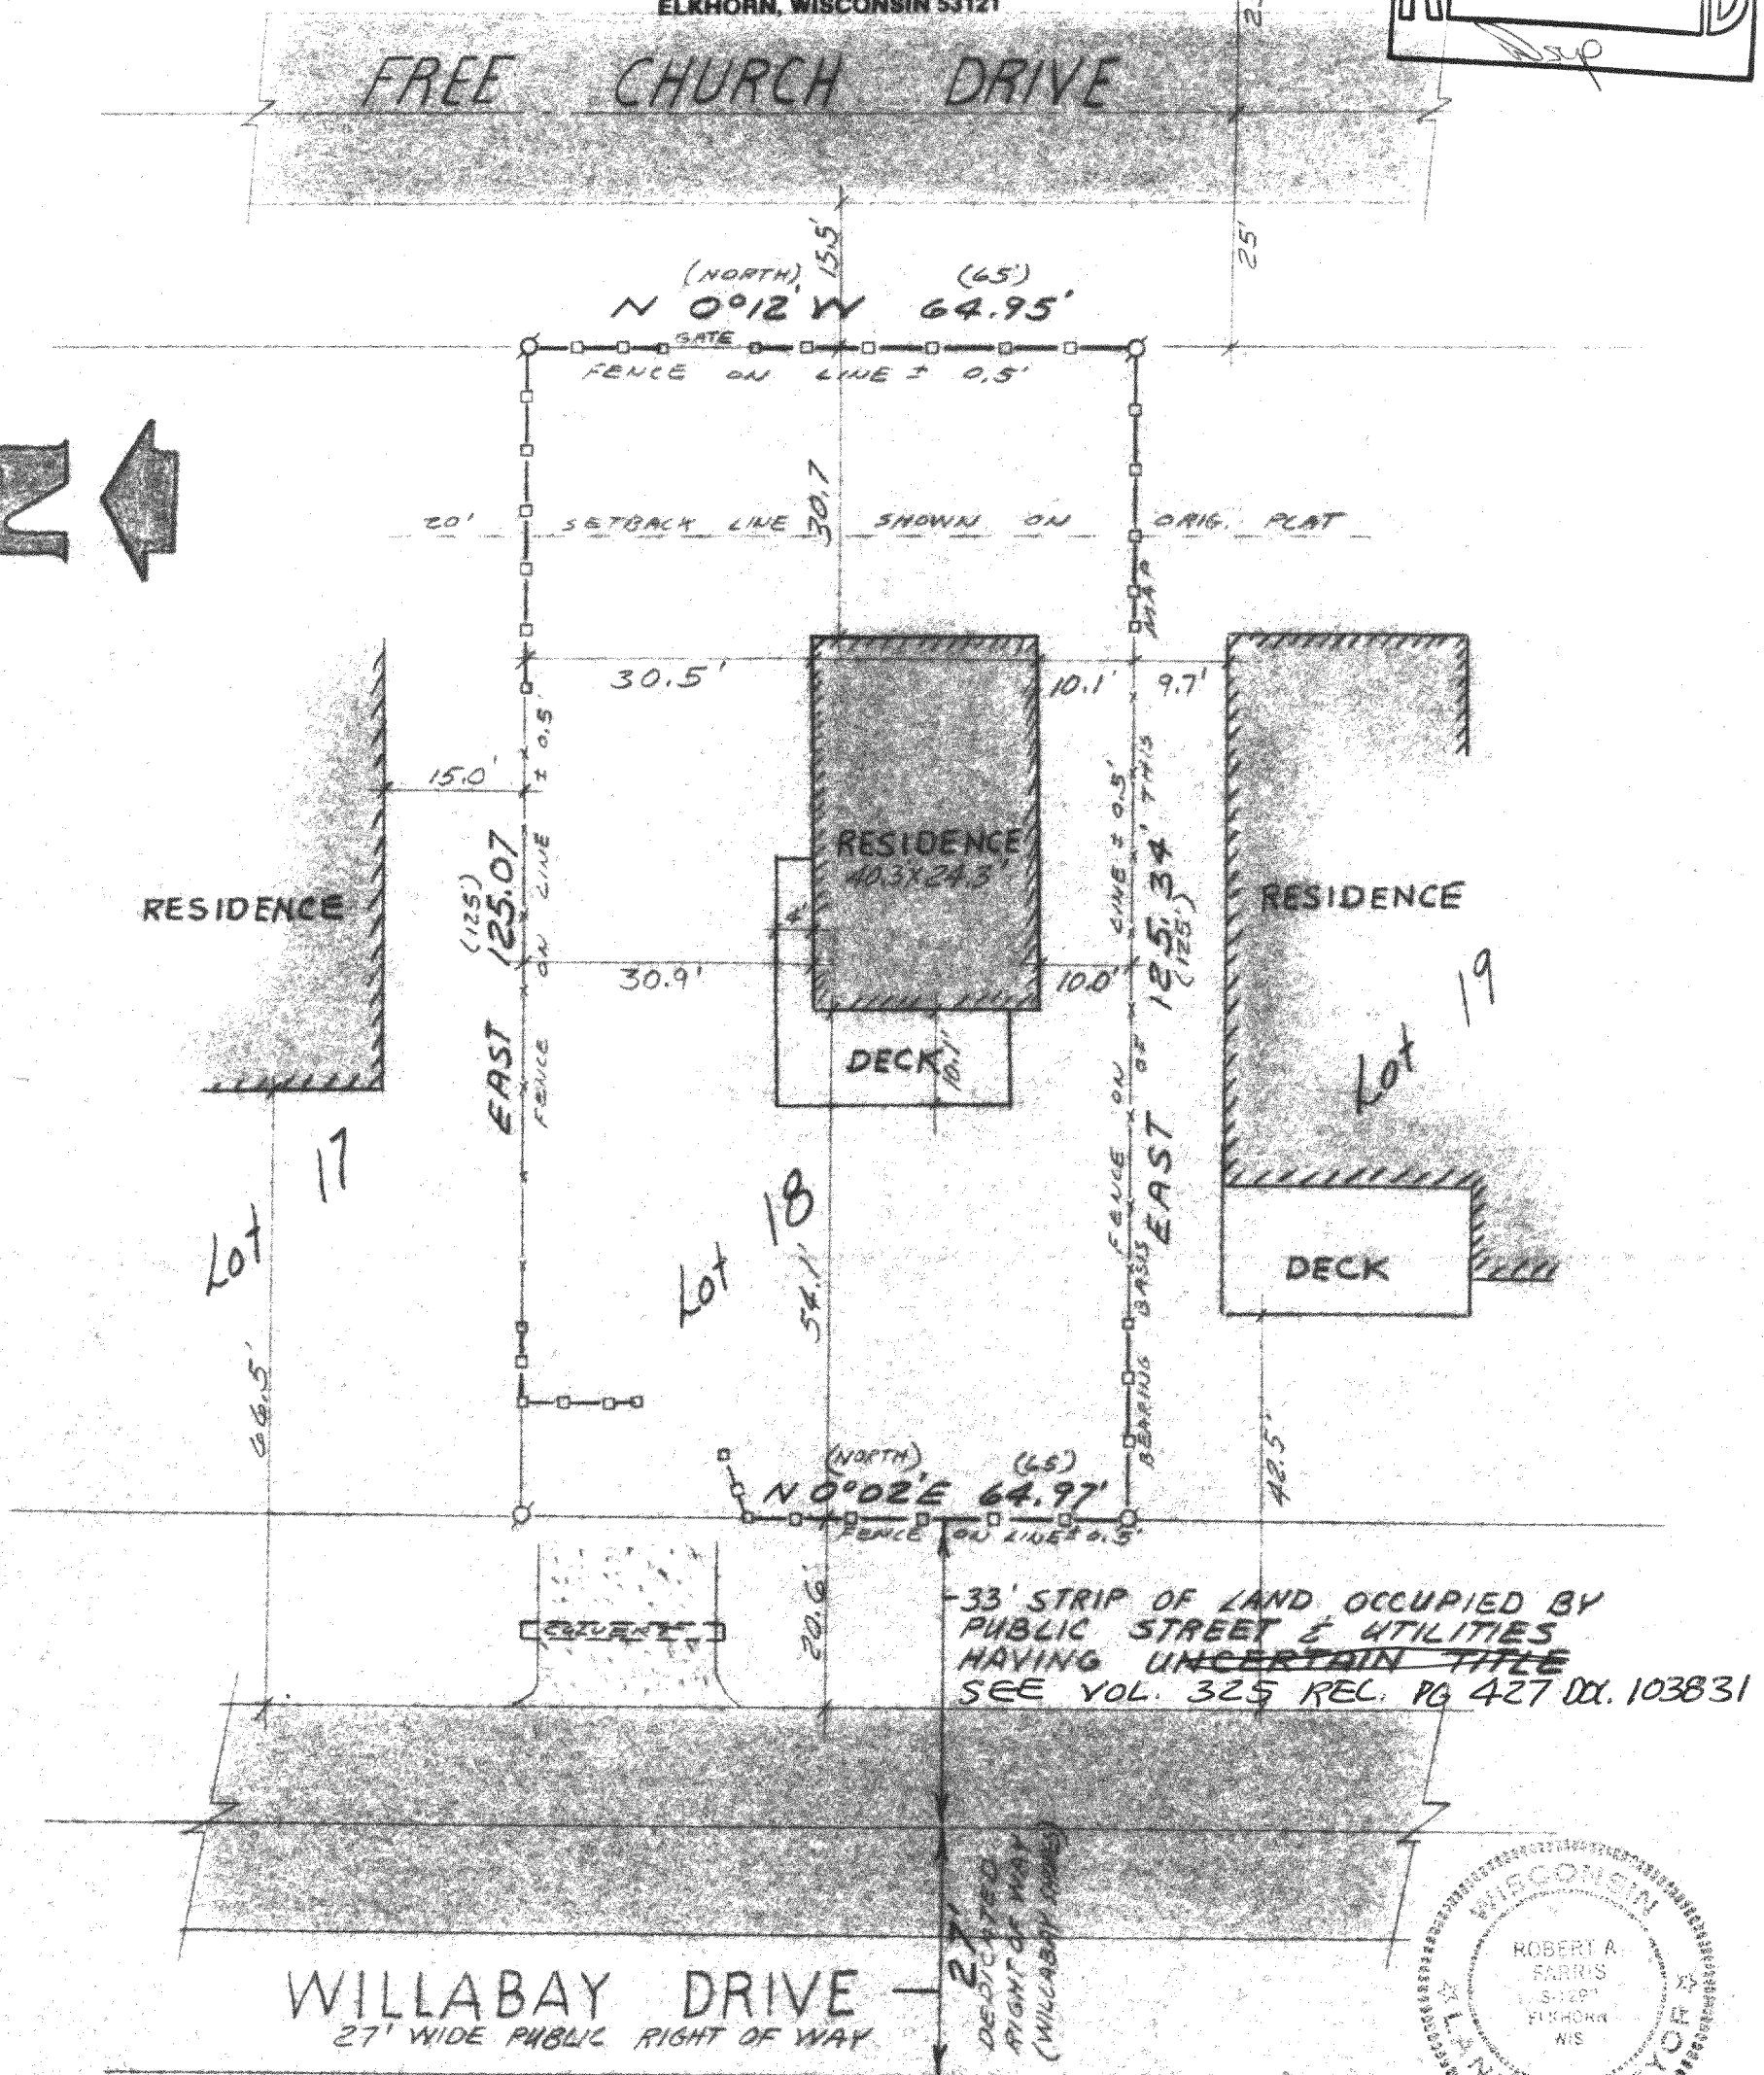
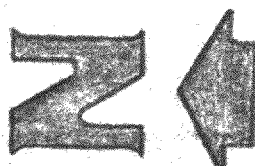


Farris, Hansen & Associates, Inc.

Engineers, Architects and Surveyors
P.O. BOX 487
7 RIDGEWAY COURT
ELKHORN, WISCONSIN 53121

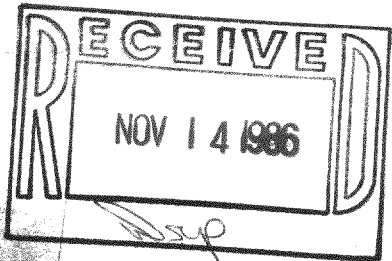

LEGEND

- ⊙ = Iron Pipe Survey Stake Found
- = Iron Pipe Survey Stake Set
- (x x x) = Record Dimension
- = Wood Privacy Fence
- x—x— = Wire Fence

**PLAT OF SURVEY LOT 18 EVANGELICAL
FREE CHURCH SUBDIVISION
WILLIAMS BAY, WI.
WORK ORDERED BY: DEL YEN ZON**

CERTIFICATE

I hereby certify that the above described property has been surveyed under my direction and that the above map is a true representation thereof and shows the size and location of the property, its exterior boundaries, the location of all visible structures and dimensions of all principal buildings thereon, boundary fences, apparent easements, roadways and visible encroachments, if any.
This survey is made for the use of the present owners of the property, and also for those who purchase, mortgage, or guarantee the title thereto within one (1) year from the date hereof.

Robert A. Farris
Robert A. Farris, R.L.S.

Dated this 22nd day of October, 1986

PROJECT NO. 2681