


Plat of Survey of Lots 20, 21, & 22 of Block 1 of
Harbor View Subdivision in NE 1/4 6-1-17 Williams Bay,
Walworth County, Wisconsin

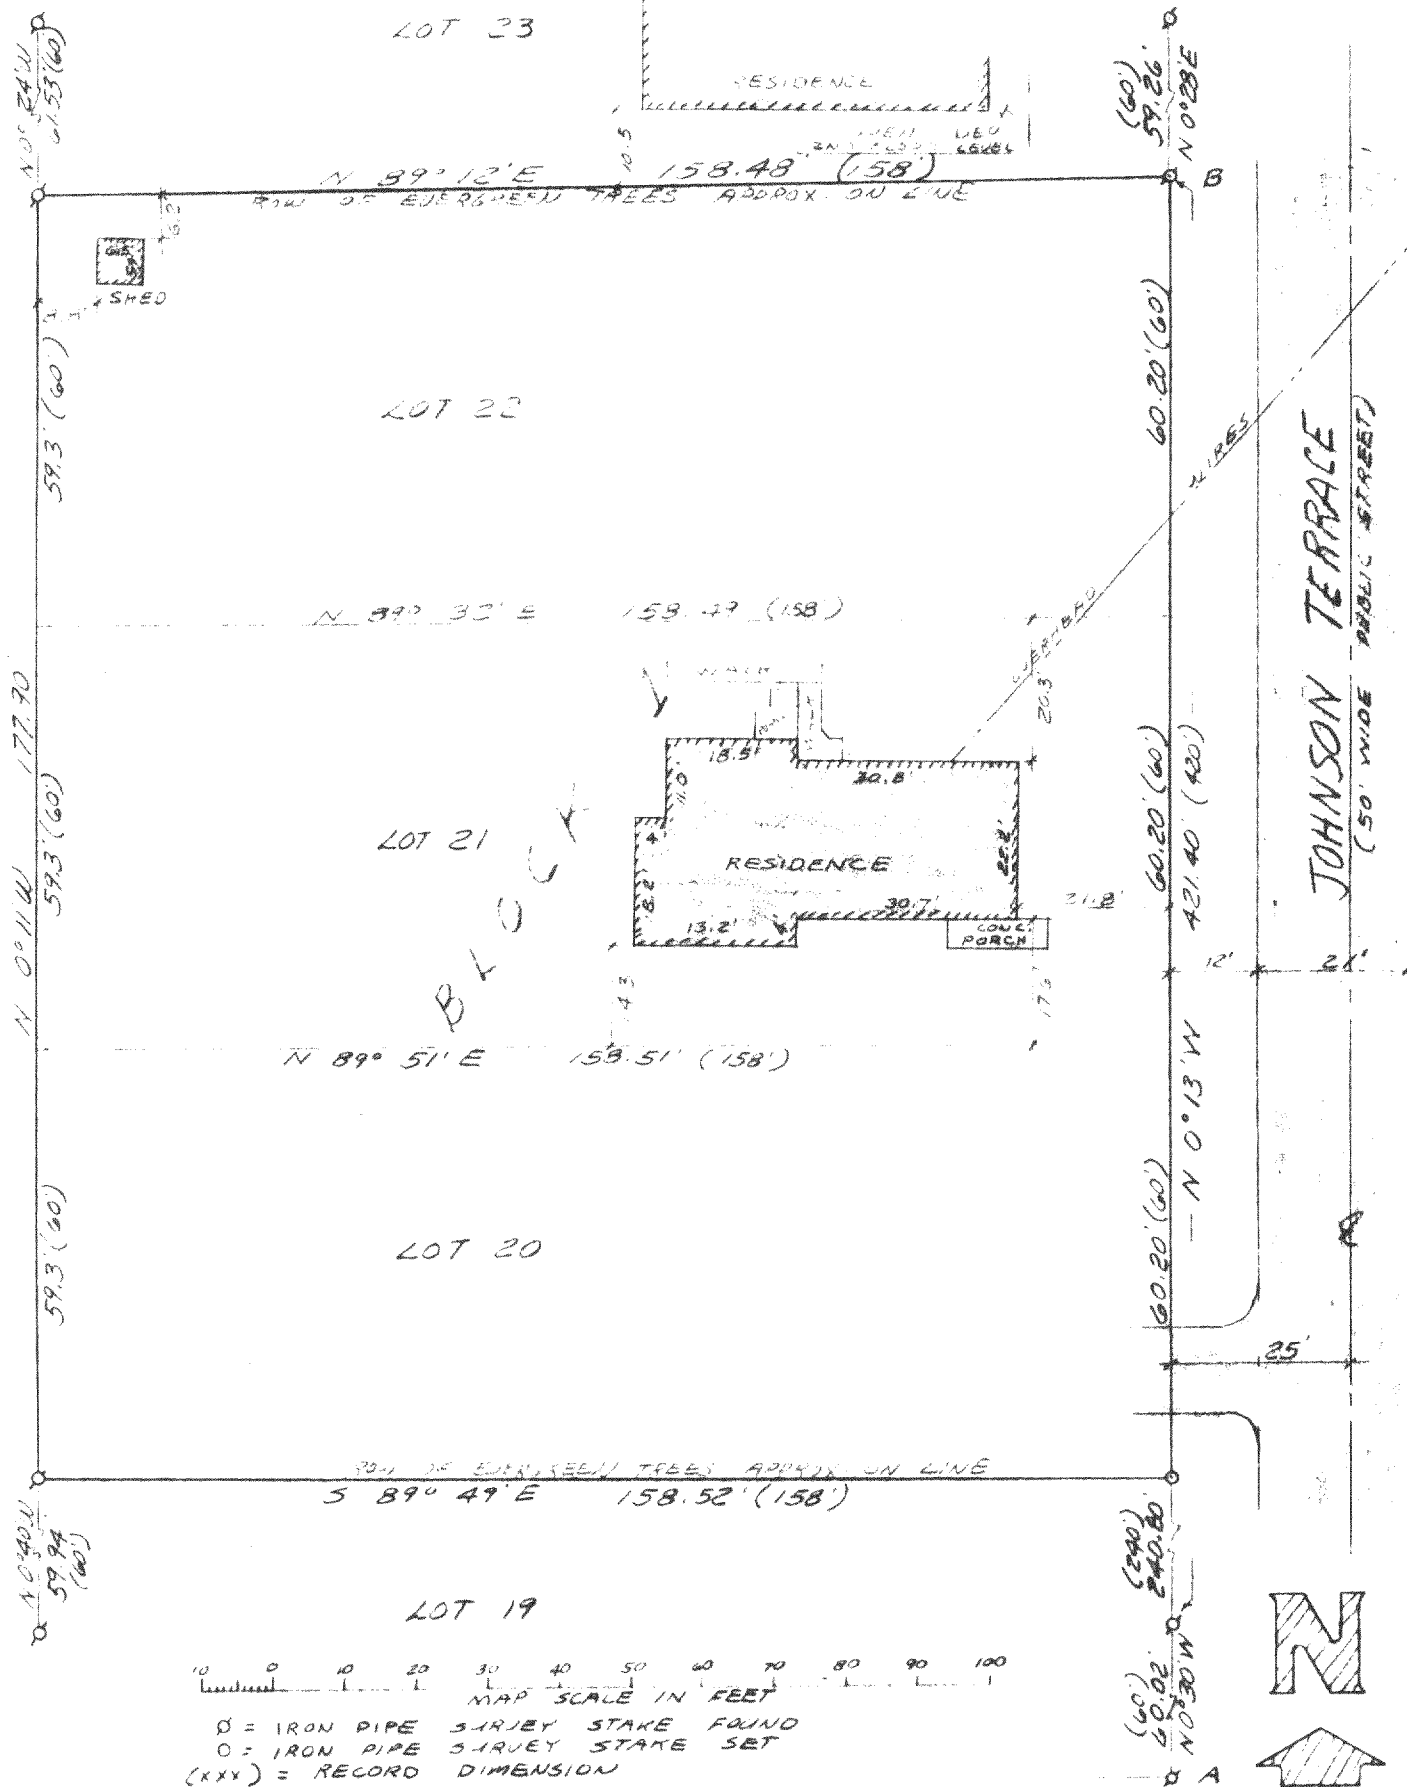

I hereby certify that I have surveyed the above described property and that the above map is a true representation thereof and shows the size and location of the property, its exterior boundaries, the location of all visible structures and dimensions of all principal buildings thereon, boundary fences, apparent easements, roadways and visible encroachments, if any. This survey is made for the use of the present owners of the property, and also those who purchase, mortgage, or guarantee the title thereto within one (1) year from the date hereof.

Robert A. Farris



WORK ORDERED BY
M. J. WEST REALTY

FARRIS, ROBERT & ASSOCIATES, INC.
7 Ridgeway Court - P.O. Box 487
Elkhorn, Wisconsin
414-783-2888

DATED: 08/22/86

PROJECT # 2642

