



PLAT OF SURVEY OF LOT 11 OF BLOCK 13 OF WILLIAMS 2ND. ADD.
VILLAGE OF WILLIAMS BAY, WALWORTH COUNTY, WIS.

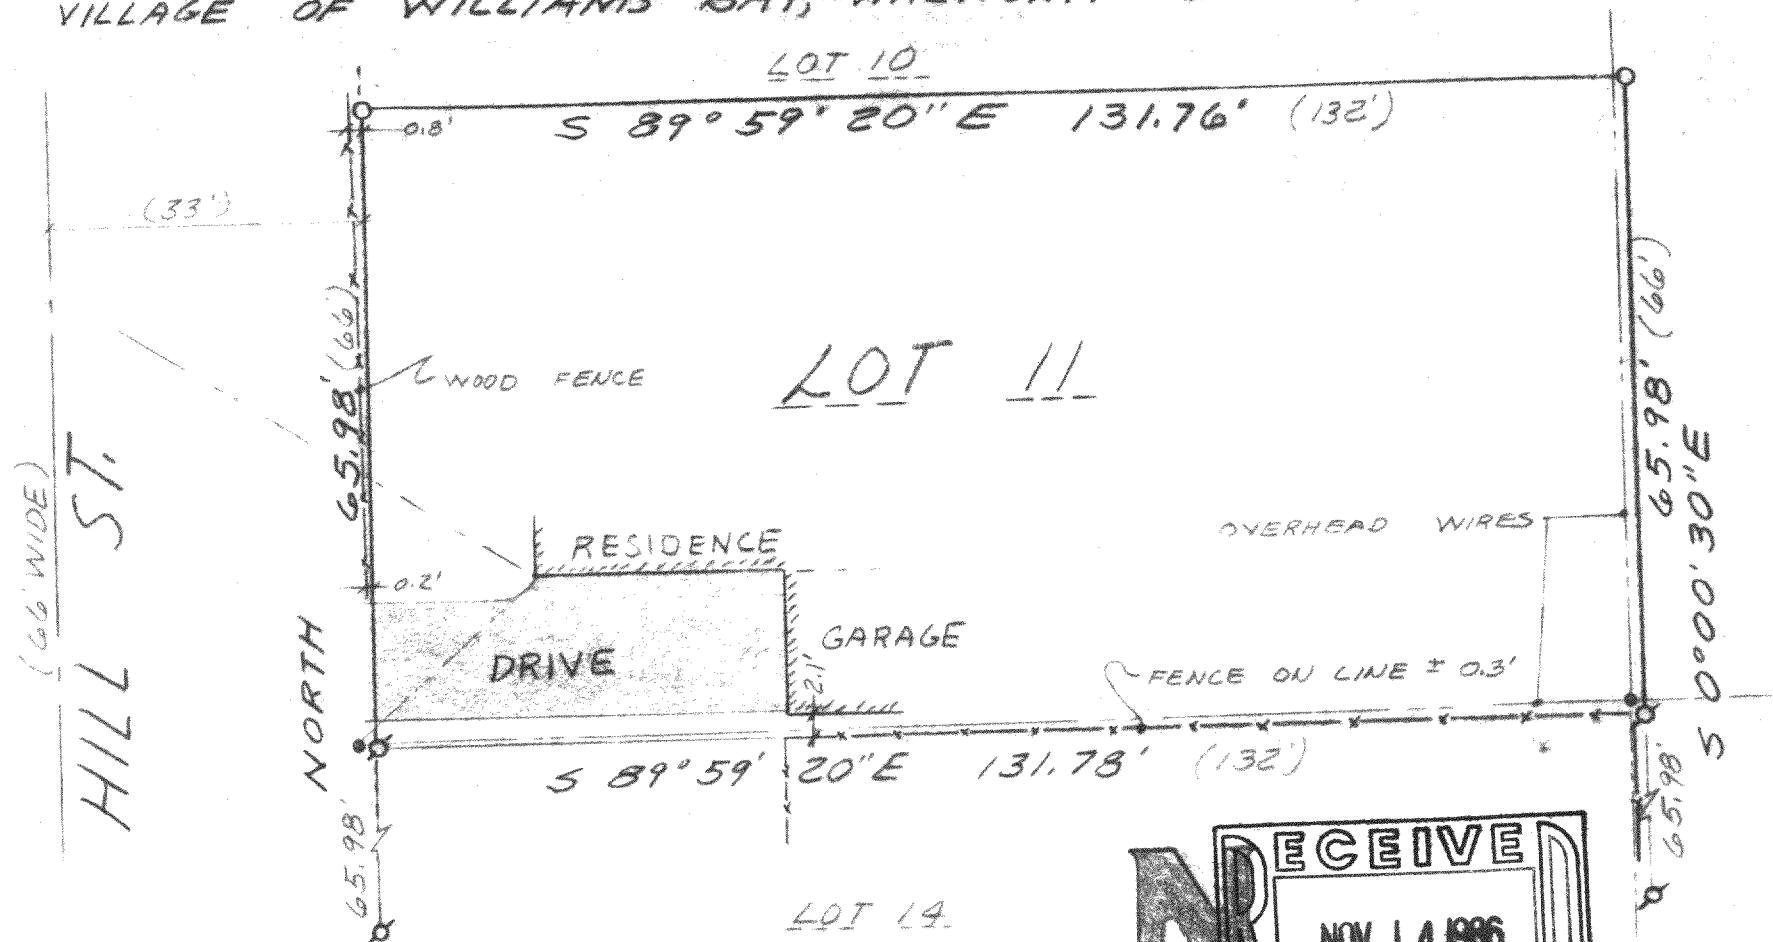

Legend

- Ø = FOUND IRON PIPE STAKE
- = SET 3/4" X 24" IRON REBAR STAKE
- = UTILITY POLE
- (xxx) = RECORD DIMENSION

FARRIS, HANSEN & ASSOCIATES, INC.
7 Ridgeway Ct.
Elkhorn, WI 53121

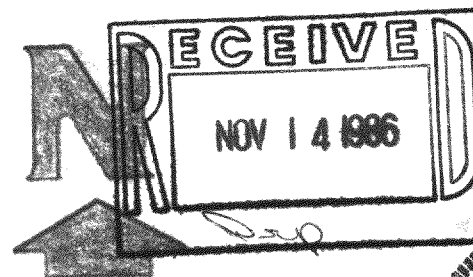

SCALE 1"=20'

WORK ORDERED BY MIDWEST REALTY

I HEREBY CERTIFY THIS PLAT TO BE A TRUE AND ACCURATE
REPRESENTATION OF THE BOUNDARY LINES OF LOT 11 TO
THE BEST OF MY PROFESSIONAL KNOWLEDGE & BELIEF.

Robert A. Farris

DATED NOV 12, 1986

DRAWING NUMBER 2692

