


WALWORTH COUNTY
SURVEYING & MAPPING
LAKE GENEVA, WISCONSIN

CIRCLE PARKWAY

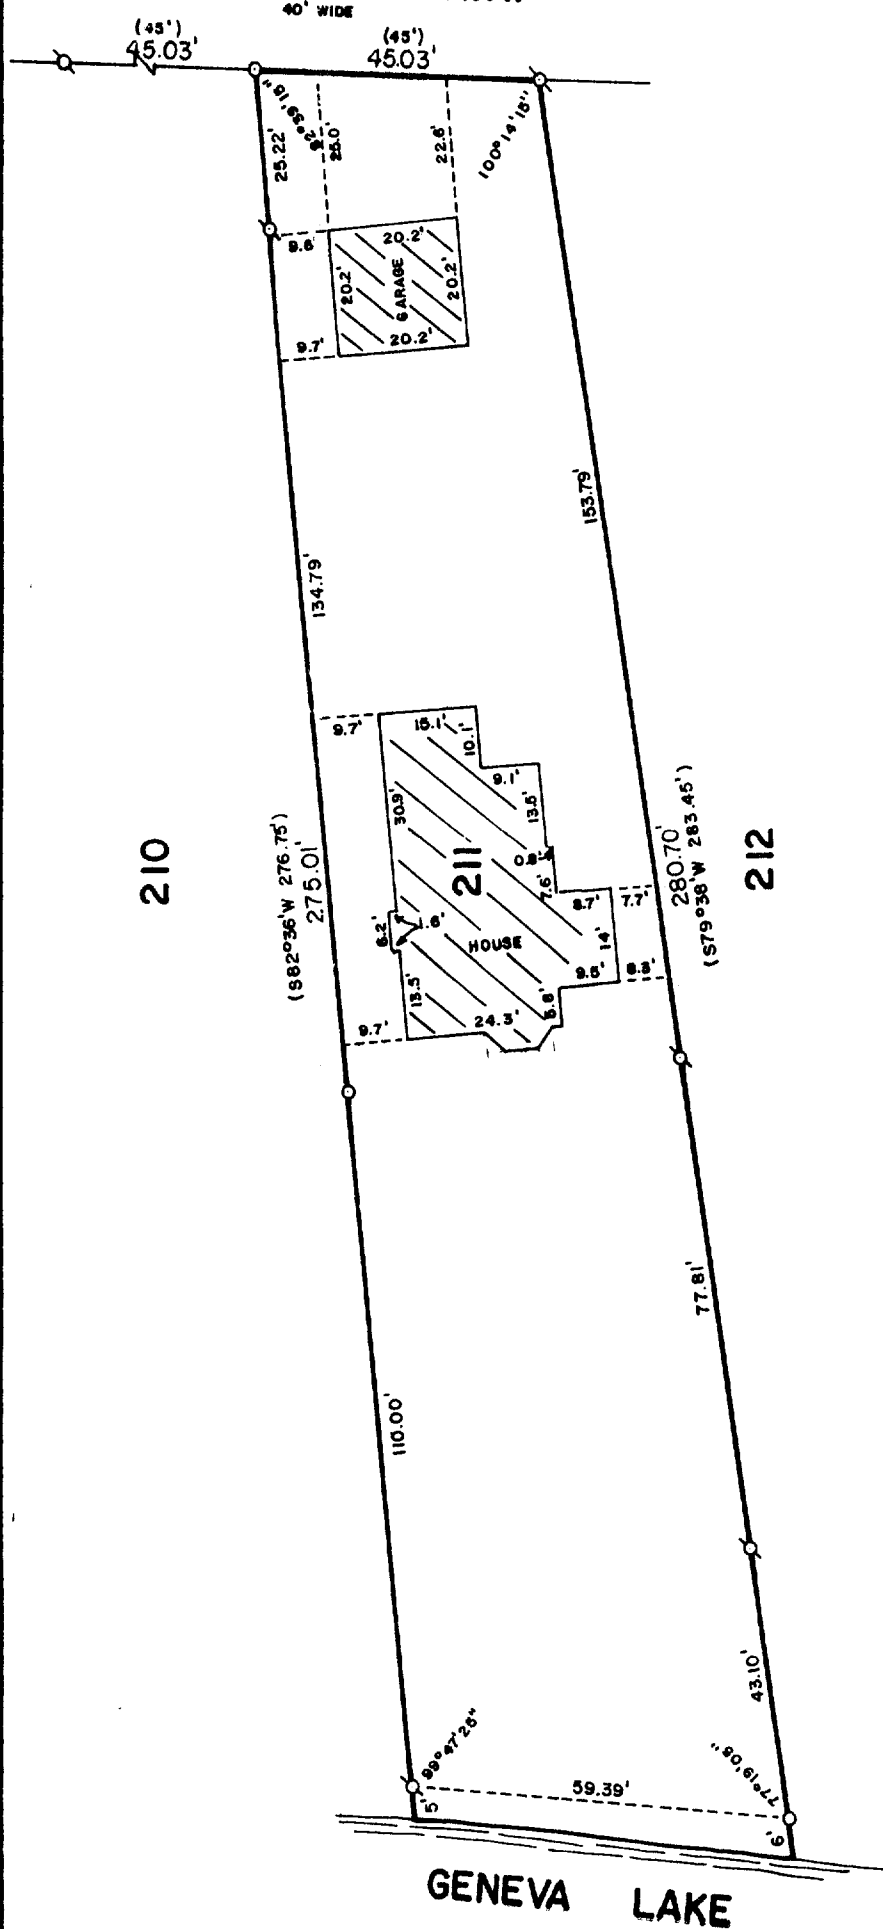


PLAT OF SURVEY OF

LOT 211 OF CEDAR POINT PARK 3RD ADDITION, LOCATED
IN THE VILLAGE OF WILLIAMS BAY, WALWORTH COUNTY,
WISCONSIN.

ORDERED BY: GEORGE SCHILLER
WILLIAMS BAY, WI

NOTE: ALL BUILDING DIMENSIONS ARE
TO THE FACE OF THE SIDING.

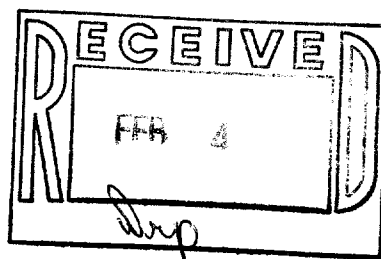

SCALE: 1"=30'

○ - IRON PIPE FOUND
○ - IRON ROD PLACED
() - RECORDED AS

I, ROBERT M. BAERENWALD, DO HEREBY CERTIFY THAT I
HAVE SURVEYED THE PROPERTY HEREON DESCRIBED ACCORDING
TO THE OFFICIAL RECORDS AND THAT THE PLAT HEREON IS A
CORRECT REPRESENTATION OF THE PROPERTY LINES TO THE
BEST OF MY KNOWLEDGE AND BELIEF.

Robert M. Baerenwald
ROBERT M. BAERENWALD
WISCONSIN REGISTERED LAND SURVEYOR, S-1508

Oct. 4, 1986
DATE: *Oct. 4, 1986* JOB NO. 0770

NOTE: THIS IS NOT A CERTIFIED COPY UNLESS SEALED.

WCP3-10

11-5270