
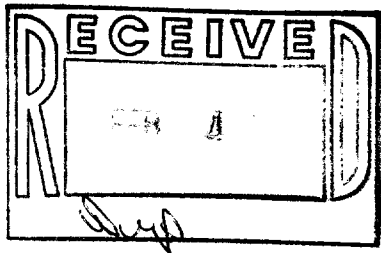


WALWORTH COUNTY
SURVEYING & MAPPING
LAKE GENEVA, WISCONSIN

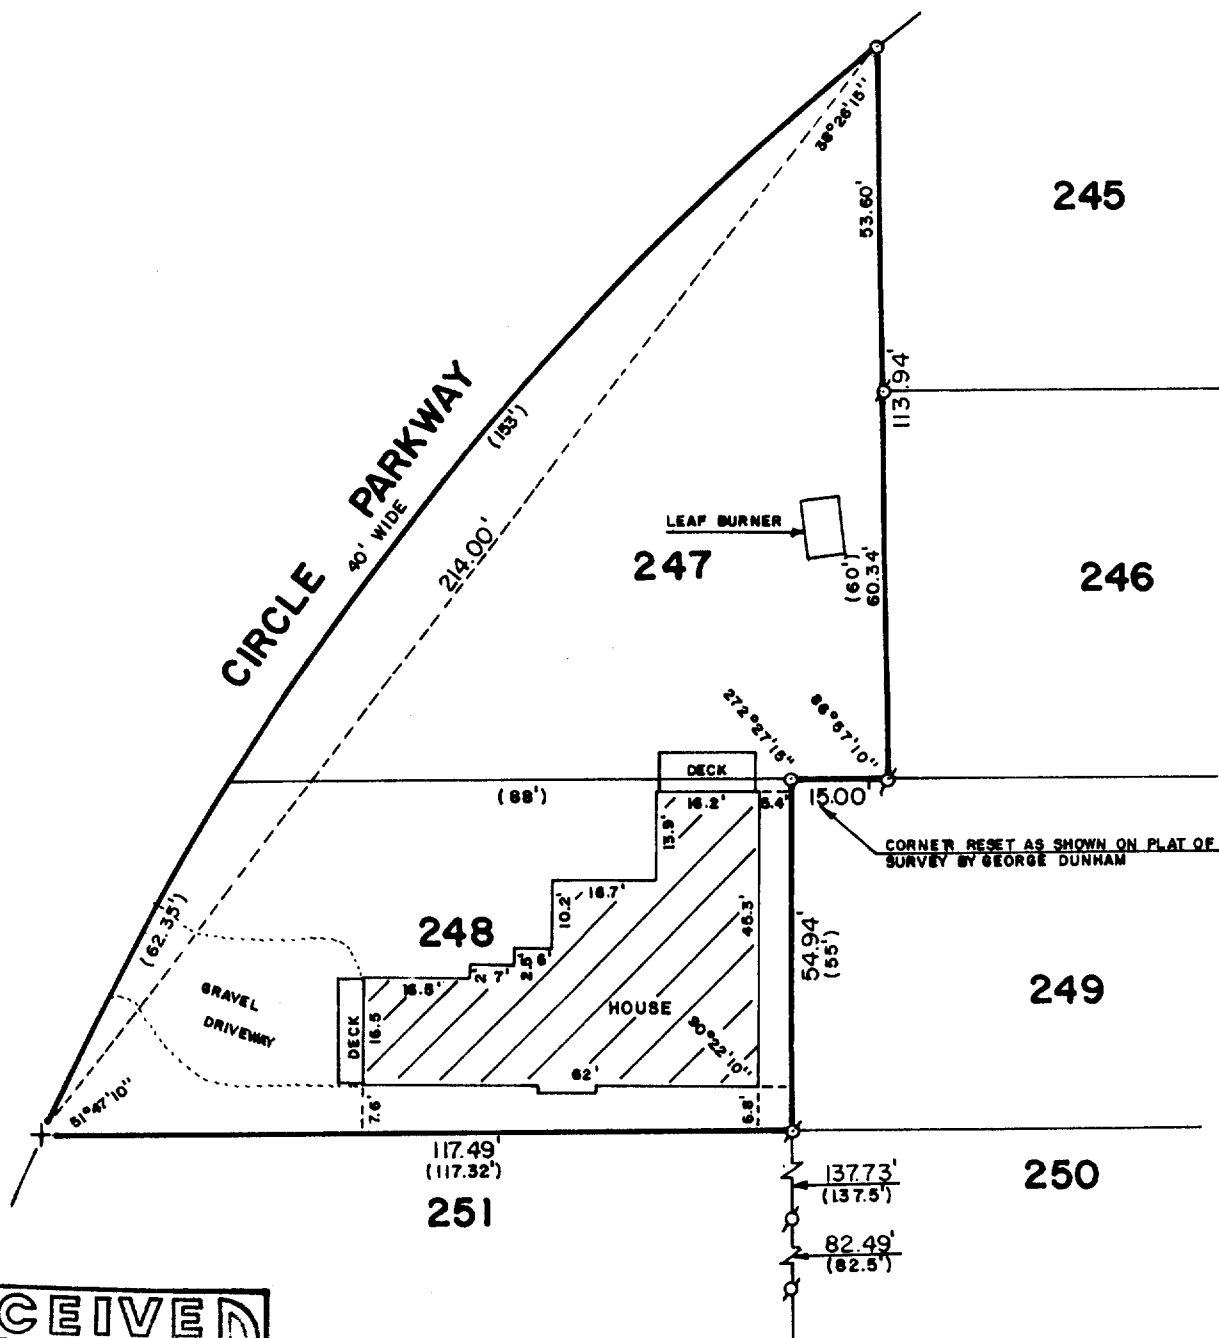

PLAT OF SURVEY OF

LOTS 247 AND 248 OF CEDAR POINT PARK
THIRD ADDITION, LOCATED IN THE VILLAGE
OF WILLIAMS BAY, WALWORTH COUNTY,
WISCONSIN.

ORDERED BY: GENEVA LAKEFRONT REALTY
50 WEST GENEVA STREET
WILLIAMS BAY, WISCONSIN



SCALE: 1"=30'

- o - IRON PIPE FOUND
- o - IRON ROD PLACED
- () - RECORDED AS
- + - CUT CROSS IN CONCRETE

I, ROBERT M. BAERENWALD, DO HEREBY CERTIFY THAT I
HAVE SURVEYED THE PROPERTY HEREON DESCRIBED ACCORDING
TO THE OFFICIAL RECORDS AND THAT THE PLAT HEREON IS A
CORRECT REPRESENTATION OF THE PROPERTY LINES TO THE
BEST OF MY KNOWLEDGE AND BELIEF.

Robert M. Baerenwald
ROBERT M. BAERENWALD
WISCONSIN REGISTERED LAND SURVEYOR, S-1508

Oct. 24, 1986
DATE JOB NO. 0753

NOTE: THIS IS NOT A CERTIFIED COPY UNLESS SEALED.
REVISED: OCT. 29, 1986